

⁹⁶⁻
NASA/CR-203907
A

7N-31-CR

044 117

**Galileo-NMS
Field Services**

NAS5-29344

Final Report


July 3, 1996

**George R. Carignan
Space Physics Research Laboratory
University of Michigan
2455 Hayward St.
Ann Arbor MI 48109-2143**

BIT	WORD 0 SHIFT REGISTER	WORD 1 (CORE MEMORY)	WORD 2 (CORE MEMORY)	WORD 3 CORE MEMORY
0	ADDRESS 0	ADDRESS 0	ADDRESS 1	ADDRESS 1
1	ADDRESS 0	ADDRESS 1	ADDRESS 0	ADDRESS 1
2	NOT AVAILABLE	LF AC GAIN MSB	AC OFFSET MSB	CAL VALVE DISABLE
3	NOT AVAILABLE	LF AC GAIN	AC OFFSET LSB	SELECT FIL 2
4	VALVE DISABLE	LF AC GAIN LSB	DC OFFSET MSB	HV MSB
5	HEATER DISABLE	DC GAIN MSB	DC OFFSET LSB	HV LSB
6	FILAMENT OFF	DC GAIN	HF AC GAIN MSB	DISCRIMINATOR MSB
7	COMMUTATOR STOP	DC GAIN LSB	HF AC GAIN LSB	DISCRIMINATOR LSB

- A COMMAND ENVELOPE RESETS THE SEQUENCE INITIATION LATCH, ENABLING A SUBSEQUENT SEQUENCE INIT COMMAND TO RESET THE PROGRAM COUNTER TO ZERO POSITION.
- WORDS MAY BE ENTERED IN ANY SEQUENCE, ANY NUMBER OF TIMES.
- THE ENTIRE WORD MUST BE ENTERED, I.E. INDIVIDUAL BITS OF A WORD MAY NOT BE CONFIGURED.

NOTE: REV 5/17/82 REVERSED ORDER OF WORDS I.E. BIT 2 NA WORD, WAS BIT 2 NA WORD 3 3N/WR

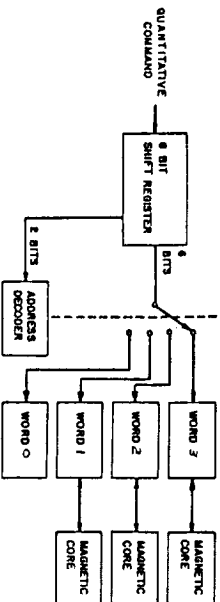



- 18 COMMAND BITS STORED IN MAGNETIC CORE MEMORY.
- 4 BITS STORED IN VOLATILE MEMORY.
- MAGNETIC MEMORY READ INTO STORAGE REGISTERS AND REWRITTEN AT EACH POWER ON.
- MAGNETIC CORE FULLY REWRITTEN AFTER EACH COMMAND WORD.

SEE ALSO: 8-E4717 (COMMAND SYSTEM CONCEPT)

ENGINEER J. MAUER	DRAFTSMAN JH	3/29/81	
SPACE PHYSICS RESEARCH LABORATORY	QUANTITATIVE COMMANDS	GNMS	6/23/82
COLLEGE OF ENGINEERING			6/9/82
UNIVERSITY OF MICHIGAN			5/17/82
ANN ARBOR, MICHIGAN	B-E6692		DATE

LAST USED R C D L

COMMAND MEMORY WIRING DIAGRAM

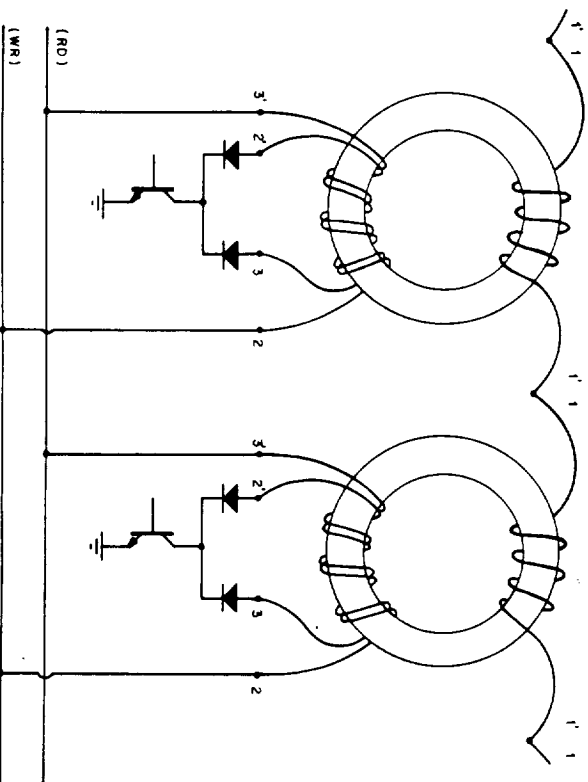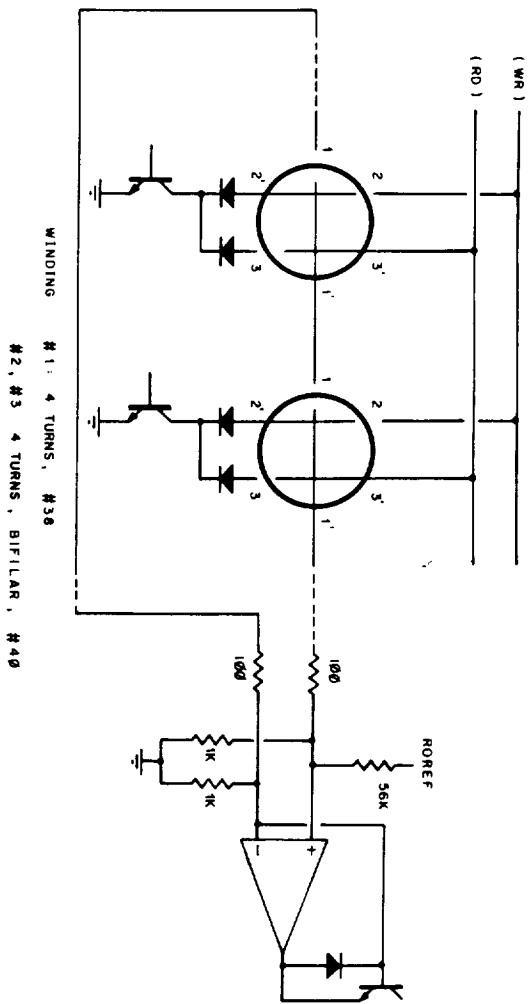

CONTROLLED
APR 16 1984
PRINT

ENGINEER W. PINKUS	3/22/80	DRAFTSMAN KS/B.T.	4/4/79
SPACE PHYSICS RESEARCH LABORATORY		COMMAND MEMORY	
COLLEGE OF ENGINEERING		CORE WIRING DIAGRAM	
UNIVERSITY OF MICHIGAN		GALILEO-NMS	
ANN ARBOR, MICHIGAN		B-E 5196	CONTROLLED
			DATE

5/26/83 REV6 - ADD 22 PIN ELECTRODE PLUGS & PRO 29 J M	ENGINEER J MAUNER / E PLENO	DRAFTSMAN
SPACE PHYSICS RESEARCH LABORATORY		HARNESSTEDT
COLLEGE OF ENGINEERING		GNMS
UNIVERSITY OF MICHIGAN		
ANN ARBOR, MICHIGAN		
LAST USED R C D L		B-E 6

FG	8/12/80
SCHEMATIC	REV. 6
OC	
DEC 22 1983	

B-E 6150C

DEC 22 1983

2.1

MS 37P 20-Mar-81
 PN SIGNAL COLOR LINK TO
 ED *3-21-81
 1 +PWR 22RED S/C1: A
 2 -PWR 22BRN S/C1: W
 3 PWR ON PUR S/C1: C
 4 PWR OFF W/BLK S/C1: D
 5 CMNDENV GRN S/C1: E
 6 CMNDCLK WHT S/C1: F
 7 CMNDCLK GRN S/C1: H
 8 SHLDGND 1 22BLK S/C1: J
 9 MNRFRM1 GRN S/C1: K
 10 MNRFRM2 PUR S/C1: L
 11 32768HZ1 BLU S/C1: M
 12 32768HZ2 WHT S/C1: N
 13 SEQINIT W/BLK S/C1: P
 14 DATAENV1 BLU S/C1: R
 15 DATAENV2 PUR S/C1: S
 16 DATAOUT WHT S/C1: T
 17 SHLDGND 2 24BLK S/C1: U
 18 GSE RY MON PUR S/C2: J
 19 +PW 22RED S/C1: B
 20 -PW 22BRN S/C1: X
 21 PYRO PW A 24RED S/C1: Y
 22 PYRO GND A 24BRN S/C1: a
 23 PYRO PW B 24RED S/C1: z
 24 PYRO GND B 24BRN S/C1: b
 25 PUMP ON W/BLK S/C1: c
 26 PUMP OFF PUR S/C1: d
 27 ON MON WHT S/C1: e
 28 DATACLK1 GRN S/C1: f
 29 DATACLK2 WHT S/C1: h
 30 CASE GND 24BLK S/C2: P
 31 SIG GND 24BLK S/C2: A
 32 PUMP MON WHT S/C2: B
 33 GSEENABL1- PUR S/C2: D
 34 GSE DATA PUR S/C2: F
 35 GSE ANAMUX GRN S/C2: H
 36 GSEENABL2- PUR S/C2: E
 37 +GSE PWR 22RED S/C2: R

S/C1 29 S 20-Mar-81
 PN SIGNAL COLOR LINK TO
 ED *3-21-81
 1 +PWR 22RED MS : 1
 2 -PWR 22BRN MS : 19
 3 PWR ON PUR MS : 3
 4 PWR OFF W/BLK MS : 4
 5 CMNDENV GRN MS : 5
 6 CMNDCLK WHT MS : 6
 7 CMNDCLK GRN MS : 7
 8 SHLDGND 1 22BLK MS : 8
 9 MNRFRM1 GRN MS : 9
 10 MNRFRM2 PUR MS : 10
 11 32768HZ1 BLU MS : 11
 12 32768HZ2 WHT MS : 12
 13 SEQINIT W/BLK MS : 13
 14 DATAENV1 BLU MS : 14
 15 DATAENV2 PUR MS : 15
 16 DATAOUT WHT MS : 16
 17 SHLDGND 2 24BLK MS : 17
 V * NOT USED
 W -PWR 22BRN MS : 2
 X -PW 22BRN MS : 20
 Y PYRO PW A 24RED MS : 21
 Z PYRO PW B 24RED MS : 23
 a PYRO GND A 24BRN MS : 22
 b PYRO GND B 24BRN MS : 24
 c PUMP ON W/BLK MS : 25
 d PUMP OFF PUR MS : 26
 e ON MON WHT MS : 27
 f DATACLK1 GRN MS : 28
 h DATACLK2 WHT MS : 29

S/C2 14 S 20-Mar-81
 PN SIGNAL COLOR LINK TO
 ED *3-21-81
 A SIG GND 24BLK MS : 31
 B PUMP MON WHT MS : 32
 C *
 D GSEENABL1- PUR MS : 33
 E GSEENABL2- PUR MS : 36
 F GSE DATA PUR MS : 34
 H GSE ANAMUX GRN MS : 35
 J GSE RY MON PUR MS : 18
 K *
 L *
 M *
 N *
 P CASE GND 24BLK MS : 30
 R +GSE PWR 22RED MS : 37

ENGINEER	J MAUER	DRAFTSMAN	3/23/81
SPACE PHYSICS RESEARCH LABORATORY		SPACECRAFT	
COLLEGE OF ENGINEERING		HARNESS	
UNIVERSITY OF MICHIGAN		GNMS	
ANN ARBOR, MICHIGAN		B-E6472	
		DATE	

LAST USED R C D L

LCG1	29 S	22-Jun-82	LCG2	29 S	02-Jun-83	LCG3	29 S	22-Jun-82	LCG4	29 S	15-Mar-83
PN SIGNAL			PN SIGNAL			PN SIGNAL			PN SIGNAL		
ED *3-9-81			ED *6-10-83			ED *11-25-81			ED *11-8-82		
A +15R LCG1	ORC	PUR1:NM	A LSO	BLU	RF : U	A SOURCE THP	GRY	ELECT: P	A +15R LCG4	ORC	PUR1:NN
B +10R LCG1	ORC	PUR2:E	B LSI	PUR	RF : V	B PV MON	WHT	PA : F	B +18 CORE	ORC	PUR1:N
C +10L LCG1	ORC	PUR2: A	C LS2	GRY	RF : X	C MULTANA	WHT	PA : F	C +10L LCG4	ORC	PUR2: B
D +10B LCG1	ORC	PUR1:AA	D LS3	BLU	RF : Y	D PUMP MON 2	WHT	FIL : A	D *		
E +5 LCG1	ORC	PUR2: U	E LS4	PUR	RF : Z	E REP MON	PUR	FIL : R	E +10B LCG4	ORC	PUR2: J
F GND LCG1	BLK	PUR1:FF	F LS5	GRY	RF : AA	F ACC MON	WHT	FIL : B	F *		
H -5 LCG1	YEL	PUR1:FF	H LS6	GRY	RF : AA	H EMIS 1 MON	WHT	FIL : R	H #		
J ANAGND LGC	BLK	PUR2: S	J LS7	W/BLK	RF : BB	J EMIS 2 MON	W/BLK	FIL : U	H# GND LCG4	BLK	PUR2: V
K -15R LCG1	YEL	PUR2: Z	K LS8	BLU	RF : CC	K FIL 1 MON	GRN	FIL : b	J +5 LCG4	ORC	PUR1:BB
L -10R LCG1	YEL	PUR2: Y	L LS9	PUR	RF : DD	L FIL 2 MON	WHT	FIL : e	K# LCGGND SC	223LK	S/C2: A
M DATAENV1	BLU	S/C1: R	M LS10	GRY	RF : EE	M HV MON	BLU	BIAS: R	L -15R LCG4	YEL	PUR2:AA
N DATAENV2	PUR	S/C1: S	N LS11	GRN	RF : FF	N OSC THP	W/BLK	RF : D	M CHNDENV	PLX	S/C1: E
P DATAENV3	GRN	S/C1: f	P DCSTR	BLU	RF : HH	P CELL 1 THP	GRY	IN : PP	N CHNDCLK	GR2	S/C1: F
R DATAENV4	WHT	S/C1: h	R T3 CNT	GRN	BIAS: H	R CELL 2 THP	W/BLK	IN : SS	P CHNDCLK	GR2	S/C1: H
S DATAOUT	BLU	S/C1: T	S T3 CNT	GRY	BIAS: J	S LEAK 1 THP	GRY	IN : SS	R SEQUENT	W/3LK	S/C1: P
T GSE DATA	GRY	S/C2: F	T BS LENS V	W/BLK	ELECT: N	T LEAK 2 THP	W/BLK	IN : TT	S MRFPM1	GR3	S/C1: K
U LD0A	GRN	IN : M	U HIFREO	BLU	RF : JJ	U PLUM 1 THP	GRY	IN : UU	T MRFPM2	PLX	S/C1: L
V LD1A	BLU	IN : N	V REDAT	GRN	RF : SS	V PLUM 2 THP	GRY	IN : VV	U 32768H21	PLX	S/C1: M
W LD2A	PUR	IN : P	W ZERO	PUR	RF : KK	W OSC AGC	WHT	RF : E	V 32768H22	WET	S/C1: N
X LD3A	GRY	IN : R	X TOTAL	GRY	RF : LL	X T2 BIAS MN	BLU	BIAS: S	W GSEENABL1-	PLX	S/C2: D
Y LD4A	W/BLK	IN : S	Y DESENS	BLU	BIAS: P	Y PUMP VOLTS	GRN	ELECT: C	X VALVEN-	GR3	IN : BB
Z LD5A	GRN	IN : T	Z IFBCTR	BLU	BIAS: P	Z SENSOR THP	GRY	ELECT: R	Y *CALEN-	GR2	IN : BB
a PYROPLSBI	BLU	IN : U	a MTA0000	GRN	RF : NN	a SHELL PRS	GRN	FIL : L	Z HTREN-	BLT	IN : DD
b PYROPLSBI	PUR	IN : V	b INTRST	GRY	RF : PP	b GSEENABL2-	PUR	S/C2: E	a FMRST FIL	W/3LK	FIL : J
c PYROPLSBI	GRY	IN : W	c ISMEN	W/BLK	IN : HH	c +29 MON	W/BLK	PUR2:NN	b FMRST ILT	GR3	IN : FF
d PYROPLSBI	W/BLK	IN : X	d RSMEN	GRN	RF : RR	d SDATOUT B	WHT	IN : KK	c FILSOF	GR2	FIL : E
e PRUSENA	BLU	IN : Y	e HKSCLK ILT	GRY	RF : TT	e GSE ANAUX	GRN	S/C2: H	d SEL FIL 2	PLX	FIL : B
f PRUSENA	BLU	IN : Z	f HKSCLK RF	W/BLK	FIL : Z	f INLETWD	BLU	IN : AA	e *		
h FIL2FLC	PUR	FIL : f	h T-29	W/BLK	FIL : Z	h -HV CNT	PUR	BIAS: K	h TMP PUR	GR2	PUR1:YY
						h -HV CNT	PUR	BIAS: K	# ATLE H&K O H&KNS		
						*CHANGE Y	TO				
						*PUMP VOLT					
						*11-25-81					

CONTROLLED
AUG 3 1983
PRINT

ENGINEER	DRAFTSMAN
SPACE PHYSICS RESEARCH LABORATORY	HARNES PG 2 of 3
COLLEGE OF ENGINEERING	GALILEO-NMS
UNIVERSITY OF MICHIGAN	B-5072A CONTROLLED
ANN ARBOR, MICHIGAN	
6/2/83	3/5/83
6/22/83	3/5/83
DATE	DATE

IN 44 S 15-Mar-83
 PN SIGNAL COLOR LINK TO
 ED *1-8-82
 A SIGCND1 IL BLK PUR2: N
 B SIGCND2 IL BLK PUR2: P
 C 18 GND1 IL 24BRN PUR1: P
 D 18 GND2 IL 24BRN PUR1: R
 E +18 PW1 IL 24ORC PUR1: L
 F +6 HEATER spare
 H +18 PW2 IL 24ORC PUR1: M
 J +10L IL ORG PUR2: C
 K +28 HEAT A 22RED PUR1: D
 L +28 HEAT B 22RED PUR1: E
 M LD0A GRN LGC1: U
 N LD1A BLU LGC1: V
 P LD2A GRN LGC1: W
 R LD3A GRN LGC1: X
 S LD4A W/BLK LGC1: Y
 T LD5A GRN LGC1: Z
 U PYROPLSA1 BLU LGC1: A
 V PYROPLSBI GRN LGC1: B
 W PYROPLSA2 GRN LGC1: C
 X PYROPLSB2 W/BLK LGC1: D
 Y PRUSENA GRN LGC1: E
 Z PRUSENB BLU LGC1: F
 AA INLETVD BLU LGC1: G
 BB VALVEN- GRN LGC1: H
 CC *CALEN- GRN LGC1: I
 DD HIREN- BLU LGC1: J
 EE OVP B1 PUR FIL: C
 FF FTRST ILT GRN LGC4: b
 HH ISHER W/BLK LGC2: c
 JJ HRSCLK ILT BLU LGC2: e
 KK SDATOUT B WHT LGC3: d
 LL 28 GND A 22BRN PUR1: J
 MM 28 GND B 22BRN PUR1: K
 NN *
 PP CELL 1 TMP GRY LGC3: P
 RR CELL 2 TMP W/BLK LGC3: R
 SS LEAK 1 TMP GRY LGC3: S
 TT LEAK 2 TMP W/BLK LGC3: T
 UU PLUM 1 TMP GRY LGC3: U
 VV PLUM 2 TMP GRY LGC3: V
 WW PYRO PW A 24RED S/C1: Y
 XX PYRO GND B 24BRN S/C1: b
 YY PYRO GND A 24BRN S/C1: a
 ZZ PYRO PW B 24RED S/C1: 2

BIAS 34 S 25-Jan-84
 PN SIGNAL COLOR LINK TO
 ED *1-25-84 ADD F
 A +15R BI ORG PUR1:PP
 B SIG GND BI BLK PUR2: K
 C -10R BI YEL PUR2: W
 D -15R BI YEL PUR2:BB
 E 29 GND BI 24BRN PUR1: W
 F +29 PW BI 24RED PUR1: U
 H T2 CNT GRN LGC2: R
 J T3 CNT GRN LGC2: S
 K -HV CNT PUR LGC3: h
 L +5V BI ORG PUR1:EE
 M ER1 +REF BLU FIL: H
 N ER2 +REF ORG FIL: D
 P IFBCTR BLU LGC3: 2
 R HV MON BLU LGC3: M
 S T2 BIAS MN BLU LGC3: X
 T T3 BIAS MN GRN
 U D14 W/BLK PA: K
 V EA1 GRN ELCT: B
 W EA2 BLU ELCT: C
 X IFB GRN ELCT: J
 Y DEF PUR PA: L
 Z IFA BLU ELCT: K
 AA FSI GRN ELCT: E
 BB FIL 1 BIAS PUR FIL: P
 CC FS2 PUR ELCT: F
 DD FIL 2 BIAS ORG FIL: T
 EE FC1 (FIL1) W/RED ELCT: D
 FF E LENS GRN PA: P
 HH *
 JJ -130 YEL RF: ZZ
 KK +130 RED RF: YY
 LL IG GRN PA: N
 MM FC2 (FIL2) W/ORG ELCT: H
 NN MASK YEL PA: R

6-2-83 ADD FC1 AND FC2 WIRES
 CHANGED NAME OF DELTA IFB TO
 IFBCTR.

1-25-84 CHANGED NAME OF WINDOW
 TO IG. CHANGED NAME OF IFA TO
 IFB AND REVERSE.

FIL 29 S 22-Jun-82
 PN SIGNAL COLOR LINK TO
 ED *3-9-81
 A GUN GND 24BLK ELCT: A
 B SEL FIL 2 PUR LGC4: d
 C SIG GND ER BLK PUR2: R
 D ER1 +REF BLU BIAS: M
 E FILSOFF GRN LGC4: c
 F +15R ER ORG PUR1:TT
 H ER2 +REF ORG BIAS: N
 J FTRST FIL W/BLK LGC4: a
 K +10R ER ORG PUR2: F
 L SHELL PRS PUR LGC3: a
 M PUMP 1 PUR PUR2:KK
 N +5 ER ORG PUR1:CC
 P FIL 1 BIAS BLU BIAS:BB
 R ER1 1 MON WHT LGC3: B
 S -5 ER YEL PUR1:JJ
 T FIL 2 BIAS ORG BIAS:DD
 U ER1S 2 MON W/BLK LGC3: J
 V -15R ER YEL PUR2:EE
 W I ACC GRN ELCT: M
 X REP YEL ELCT: L
 Y 29 GND ER 24BRN PUR1: X
 Z T-29 WHT LGC3: h
 a REP MON W/BLK LGC2: h
 b +29 PW ER 24RED PUR1: V
 c OVP B1 PUR IN: EE
 d ACC MON WHT LGC3: F
 e FIL 2 MON WHT LGC3: L
 f FIL2FLC PUR LGC1: h
 h FIL 1 MON GRN LGC3: K

PA 14 S 25-Jan-84
 PN SIGNAL COLOR LINK TO
 ED *1-25-84 ADD F
 A SIG GND PA BLK PUR2: M
 B +15R PA ORG PUR1:SS
 D -15R PA YEL PUR2:DD
 E *
 F MULTANA WHT LGC3: C
 H +5 PA ORG PUR1: Z
 J 5 GND PA 24BRN PUR1:LL
 K D14 W/BLK BIAS: U
 L DEF PUR BIAS: Y
 M *
 N IG GRN BIAS:LL
 P E LENS GRN BIAS:FF
 R MASK YEL BIAS:NN

1-25-84 CHANGED NAME OF WINDOW
 TO IG.

X1 PA OUT COAX
 X2 PA SHLD COAX
 *SIDE PLUG

ELCT 14 S 25-Jan-84
 PN SIGNAL COLOR LINK TO
 ED *1-25-84 ADD F
 A GUN GND 24BLK FIL: A
 B EA1 GRN BIAS: V
 C EA2 BLU BIAS: W
 D FC1 (FIL1) W/RED BIAS:EE
 E FSI GRN BIAS:AA
 F FS2 PUR BIAS:CC
 H FC2 (FIL2) W/ORG BIAS:MM
 J IFB GRN BIAS: X
 K IFA BLU BIAS: Z
 L REP YEL FIL: X
 M I ACC GRN FIL: W
 N BS LENS V W/BLK LGC2: T
 P SOURCE TMP GRY LGC3: A
 R SENSOR TMP GRY LGC3: A

6-2-83 ADD FC1 AND FC2 WIRES
 1-25-84 CHANGE NAME OF IFA
 AND IFB WIRES.

ENGINEER	1/27/84
SPACE PHYSICS RESEARCH LABORATORY	
COLLEGE OF ENGINEERING	
UNIVERSITY OF MICHIGAN	
ANN ARBOR, MICHIGAN	
DRAFTSMAN	1/27/84
HARNESSES	Pg 3 OF 3
GNMS	6/2/83
B-E6318A CONTROLLED	3/15/83
	6/22/82
	3/5/81
	DATE

FIL PCB 25-Jan-84
PN SIGNAL COLOR LINK TO
ED *1-25-84
X1 FIL 1 +A 22RED EL1 : R
X1 FIL 1 +B 22RED EL2 : X
X2 FIL 1 -A 22BLK EL2 : N
X2 FIL 1 -B 22ORG EL2 : P
X3 FIL 2 +A 22ORG EL1 : J
X3 FIL 2 +B 22BLK EL1 : S
X4 FIL 2 -A 22ORG EL2 : V
X4 FIL 2 -B 22BLK EL2 : W

BIAS PCB 25-Jan-84
PN SIGNAL COLOR LINK TO
X1 NOZ PUR EL1 : D

EL1 20S 25-Jan-84
PN SIGNAL COLOR LINK TO
ED *1-25-84
A *
B *
C *
D NOZ PUR BIAS:X1
E HEAT+ N.C.
F *
G *
H *
J FIL 2 +A 22ORG FIL : X3
K FS2 PUR ELCT: F
L IFA GRV ELCT: K
M BS LENS V W/BLK ELCT: N
N *
P *
R FIL 1 +A 22RED FIL : X1
S FIL 2 +B 22BLK FIL : X3
T EAL GRN ELCT: B
U FC2(FIL 2) WHT ELCT: H
V *
W *
X FIL 1 +B 22RED FIL : X1
Y *
Z *
a *
b *
c *
d *
e *
f *
h *

EL2 20S 25-Jan-84
PN SIGNAL COLOR LINK TO
ED *1-25-84
A *
B *
C *
D IFB BLU ELCT: J
E FC1(FIL1) W/BLU ELCT: D
F *
G *
H *
J *
K FSI GRN ELCT: E
L REP YEL ELCT: L
M I ACC GRV ELCT: M
N FIL 1 -A 22BLK FIL : X2
P FIL 1 -B 22BLK FIL : X2
Q *
R *
S *
T HEAT- N.C.
U EAL BLU ELCT: C
V FIL 2 -A 22ORG FIL : X4
W FIL 2 -B 22BLK FIL : X4
X *
Y *
Z *
a *
b *
c *
d *
e *
f *
h *



EL1 14 P 25-Jan-84
PN SIGNAL COLOR LINK TO
ED *1-25-84
A GUN GND 24BLK EL1 : LG
B EAL GRN EL1 : T
C EAL BLU EL2 : U
D FC1(FIL1) W/BLU EL2 : E
E FSI GRN EL2 : K
F FS2 PUR EL1 : K
H FC2(FIL 2) WHT EL1 : U
J IFB BLU EL2 : D
K IFA GRV EL1 : L
L REP YEL EL2 : L
M I ACC GRV EL2 : M
N BS LENS V W/BLK EL1 : M
P *

1-25-84 REVERSE J/K IFA/B
FILE:ELECHR.DOC
DISK:GNMS-WIRE CONNECTIONS



LG GUN GND 24BLK ELCT: A
1-25-84 ADDED REDUNDANT
FILAMENT WIRES


CONTROLLED

PRINT

ENGINEER	J MAUER	DRAFTSMAN	V/23/8
SPACE PHYSICS RESEARCH LABORATORY		ELECTRODE HARNESS	
COLLEGE OF ENGINEERING		GNMS	
UNIVERSITY OF MICHIGAN		B-E6471A CONTROLLED	
ANN ARBOR, MICHIGAN		DATE	

LAST USED R C D L

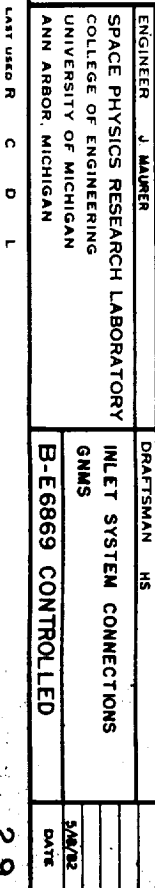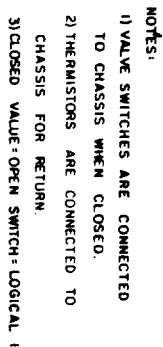

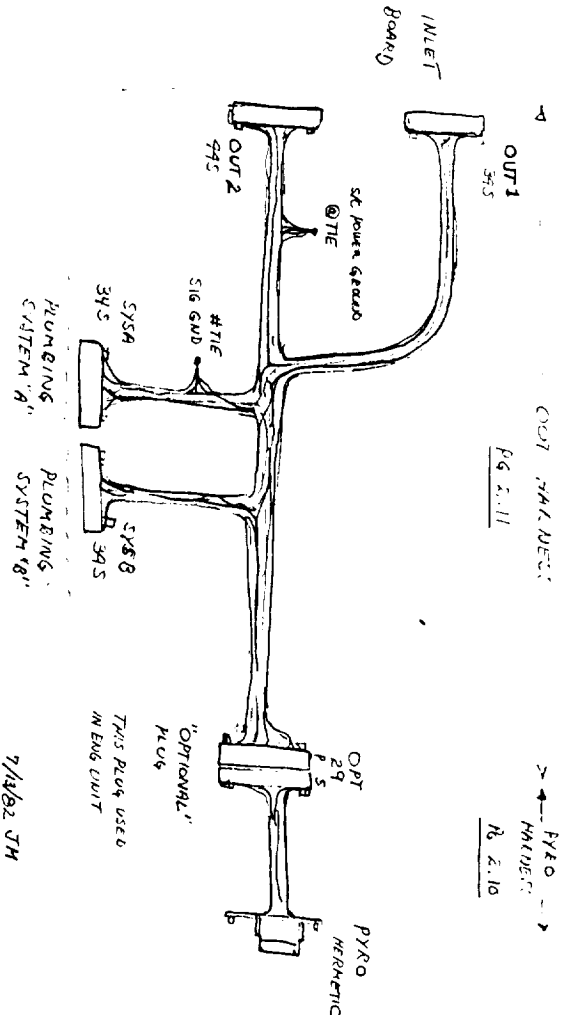

OPT	SIGNAL	COLOR	LINK	TO
ED *5-21-82				
A /GNDPYRO1A	24BRN	PYRO: 2		
B /GNDPYRO2B	24BRN	PYRO: 8		
C /GNDPYRO3A	24BRN	PYRO: 10		
D /GNDPYRO3B	24BRN	PYRO: 12		
E PYRO 3A	PW 24RED	PYRO: 9		
F PYRO 1B	PW 24RED	PYRO: 3		
H PYRO 1A	PW 24RED	PYRO: 1		
J PYRO 3B	PW 24RED	PYRO: 11		
K PYRO 4A	PW 24RED	PYRO: 13		
L PYRO 2B	PW 24RED	PYRO: 7		
M PYRO 2A	PW 24RED	PYRO: 5		
N PYRO 4B	PW 24RED	PYRO: 15		
P *				
R V10 GND	BLK	PYRO: 20		
S V10 COMMON	24B/W	PYRO: 20		
T V10A+CLOSE	24R/W	PYRO: 21		
U V10B +CLOSE	PNK	PYRO: 22		
V V10B+CLOSE	24R/W	PYRO: 24		
X V11 GND	BLK	PYRO: 25		
Y V11 COMMON	24B/W	PYRO: 25		
Z V11 +CLOSE	24R/W	PYRO: 26		
a V11 +CLOSE	PNK	PYRO: 27		
b V12 GND	BLK	PYRO: 28		
c V12 RTN	24B/W	PYRO: 28		
d V12 +CLOSE	24R/W	PYRO: 29		
e V12 +CLOSE	PNK	PYRO: 30		
f *				

PYRO	SIGNAL	COLOR	LINK	TO
ED *5-18-82				
1 PYRO 1A	PW 24RED	OPT: H		
2 /GNDPYRO1A	24BRN	OPT: A		
3 PYRO 1B	PW 24RED	OPT: F		
4 /GNDPYRO1B	JUMP			
5 PYRO 2A	PW 24RED	OPT: M		
6 /GNDPYRO2A	JUMP			
7 PYRO 2B	PW 24RED	OPT: L		
8 /GNDPYRO2B	24BRN	OPT: B		
9 PYRO 3A	PW 24RED	OPT: E		
10 /GNDPYRO3A	24BRN	OPT: C		
11 PYRO 3B	PW 24RED	OPT: J		
12 /GNDPYRO3B	24BRN	OPT: D		
13 PYRO 4A	PW 24RED	OPT: K		
14 /GNDPYRO4A	JUMP			
15 PYRO 4B	PW 24RED	OPT: N		
16 /GNDPYRO4B	JUMP			
17 *				
18 PYRO SHLD	LUG			
19 V10 GND	BLK	OPT: R		
20 V10 COMMON	24B/W	OPT: S		
21 V10A+CLOSE	24R/W	OPT: T		
22 V10B +CLOSE	PNK	OPT: U		
23 V10B+CLOSE	24R/W	OPT: V		
24 V10B+CLOSE	24R/W	OPT: W		
25 V11 GND	BLK	OPT: X		
26 V11 COMMON	24B/W	OPT: Y		
27 V11 +CLOSE	24R/W	OPT: Z		
28 V12 GND	BLK	OPT: a		
29 V12 RTN	24B/W	OPT: b		
30 V12 +CLOSE	24R/W	OPT: c		
31 V12 +CLOSE	PNK	OPT: d		
31 *				
32 *				
33 *				
34 *				
35 *				
36 *				
37 *				

* /TIE ALL PYRO
GND AT MS PLUG.


ENGINEER MAURER	DRAFTSMAN
SPACE PHYSICS RESEARCH LABORATORY	INLET PYRO HARNESS
COLLEGE OF ENGINEERING	
UNIVERSITY OF MICHIGAN	
ANN ARBOR, MICHIGAN	
B-E 6897	
	DATE

CONNECTN 12-Jul-82									
OUT1	SIGNAL	COLOR	LINK	TO	OUT2	44	12-Jul-82	SYSA	34PIN
ED *5-18-82	A VALV OP+ 1	PNK	SYSA: U	PN	ED *5-18-82	A /GNDPYRO1A	24BRN OPT : A	B VALVCL2	BLU
	B VALVCL1	GRN	SYSA: R	B		B /GNDPYRO2B	24BRN OPT : B	C	
	C VALV OP+ 2	PNK	SYSA: E	C		C /GNDPYRO3A	24BRN OPT : C	D	
	D VALVCL2	BLU	SYSA: B	D		D /GNDPYRO3B	24BRN OPT : D	E	
	E VALV OP+ 3	PNK	SYSA: P	E		E PYRO 3A PM	24RED OPT : E	F	
	F VALVCL3	YEL	SYSA: L	F		F PYRO 1B PM	24RED OPT : F	G	
	H VALV OP+ 4	PNK	SYSA: K	H		H PYRO 1A PM	24RED OPT : H	I	
	J VALVCL4	PUR	SYSA: F	J		J PYRO 3B PM	24RED OPT : J	K	
	K VALV OP+ 5	PNK	SYSA: Y	K		K PYRO 4A PM	24RED OPT : K	L	
	L VALVCL5	WHT	SYSA: V	L		L PYRO 2B PM	24RED OPT : L	M	
	M VALV OP+ 6	PNK	SYSA: HH	M		M PYRO 2A PM	24RED OPT : M	N	
	N VALVCL6	YEL	SYSA: NN	N		N PYRO 4B PM	24RED OPT : N		
	P VALV OP+ 7	PNK	SYSA: U	P					
	R VALVCL7	GRN	SYSA: Z	R		R HEAT 3 RTN	24BLK SYSA: KK		
	S VALV OP+ 8	PNK	SYSA: Y	S		S SW GND B	24BLK SYSA: EE		
	T VALVCL8	BLU	SYSA: DD	T		T HEAT 6 RTN	24BLK SYSA: W		
	U VALV OP+ 9	PNK	SYSA: CC	U		U HEAT 5	22ORG SYSA: H		
	V VALVCL9	YEL	SYSA: JJ	V		V VSW1	B8 BLU SYSA: T		
	W V10A +CLOSE	PNK	OPT : U	W		W			
	X V10B +CLOSE	PNK	OPT : V	X		X VSW7	B2 GRN SYSA: X		
	Y V11	+CLOSE	PNK	Y		Y HEAT 6	22ORG SYSA: S		
	Z		OPT : A	Z		Z VSW2	B7 PUR SYSA: D		
	AA V12 +CLOSE	PNK	OPT : e	AA		AA HEAT 2	22ORG SYSA: W		
	BB			BB		BB VSW9	B1 YEL SYSA: BB		
	CC			CC		CC			
	DD V10 GND	24BLK	OPT : R	DD		DD VSW3	B6 WHT SYSA: N		
	EE V11 GND	24BLK	OPT : X	EE		EE HEAT 3	22ORG SYSA: AA		
	FF V12 GND	24BLK	OPT : b	FF		FF VSW9	B8 GRN SYSA: FF		
	HH			HH		HH HEAT 8	22ORG SYSA: K		
	JJ SW GND A	BLK	SYSA: NN	JJ		JJ VSW4	B5 PUR SYSA: J		
	KK			KK		KK HEAT 4	22ORG SYSA: M		
	LL CELL 1 TMP GRY	SYSA: H		LL		LL VSW10A	B4 WHT SYSA: BB		
	MM CELL 2 TMP GRY	SYSA: L		MM		MM VSW10B	B6 WHT SYSA: FF		
	NN			NN		NN VSW5	B4 BLU SYSA: X		
						PP S/C GND 1	BLK OPT : e		
						RR VSW11	B5 GRN SYSA: LL		
						SS S/C GND 2	BLK OPT : e		
						TT VSW6	B3 YEL SYSA: LL		
						UU S/C GND 3	BLK OPT : e		
						VV			
						WW LEAK 2 TMP GRY	SYSA: N		
						XX PLUM 2 TMP GRY	SYSA: R		
						YY LEAK 1 TMP GRY	SYSA: S		
						ZZ PLUM 1 TMP GRY	SYSA: M		

FILE: OUTNR.PIN

ENGINEER	J MAURER	DRFTSPERSON	MFG	11/15/78
SPACE PHYSICS RESEARCH LABORATORY				
COLLEGE OF ENGINEERING				
UNIVERSITY OF MICHIGAN				
ANN ARBOR, MICHIGAN				
INLET OUTPUT HARNESS		B-E5806		
GNMS		DATE		


ATTN:

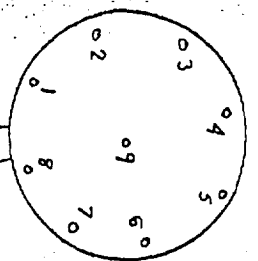



1. High Voltage (cm)
2. Mood
3. Jolt point (Wilson)
4. Case ground
5. Defects

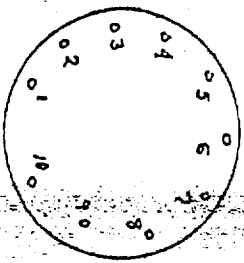








[illegible]






ER J MAURER	DRAFTSMAN	
PHYSICS RESEARCH LABORATORY	SENSOR PIN ASSIGNMENTS	
STATE OF ENGINEERING	GNMS	
UNIVERSITY OF MICHIGAN	B-E 5622	10/11/79
ANN ARBOR, MICHIGAN		DATE
NR C D L		2.12

SOCKETS

PLUGS

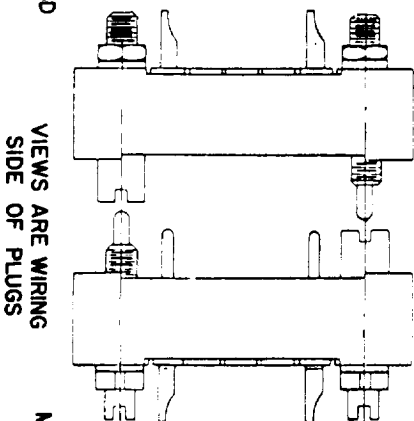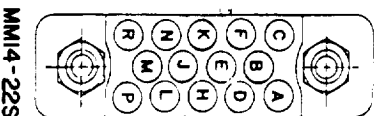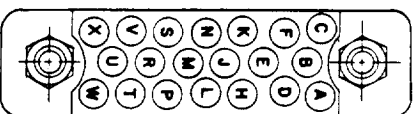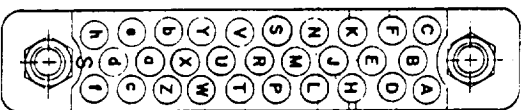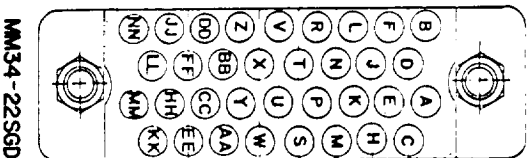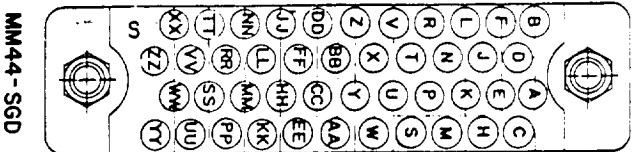

VIEWS ARE WIRING
SIDE OF PLUGS

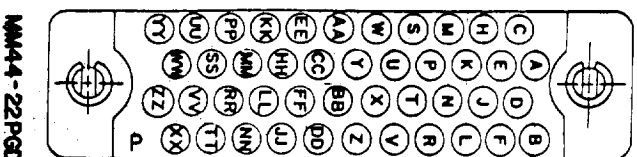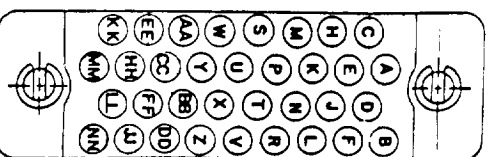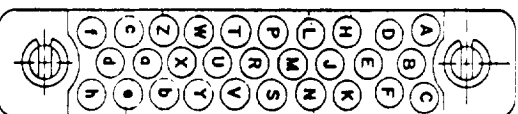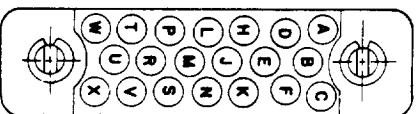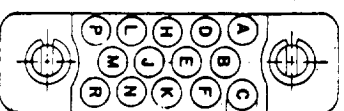


ENGINEER J. MAHER / M. HETTEMAN		DRAFTSMAN BT	
SPACE PHYSICS RESEARCH LABORATORY		CONTINENTAL CONNECTOR LAYOUT	
COLLEGE OF ENGINEERING		GNMS	
UNIVERSITY OF MICHIGAN		B-EG280	
ANN ARBOR, MICHIGAN		DATE	

LAST USED R C D L

SECTION CC



THIS SECTION DOES NOT SHOW
THE CONNECTOR BULKHEAD

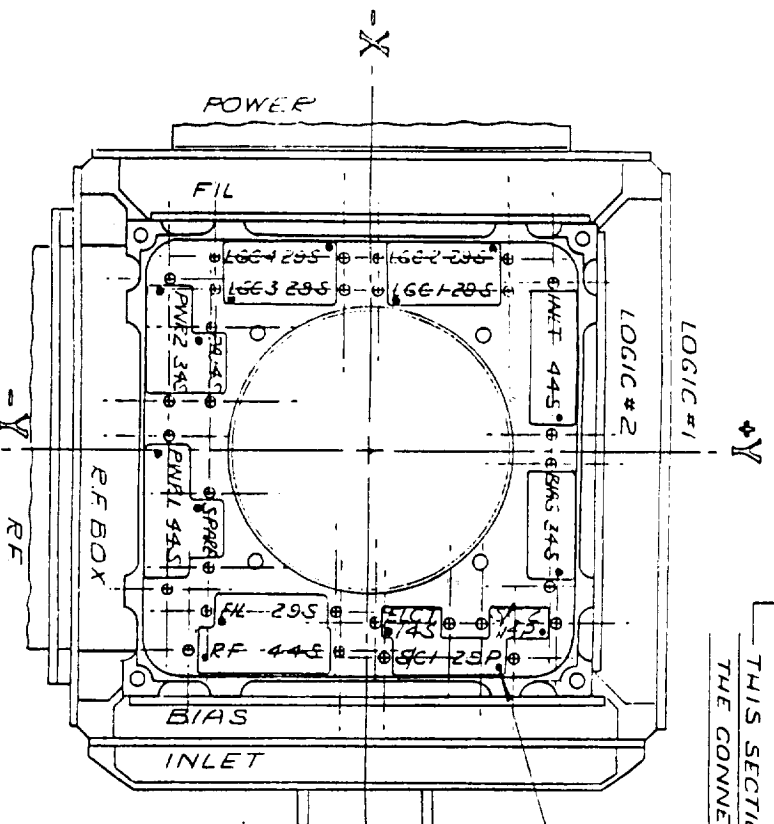

END VIEW
CONNECTOR BKT.
AS SEEN FROM DOME
END OF INSTRUMENT
HOUSING.

ENGINEER MAURER	DRAFTSMAN G. WIGGINS	3/13/81
SPACE PHYSICS RESEARCH LABORATORY	MAIN HARNESS CONNECTOR LOC.	
COLLEGE OF ENGINEERING	NEUTRAL MASS SPECTROMETER	
UNIVERSITY OF MICHIGAN	GALILEO	
ANN ARBOR, MICHIGAN	B-E-6466	
	DATE	

LAST USED R C D L

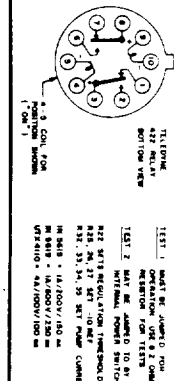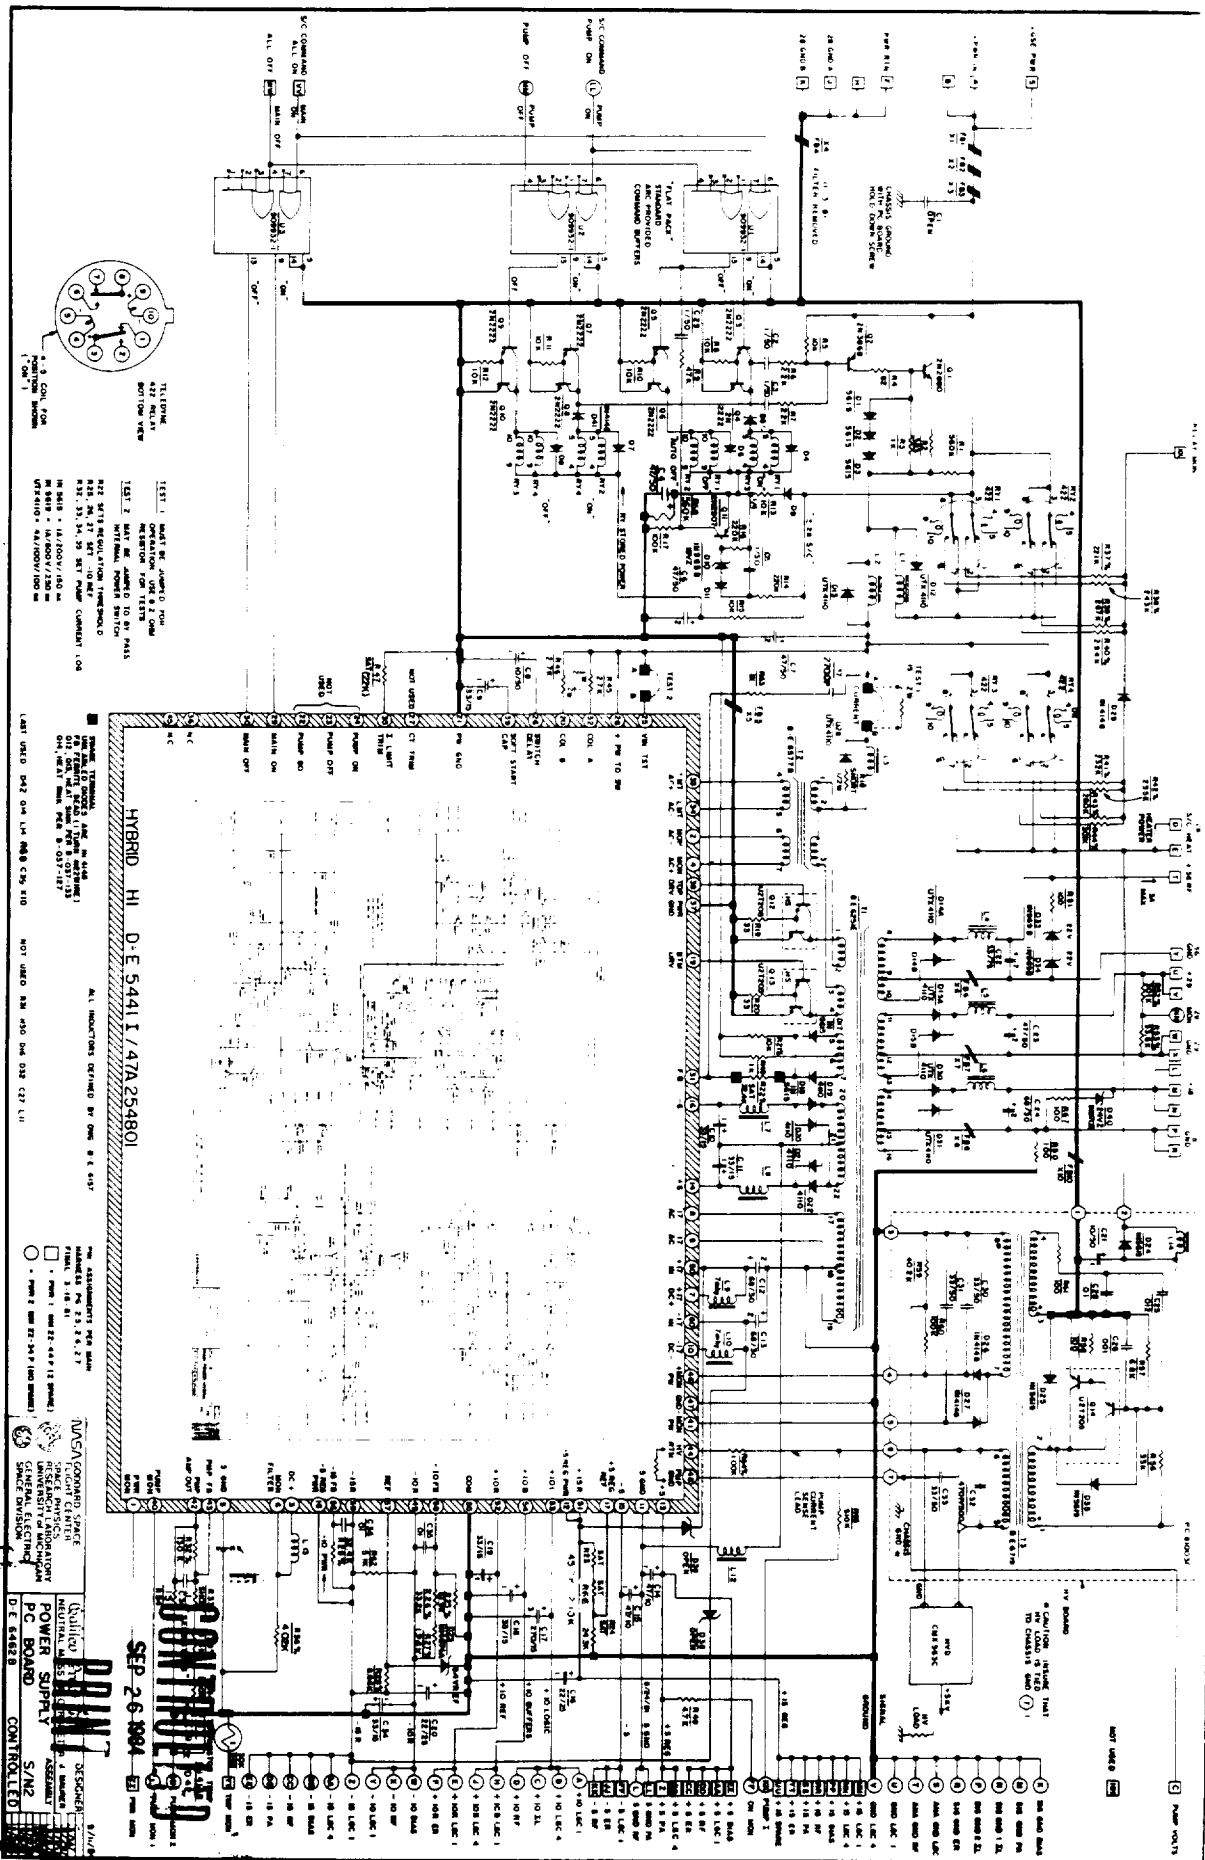

TEST POINTS
1. MAIN POWER SWITCH
2. MAIN POWER SWITCH
HYBRID HI D-E 5441/47A 254801
NOT USED RN 455 D46 D22 C27 L11

POWER SUPPLY

CONTROLLED

GENS HAIR POWER SUPPLY INDUCTORS

I. Hauer/dn 1/4/82

measured 7/1/81 PR

Line	Use	Dia/w(1) P/N	Atwood P/N	Winding	L (2)	A (3)	R	Z (4)	Dia.	H (5)	L (6)	L Meas.	R Meas.	Leg
L1	Ry Input	.65/250	369144	27c #22/26"	105 uhy	1.6	.035	45	.66	13	4.40	100.4uhy	0.042	L1
L2	Cap Input	.68/173	194123	54c #22/65"	358 uhy	1.5	.084	160	.72	24	4.21	340.5uhy	0.078	L2
L3	Sat. Limit	.65/250	369144	22c #22/21"	70 uhy	2.0	.03	3.0	.68	13	4.20	67uhy	0.036	L3
L4	+36 filter	.68/175	194123	162c #24/173"	3.2 mhy	.5A	.38	1.5k	.80	24	4.21	3.15mhy	0.377	L4
L5	+29 filter	.68/175	194123	162c #24/173"	3.2 mhy	.5A	.38	1.5k	.80	24	4.21	3.07mhy	0.365	L5
L6	+18 filter	.68/175	194123	162c #24/173"	3.2 mhy	.5A	.38	1.5k	.80	24	4.21	3.23mhy	0.372	L6
L7	+6 filter	.38/250	365132	47c #28/30"	290 uhy	.5A	.17	90	.40	13	2.26	320.6uhy	0.182	L7
L8	-6 filter	.38/250	365132	47c #28/30"	290 uhy	.5A	.17	90	.40	13	2.26	330.5uhy	0.182	L8
L9	+17 filter	.38/250	365132	225c #32/125"	7 mhy					13	2.26	7.17mhy	1.95	L9
L10	-17 filter	.38/250	365132	225c #32/125"	7 mhy					13	2.26	7.17mhy	1.95	L10
L11	NOT USED													
L12	5 GND	.26/300	384130	40c #30/20"	220 uhy	.28A	.20	100	.28	10	1.45	220u	0.185	L12
L13	PWR MON	.26/300	384130	110c #36	1.9 mhy					10		1.95mhy	1.92	L13
L14	Pump In	.38/250	365132	47c #28/30"	290 uhy	.5A	.17	90	.40	13	2.26	320.6u	0.173	L14

NOTES: (1) O.D. of core in inches/permeability.

(2) The zero current inductance.

(3) Current for a 25% decrease in inductance.


(4) Impedance at 70 KHz.

(5) Flux density in Oersteds for 75% inductance.

(6) Effective core length in cm.

$$H = \frac{.4\pi NI}{l} \quad I = \frac{W}{.4\pi N}$$

ENGINEER J MAURER	DRAFTSMAN TS	7/1/81
SPACE PHYSICS RESEARCH LABORATORY	MAIN SUPPLY INDUCTORS	
COLLEGE OF ENGINEERING	GALEO-NMS	
UNIVERSITY OF MICHIGAN		
ANN ARBOR, MICHIGAN		
	B-E 6157A CONTROLLED	
		DATE
		9/22/81
		7/6/81

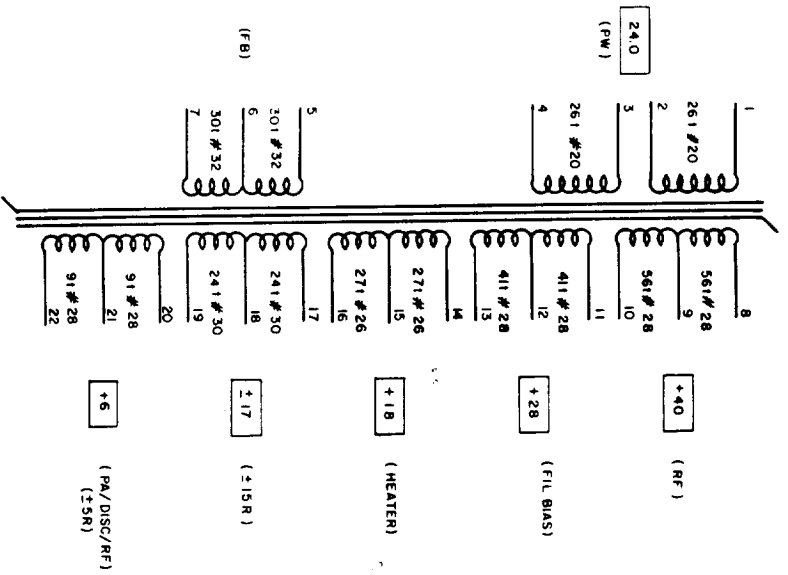

CORE : ARNOLD 6T5502 - M1
857 v/1 PRI @ 24V IN 85 % ON TIME.


$$\begin{aligned} f_o \text{ MIN} &= \frac{5 \times 10^8}{4 \times 27 \times .0313 \times 7000 \times 6.45} = 20.1 \text{ KHZ (WORST CASE)} \\ &= \frac{27 \times 10^8}{4 \times 27 \times .0313 \times 7000 \times 6.45} = 17.7 \text{ KHZ (TYPICAL)} \\ &\approx 40\% \text{ MARGIN} \end{aligned}$$

REV A BREADBOARD
REV B GSFC BREADBOARD
REV C ENG. 11/3/81 MOD. TO 'D'
REV D ENG. 11/13/81
REV E ENG. 11/23/81 4 μ D1

LOG

4th DEAD TIME &
SMALLER WIRE.


SECTION WIND APPROXIMATELY AS SHOWN.
BANK WIND AS MUCH AS POSSIBLE IN SECTION.
DO NOT OVERLAP SECTIONS.
PRIMARY HALVES SHOULD BE CLOSE AND SYMMETRIC,
BUT NOT OVERLAPPED.

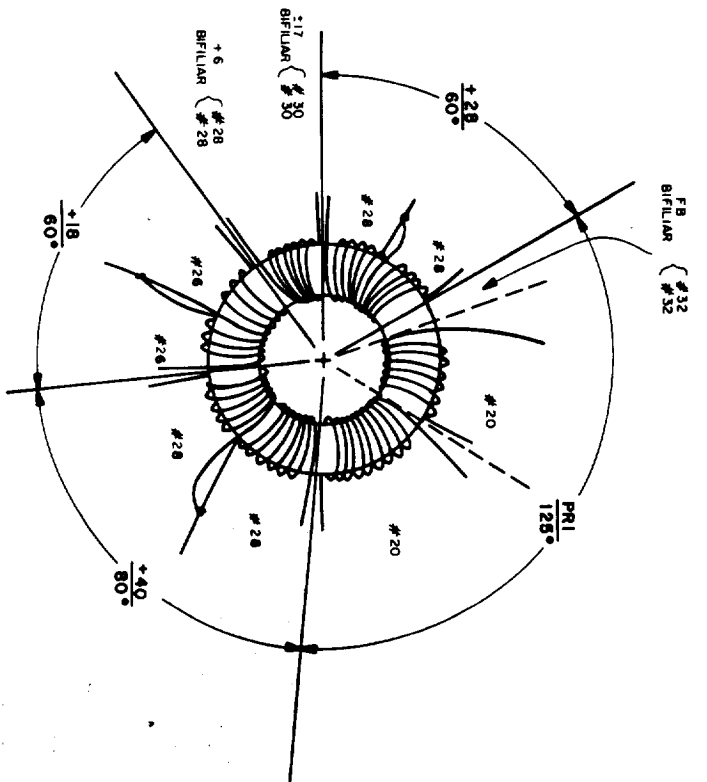

ENGINEER	J MAURER	5/28/81		
SPACE PHYSICS RESEARCH LABORATORY				
COLLEGE OF ENGINEERING				
UNIVERSITY OF MICHIGAN				
ANN ARBOR, MICHIGAN				
	DRAFTSMAN	TS	5/28/81	
	MAIN XFMR T1			
	GALILEO NMS			
	B-E 6251E CONTROLLED		5/31/82	
			DATE	


ELECTRON MULTIPLIER HIGH VOLTAGE SUPPLY

1. INPUT
 - PRIMARY REGULATED AND PROGRAMMED
2. TYPE
 - PARALLEL MULTIPLIER
3. STAGES
 - 4 STAGES
4. INPUT
 - SINE INPUT
 - 32 KHZ +/- 3 KHZ
 - 875V P-P NORMAL INPUT
 - 1750V P-P MAXIMUM TEST INPUT
5. OUTPUT
 - NEGATIVE
 - 3.2KV @ 60 uA: NORMAL
 - 7.0KV @ 0 uA: MAXIMUM TEST
 - 2% REGULATION W/ R-C OUTPUT FILTER
 - .5V MAXIMUM P-P RIPPLE
6. ENVIRONMENTAL
 - -20 TO +60 DEG C. OPERATING
 - -30 TO +60 DEG C. STORAGE
 - +30PSIA TO HARD VACUUM
7. MISC.
 - 100K R-C OUTPUT FILTER
 - 10K OUTPUT ARC CURRENT LIMIT
 - SPRL 79/112 R&QA SPECIFICATION
 - POTTING: EAC 2850FT BLACK W/CAT11
 - WITH HIGH TEMP BAKE.
 - WEIGHT: 61 GRAMS
 - MFG: HIGH VOLTAGE DEVICES, INC.

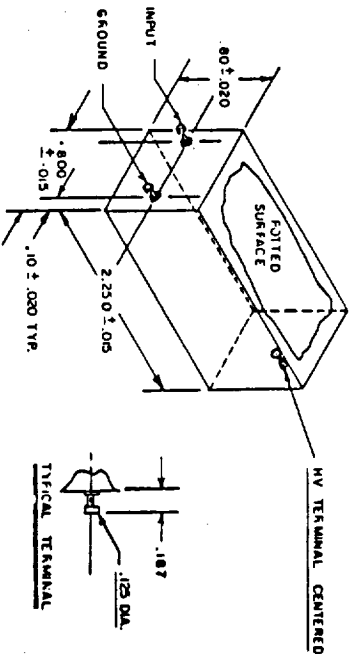


CMX 564C

WT. = 61 GRAMS

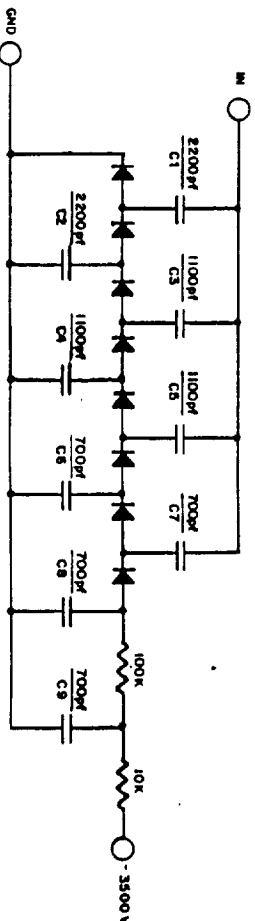


ENGINEER J. STEVENS	DRAFTSMAN MNH	5/1/81
SPACE PHYSICS RESEARCH LABORATORY	VOLTAGE MULTIPLIER	
COLLEGE OF ENGINEERING	GNMS	5/16/83
UNIVERSITY OF MICHIGAN		5/11/81
ANN ARBOR, MICHIGAN	B-E5342 A CONTROLLED	DATE

LAST USED R C D L

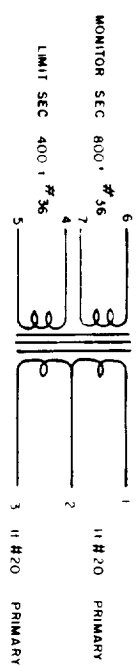

CORE ANGLE 390/34 2 500/300 MPP

WINDING: 11 FLAR WIND INITIAL AND PAST-
TERMINATE WINDING 4 A S BUT
SWITCH TO SMALLER SHUTTLE
AND CONTINUE WITH 400 MORE
PASSES TO FINISH MONITOR SECOND-
ARY

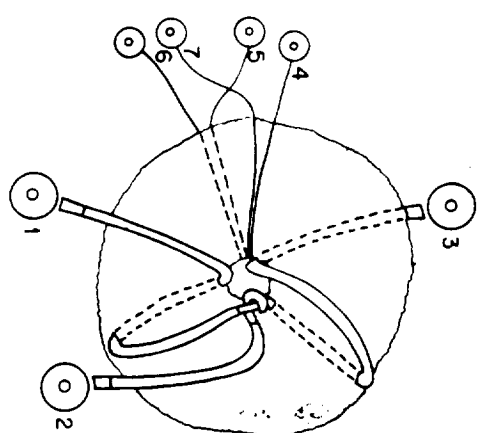


CONTROLLED
PRINT


ENGINEER	J. MAURER	DRAFTSMAN	D.B.J.	5/8/81
SPACE PHYSICS RESEARCH LABORATORY				
COLLEGE OF ENGINEERING				
UNIVERSITY OF MICHIGAN				
ANN ARBOR, MICHIGAN				
CURRENT TRANSFORMER (T2)		3/29/84		
MAIN SUPPLY		3/12/82		
GMS		2/26/82		
DATE		11/13/81		
B-E6577B CONTROLLED				

LAST USED R C D L

**COMPONENT
SIDE
82001E**

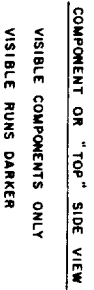

LAST USED R C D L

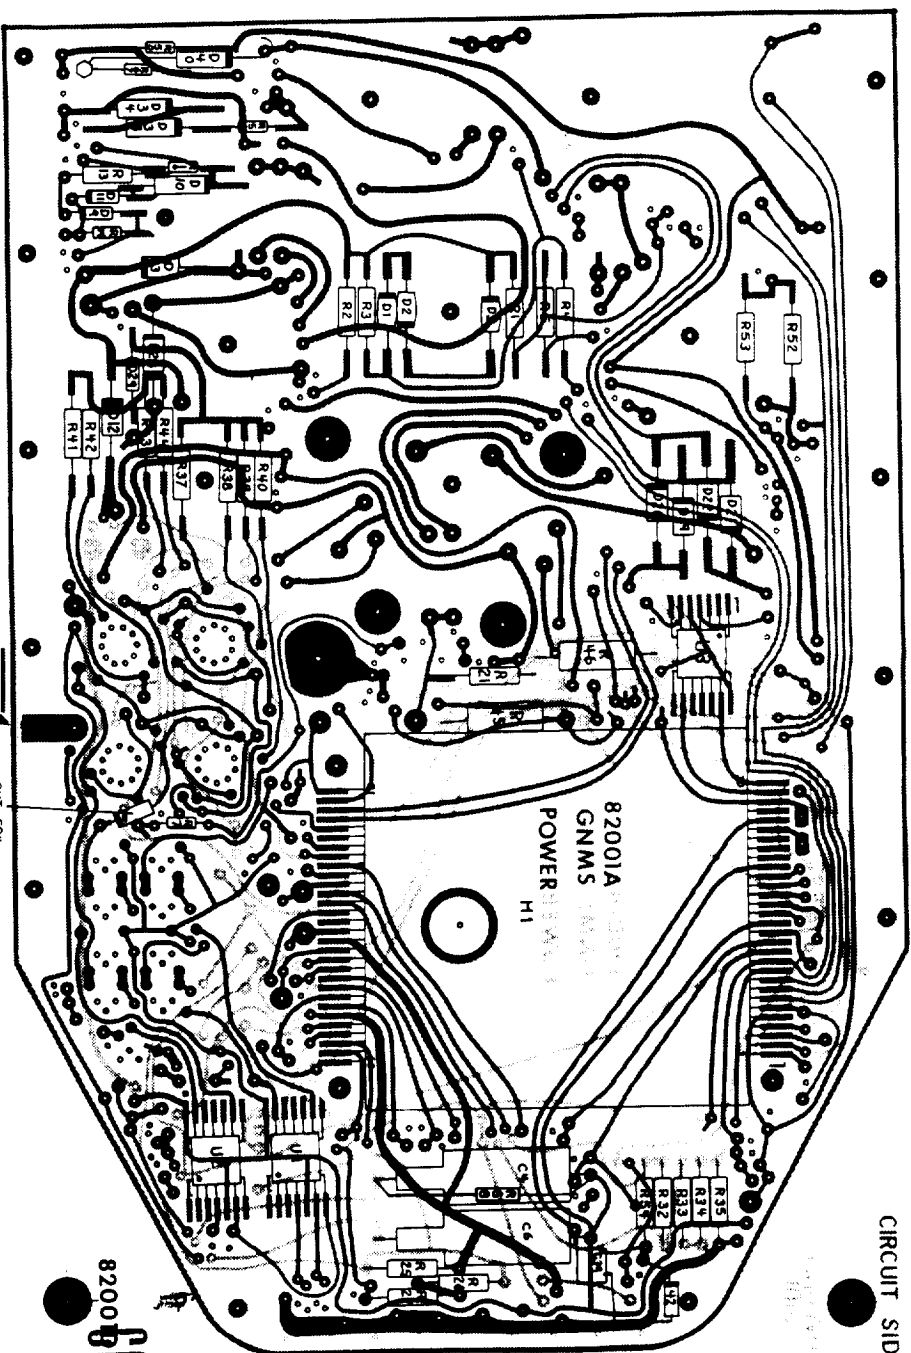

CIRCUIT SIDE

DRILL 1/32 IN. A. 101 CUT FOIL ADD DIODE D41


CIRCUIT OR "BOTTOM" SIDE VIEW
VISIBLE COMPONENTS ONLY
VISIBLE RUNS DARKER

ENGINEER BLEDSOE/MAURER	DRAFTSMAN M.D.	DATE
SPACE PHYSICS RESEARCH LABORATORY	COMPONENT LAYOUT REVERSE	9/11/84
COLLEGE OF ENGINEERING	POWER SUPPLY	8/29/83
UNIVERSITY OF MICHIGAN	GNMS	8/10/83
ANN ARBOR, MICHIGAN	B-E6854 CONTROLLED	5/31/82
		DATE

LAST USED R C D L

3.15

8200 CONTROL
SEP 21 1984
PRL

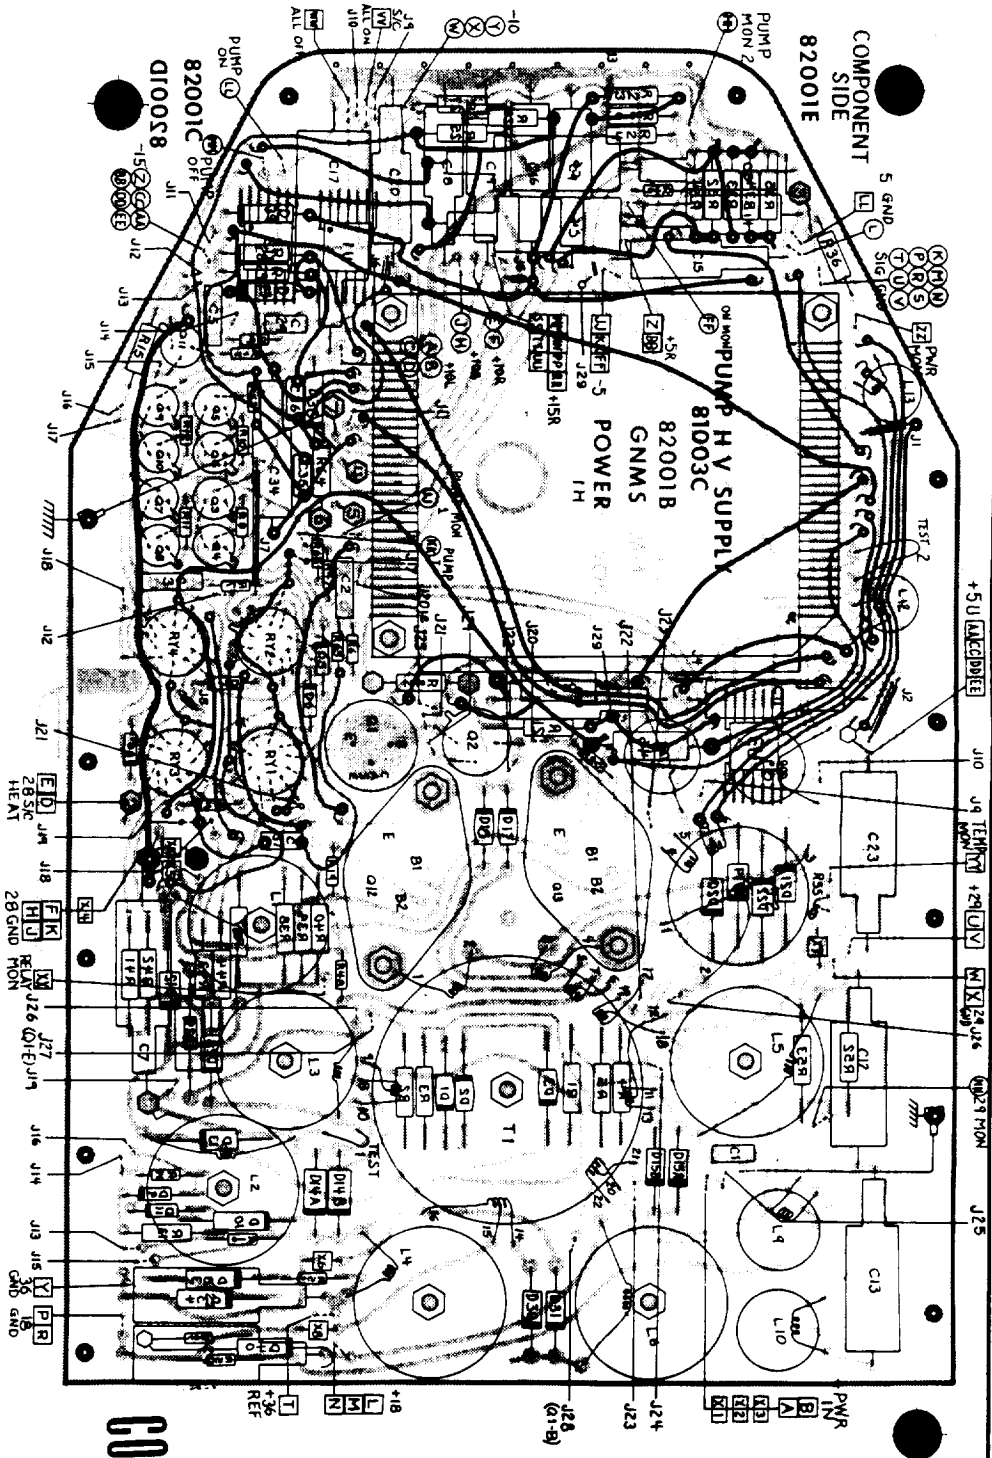


NOTES
R68 NOT SHOWN (ACROSS C4)
D41 NOT SHOWN
C39, D42 NOT SHOWN (BETWEEN
AND SIG GND)

COMPONENT OR "TOP" SIDE VIEW
VISIBLE RUNS DARKER
VISIBLE COMPONENTS SOLID AND READABLE


ENGINEER BLEDSOE/MAURER		DRAFTSMAN N.D.	
SPACE PHYSICS RESEARCH LABORATORY		COMPONENT LAYOUT COMPOSITE	
COLLEGE OF ENGINEERING		POWER SUPPLY	
UNIVERSITY OF MICHIGAN		S/N 2	
ANN ARBOR, MICHIGAN		B-E6853 CONTROLLED	
LAST USED C D L		DATE	
		3.16	

CONTROLLED
SEP 21 1984
PRINT

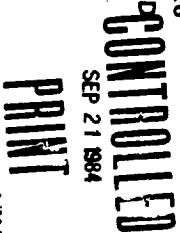


LAST USED R C D L

3.17

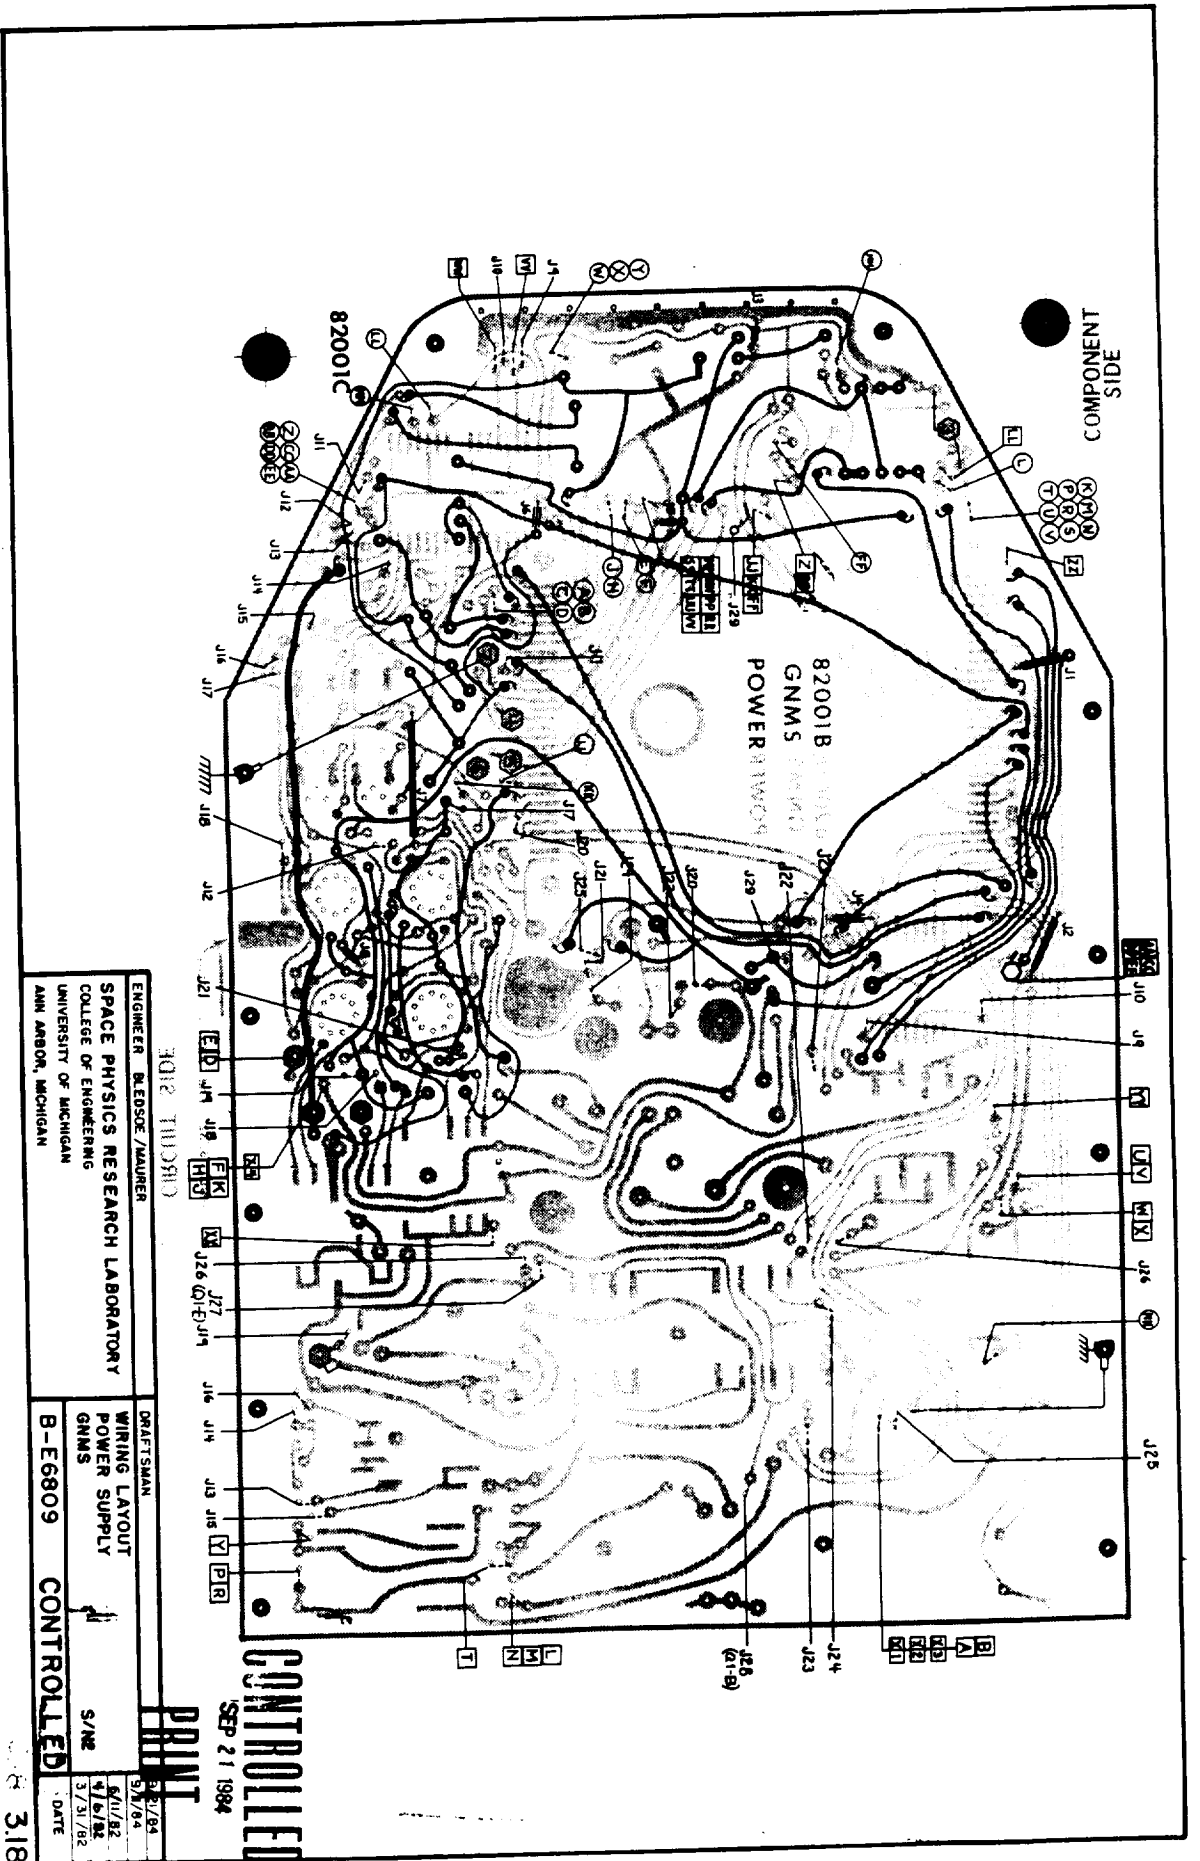

TOP VIEW OF CORE ASSEMBLY

* SHIM MATERIAL AND
SHIM THICKNESS AS SPECIFIED
BY TEST ENGINEER

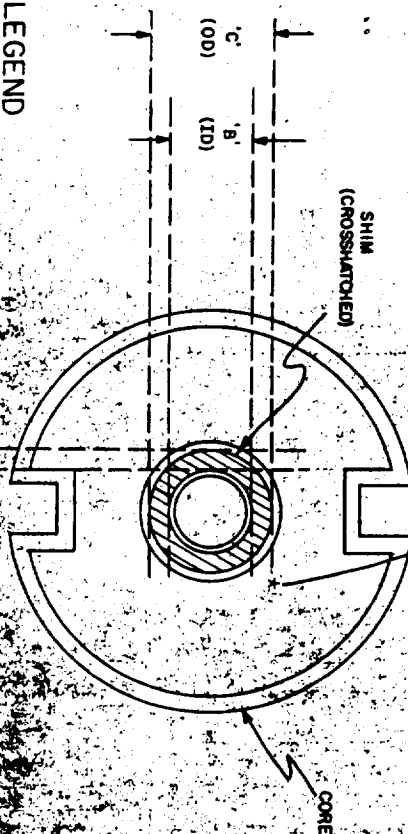



LEGEND

ENGINEER: J. BROOKS	DRAFTSMAN: J. M. V.
SPACE PHYSICS RESEARCH LABORATORY	SHIM DESIGN


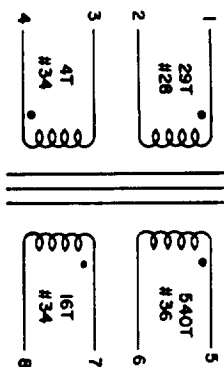

• NOTE: PHASING OF
1-2 & 3-4 MUST
BE AS SHOWN

CORE: F42213 -UG (POWER FERRITE)
BOBBIN: B2213-1 (DELFIN)
MAGNETICS, INC.

WINDING PROCEDURE

1. WIND FB 3-4 START 3 AT LEFT EDGE, DRESS 3 OUTSIDE SLOT OF BOBBIN WITH 4, CLOSE WOUND, "SEE FIGURE 1".
2. PLACE TWO LAYERS OF KAPTON OVER FB 3-4 WINDING.
3. WIND SEC 5-6 START 5 NEXT TO 4 DRESS 5 OUTSIDE SEPARATE SLOT (SEE FIGURE #2). CLOSE WIND SEC 5-6 ACROSS ENTIRE BOBBIN FILL SURFACE EDGE TO EDGE. DRESS 6 OUTSIDE SLOT OPPOSITE 5 (SEE FIGURE #2). SECURE WINDING WITH ONE LAYER OF KAPTON TAPE.
4. WIND PRIMARY 1-2 START AT LEFT EDGE EXIT LEADS FROM BOBBIN WITH SLOT 3-4. SECURE PRIMARY WINDING WITH KAPTON TAPE.
5. WIND SEC 7-8 START AT LEFT EDGE EXIT LEADS WITH 6. SECURE WINDING WITH KAPTON TAPE.
6. "DIP COAT" BOBBIN ONLY IN SOLITHANE 113 PER POTTING PROCEDURE. SEE FIGURE #3.
7. ASSEMBLE BOBBIN IN CORE, OPERATE TRANSFORMER IN TEST CIRCUIT (BREADBOARD).
8. SHIM CORE HALVES APPROXIMATELY .020" TO GET DESIRED FREQUENCY RANGE. (FREQUENCY WILL DECREASE WITH MULTIPLIER LOAD).

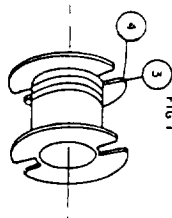


FIG 2



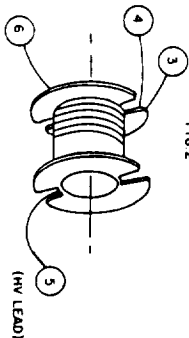


FIG 3

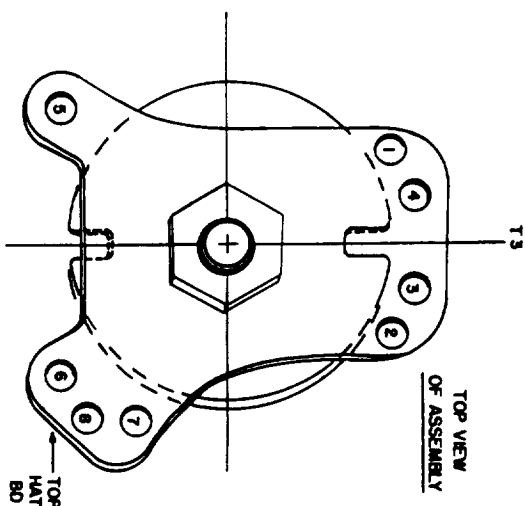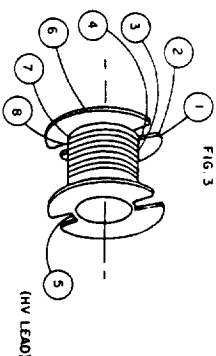

NOTES:


- 1) WINDING ORDER: 3-4 FB
5-6 SEC
1-2 PRI
7-8 SEC

- 2) SCRIBE S/N ON BOBBIN
- 3) DRESS LEADS ON TOP HAT #810030
- 4) TOP HAT BOARD 1/32 PC MATERIAL.
SWAGE TERMINALS - USECO #25004
HOLE SIZE - DRILL SIZE #19
- 5) DRILL #21 HOLE FOR MOUNTING SCREW
- 6) USE #8 - 32 BD HD NYLON MOUNTING SCREW


ENGINEER J. MAUER/M.A.H.	DRAFTSMAN D.R.	10/27/81
SPACE PHYSICS RESEARCH LABORATORY	PUMP SUPPLY TRANSFORMER T3	
COLLEGE OF ENGINEERING	POWER SUPPLY	9/3/82
UNIVERSITY OF MICHIGAN	GALILEO	3/31/82
ANN ARBOR, MICHIGAN	B-E6719 CONTROLLED	DATE


LAST USED R C D L

COMPONENT SIDE

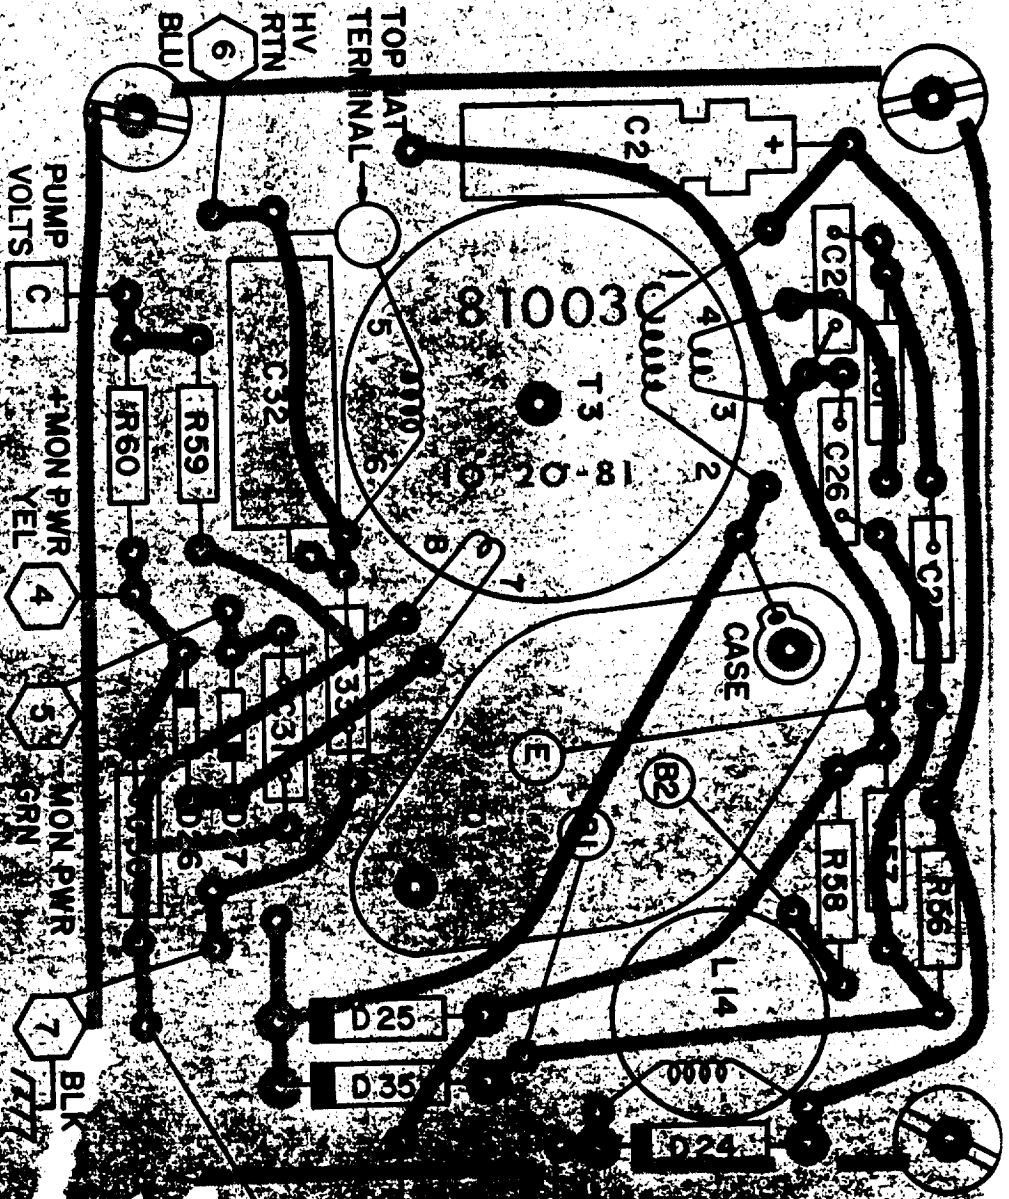

ENGINEER: J. MAUER / J. BLERDORF	DRAFTSMAN: T. D.
SPACE PHYSICS RESEARCH LABORATORY	COMPONENT LAYOUT
SCHOOL OF ENGINEERING	VACUUM SUPPLY AUX. BOARD
UNIVERSITY OF MICHIGAN	POWER SUPPLY

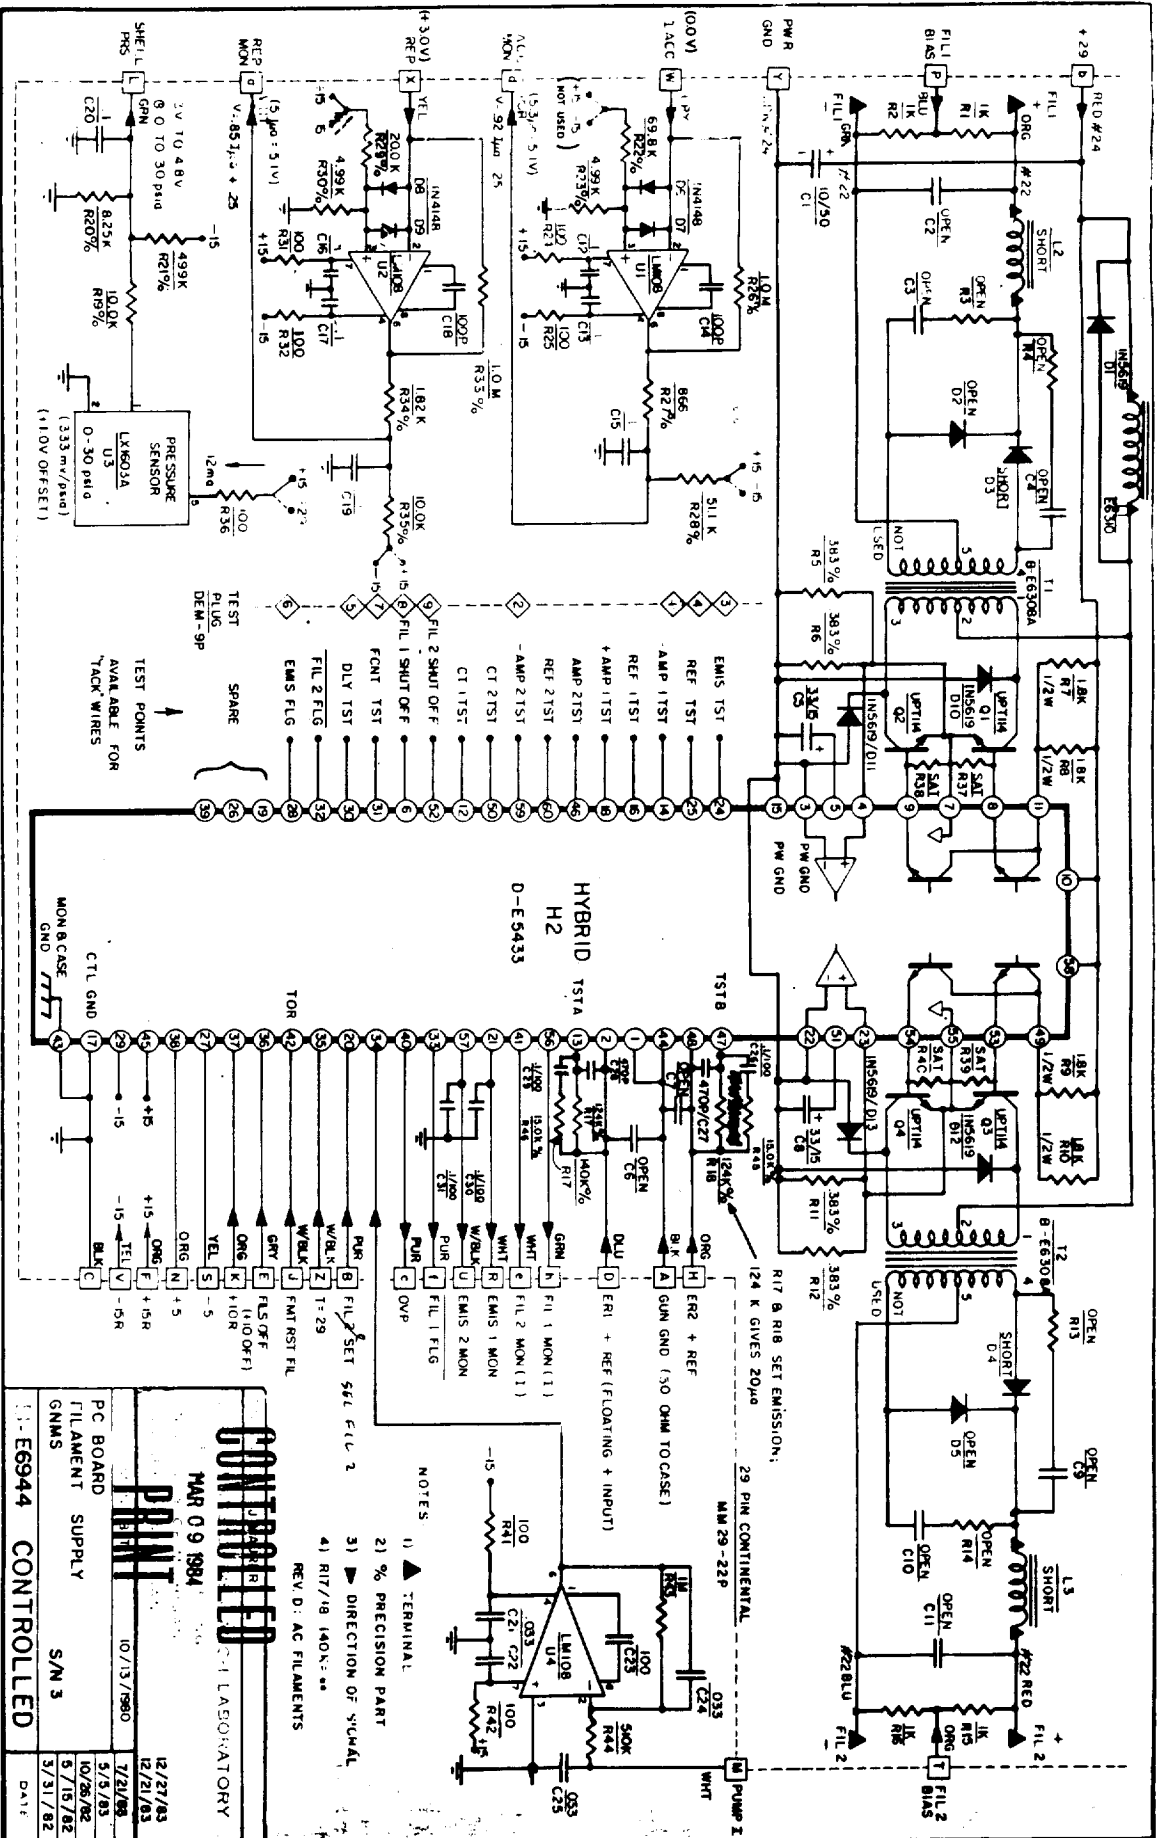


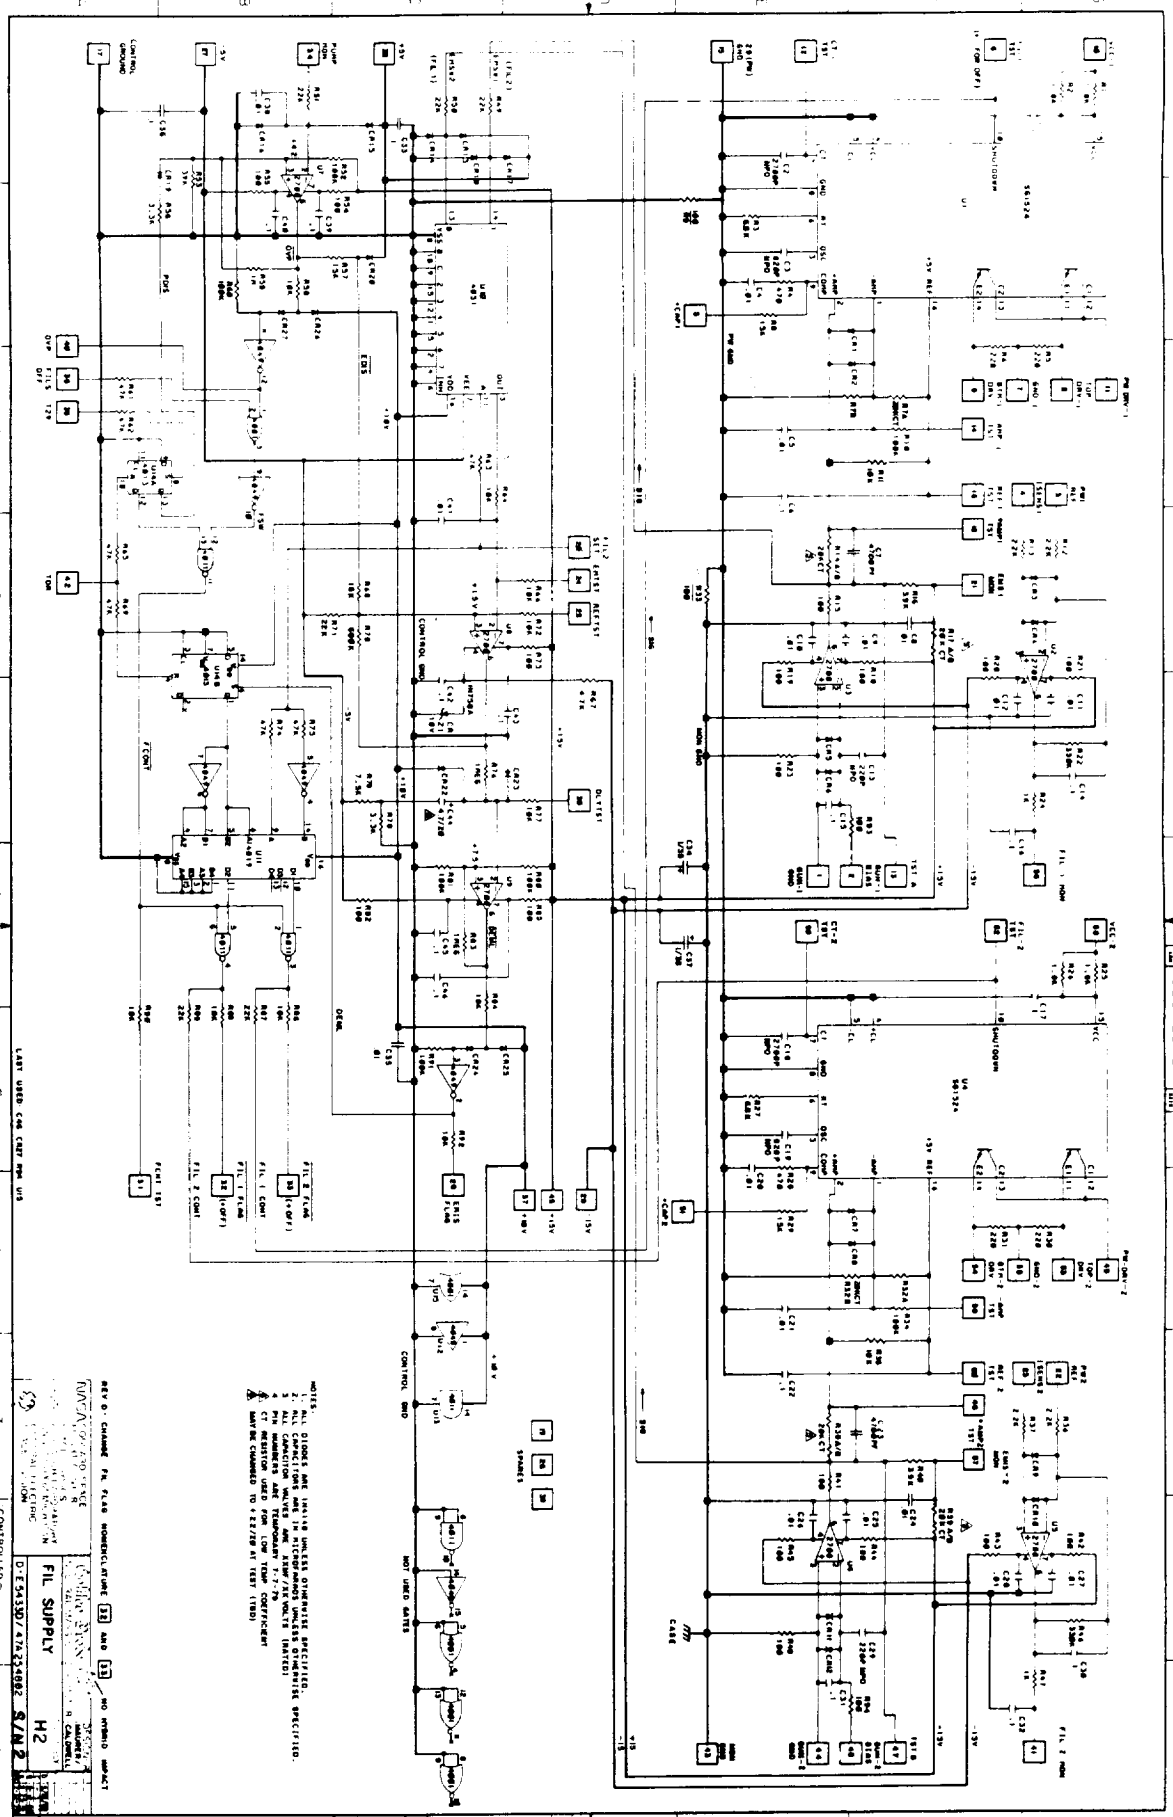

FIL SUPPLY H2
D-54330/4723-1082 S/N 2
CONTROLLED 2
SEP 9 1982 153


NOTES:
47A254802

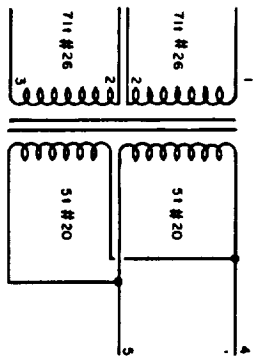

ASSEMBLY NOTES

1. WIND 1/2 OF PRIMARY ON 1/2 OF CORE (71 TURNS). DO THE SAME FOR OTHER HALF.
2. ADD SINGLE WOUND SECONDARIES EVENLY OVER (NOT WOUND BIFILAR) EACH PRIMARY. CONNECT IN PARALLEL.
3. WINDING WIRE TO BE USED FOR TRANSFORMER LEADS AND SOLDERED DIRECTLY TO P.C. BOARD.
4. TEST PER TEST PROCEDURE. RECORD RESULTS.
5. COAT WITH EPON 828/VERSAMID 125 EPOXY IN VACUUM PER POTTING PROCEDURE.
6. TEST PER TRANSFORMER TEST PROCEDURE. RECORD RESULTS.
7. ATTACH TO P.C. BOARD PER SKETCH AND BOND ALL SURFACES WITH EPOXY.

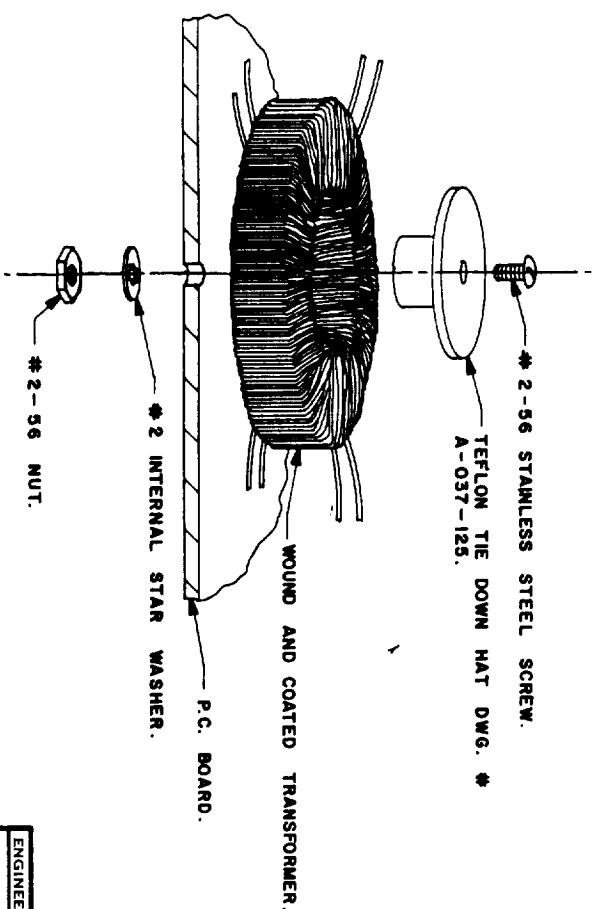

CONTROLLED

PHOTO

REV. B: PARALLEL SECONDARY & 41
REV. A: REVISE SECONDARY TO SINGLE WINDING FOR AC OPERATION

ENGINEER J. MAURER	DRAFTSMAN TS/8T	5/10/79
SPACE PHYSICS RESEARCH LABORATORY	TI/T2 TRANSFORMERS	
COLLEGE OF ENGINEERING	FILAMENT SUPPLY	
UNIVERSITY OF MICHIGAN	8MS	1/24/84
ANN ARBOR, MICHIGAN	S/N 2	5/3/83
	B-E6308B CONTROLLED	DATE

132 uhy/10001

$$L = \frac{N^2}{1000^2} \times L_{1000} = 53 \text{ uhy}$$

25 % DOWN AT 13 OERSTEDS

$$I \text{ FOR } 75 \% L = \frac{H_c}{.4 \pi N} = 1.2 \text{ A}$$


173 uhy/10001

$$L = \frac{N^2}{1000^2} \times L = 156 \text{ uhy}$$

25 % DOWN AT 11 OERSTEDS

$$I \text{ FOR } 75 \% L = \frac{H_c}{.4 \pi N} = 1.2 \text{ A}$$


(REF. ARNOLD PC-104E PG 18 & 69)

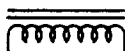

20 TURNS #26

L1

ARNOLD
A369132-2
OD = .380"
u = 250

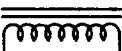

30 TURNS #22

L2/L3

ARNOLD
A391173-2
OR
GSFC/VIKING
SV73030-7E
OD = .655"
u = 300

NOTES:

1) WIRE EVENLY DISTRIBUTED AROUND
CORE. BANK WOUND. DO NOT CROSS ENDS.


2) CORES TO BE BONDED TO PC BOARD
WITH EPOXY.

3) MEASURE AND RECORD L, Q, AND R

ENGINEER J. MAURER	DRAFTSMAN B.T.	10/3/80
SPACE PHYSICS RESEARCH LABORATORY	INDUCTORS	
COLLEGE OF ENGINEERING	FILAMENT SUPPLY	
UNIVERSITY OF MICHIGAN	6NMS	12-2-80
ANN ARBOR, MICHIGAN	B-E6310 CONTROLLED	DATE


LAST USED R C D L



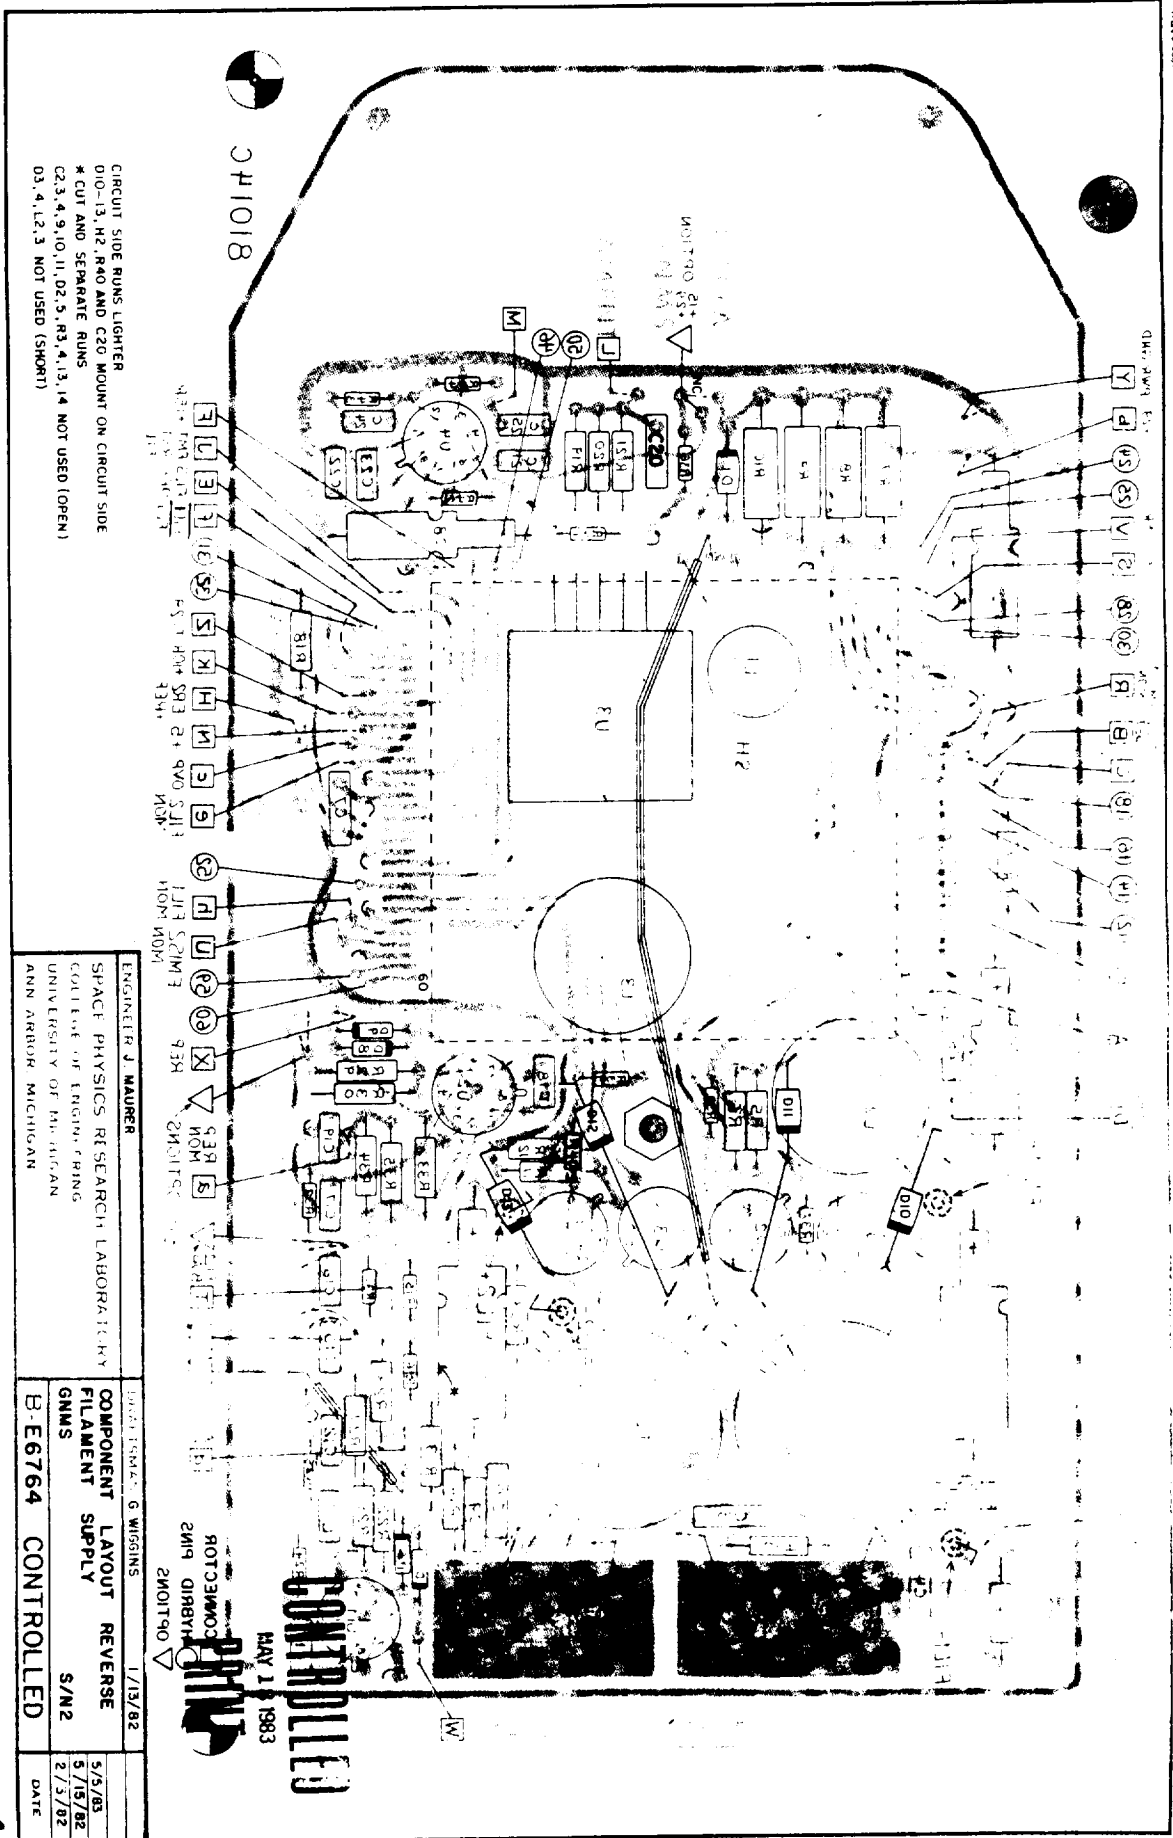

CIRCUIT SIDE RUNS LIGHTER
 010-13, H2, R40 AND C20 MOUNT ON CIRCUIT SIDE
 * CUT AND SEPARATE RUNS
 C2,3,4,9,10,11,02,5, R3,4,13, 14 NOT USED (OPEN)
 03,4, L2,3 NOT USED (SHORT)

ENGINEER J. MAURER		DATE: 1/15/82	
SPACE PHYSICS RESEARCH LABORATORY		COMPONENT LAYOUT REVERSE	
COLLEGE OF ENGINEERING		FILAMENT SUPPLY	
UNIVERSITY OF MICHIGAN		S/N2	
ANN ARBOR MICHIGAN		B-E6764 CONTROLLED	
		DATE	

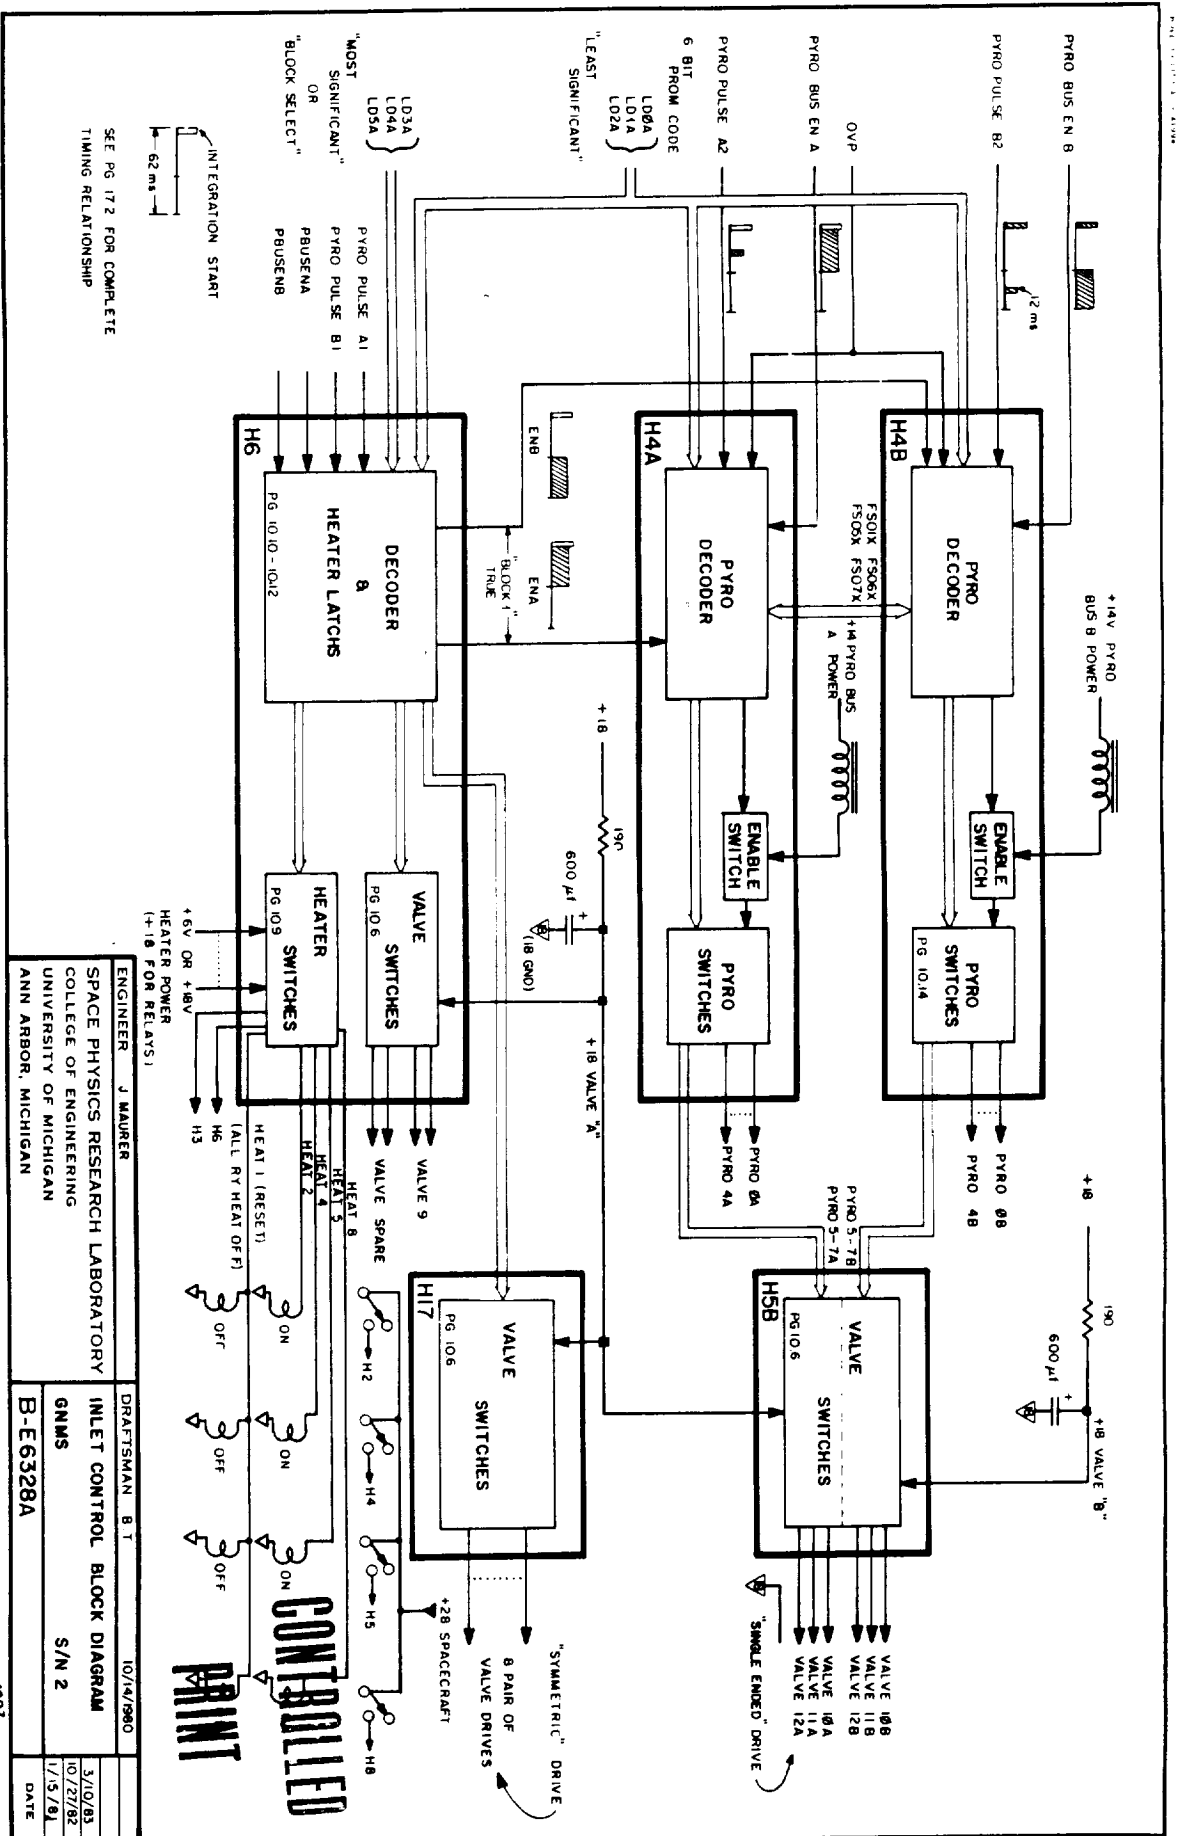

SEE PG 172 FOR COMPLETE
TIMING RELATIONSHIP

ENGINEER J MAURER
SPACE PHYSICS RESEARCH LABORATORY
COLLEGE OF ENGINEERING
UNIVERSITY OF MICHIGAN
ANN ARBOR, MICHIGAN


DRAFTSMAN	B T	10/14/89
INLET CONTROL BLOCK DIAGRAM		
GNMS	S/N 2	
B-E6328A		

3/10/83
10/27/82
1/15/81
DATE

LAST USED R C D L

MAR 24 1983

10.1

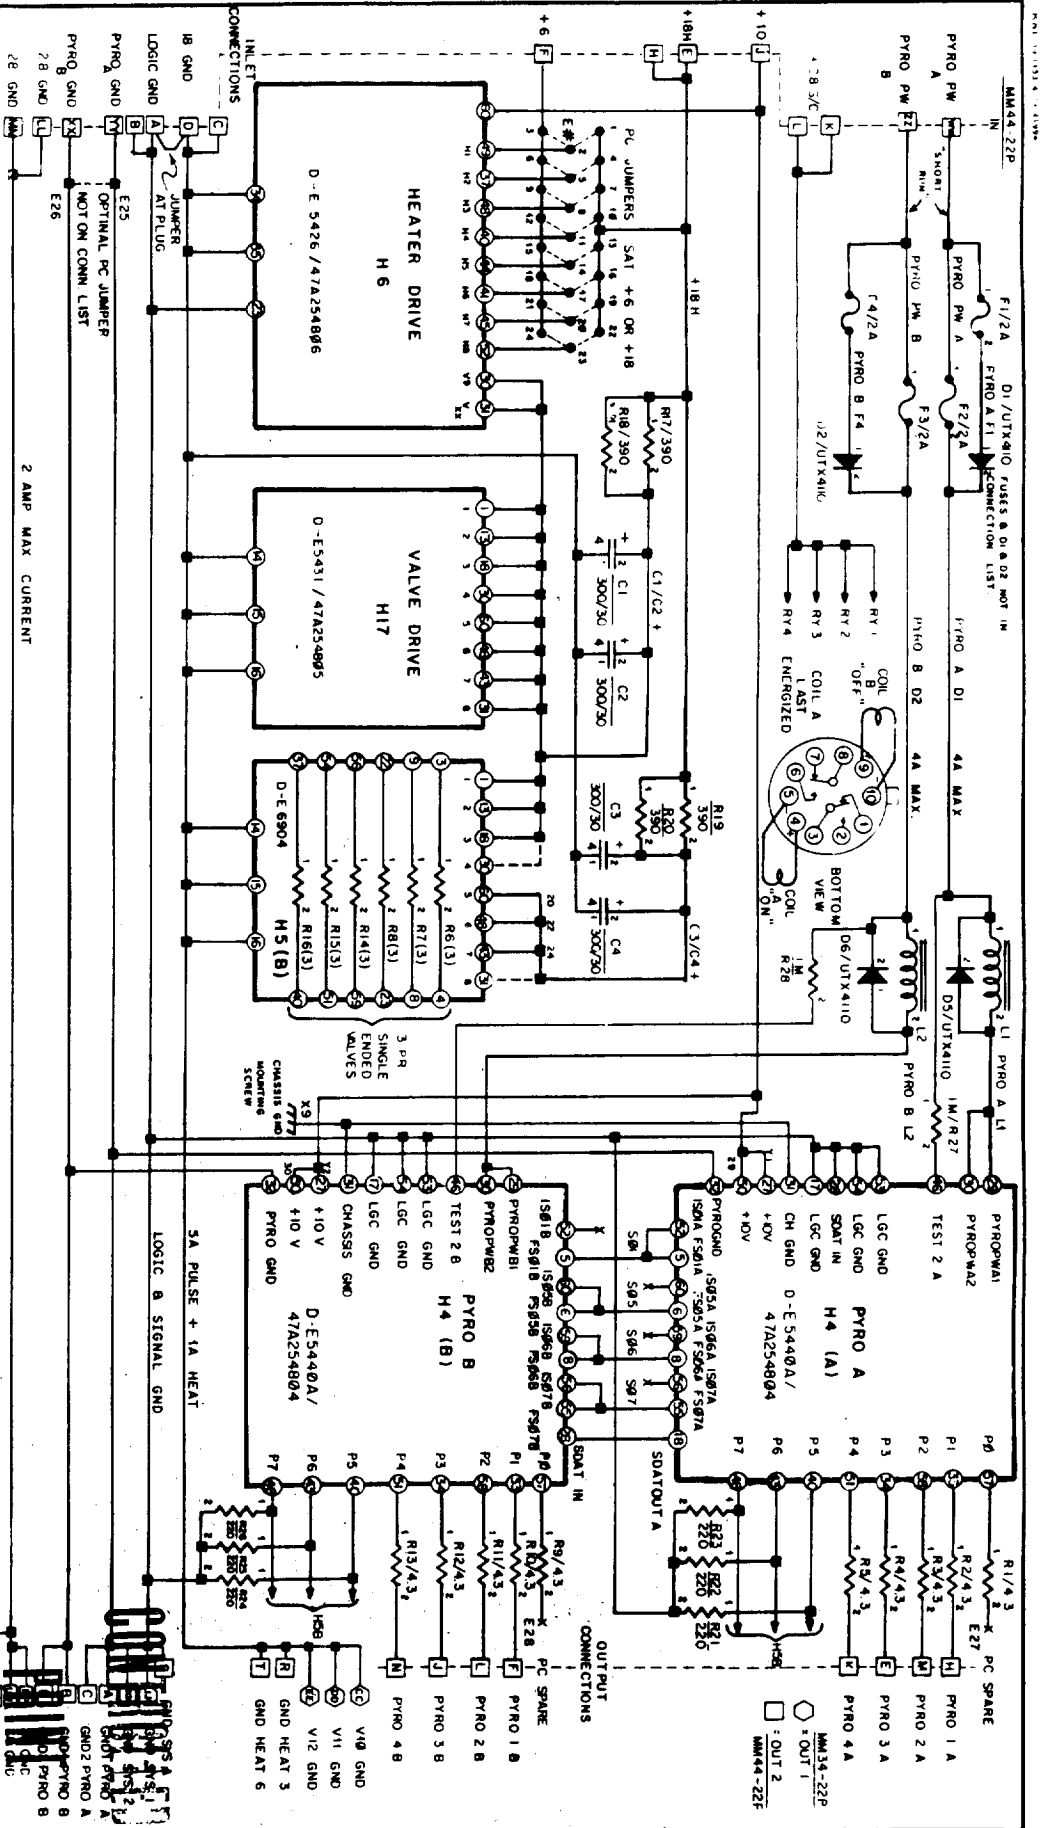

- 1) REFER TO INLET CONNECTION LIST FOR ALL POINT-TO-POINT RUNS. E 5803 & E 5804
- 2) THIS DRAWING DUPLICATES A PART OF INLET CONNECTION LIST.
- 3) R6, R7, R8, R99, R100
- 4) THIS DRAWING REPLACES E 5804.
- 5) D7-DI NOT SHOWN (1M4148)
- 6) L1, L2 ARE 75T # 28 ON A8759-2 CODE


03 & 04 NOT USED

LAST USED R28 C4 D11 F4 L2

MAR 24 1983


10.3A

ENGINEER: J MAURER	DRAFTSMAN: MSB/RT 10/6/80
SPACE PHYSICS RESEARCH LABORATORY	INLET PC BOARD CONNECTIONS
COLLEGE OF ENGINEERING	GNMS
UNIVERSITY OF MICHIGAN	PAGE 1 OF 2
ANN ARBOR, MICHIGAN	S/N: 3
	DATE: 6/1/82
	CONTROLLED
	DATE: 6/1/82

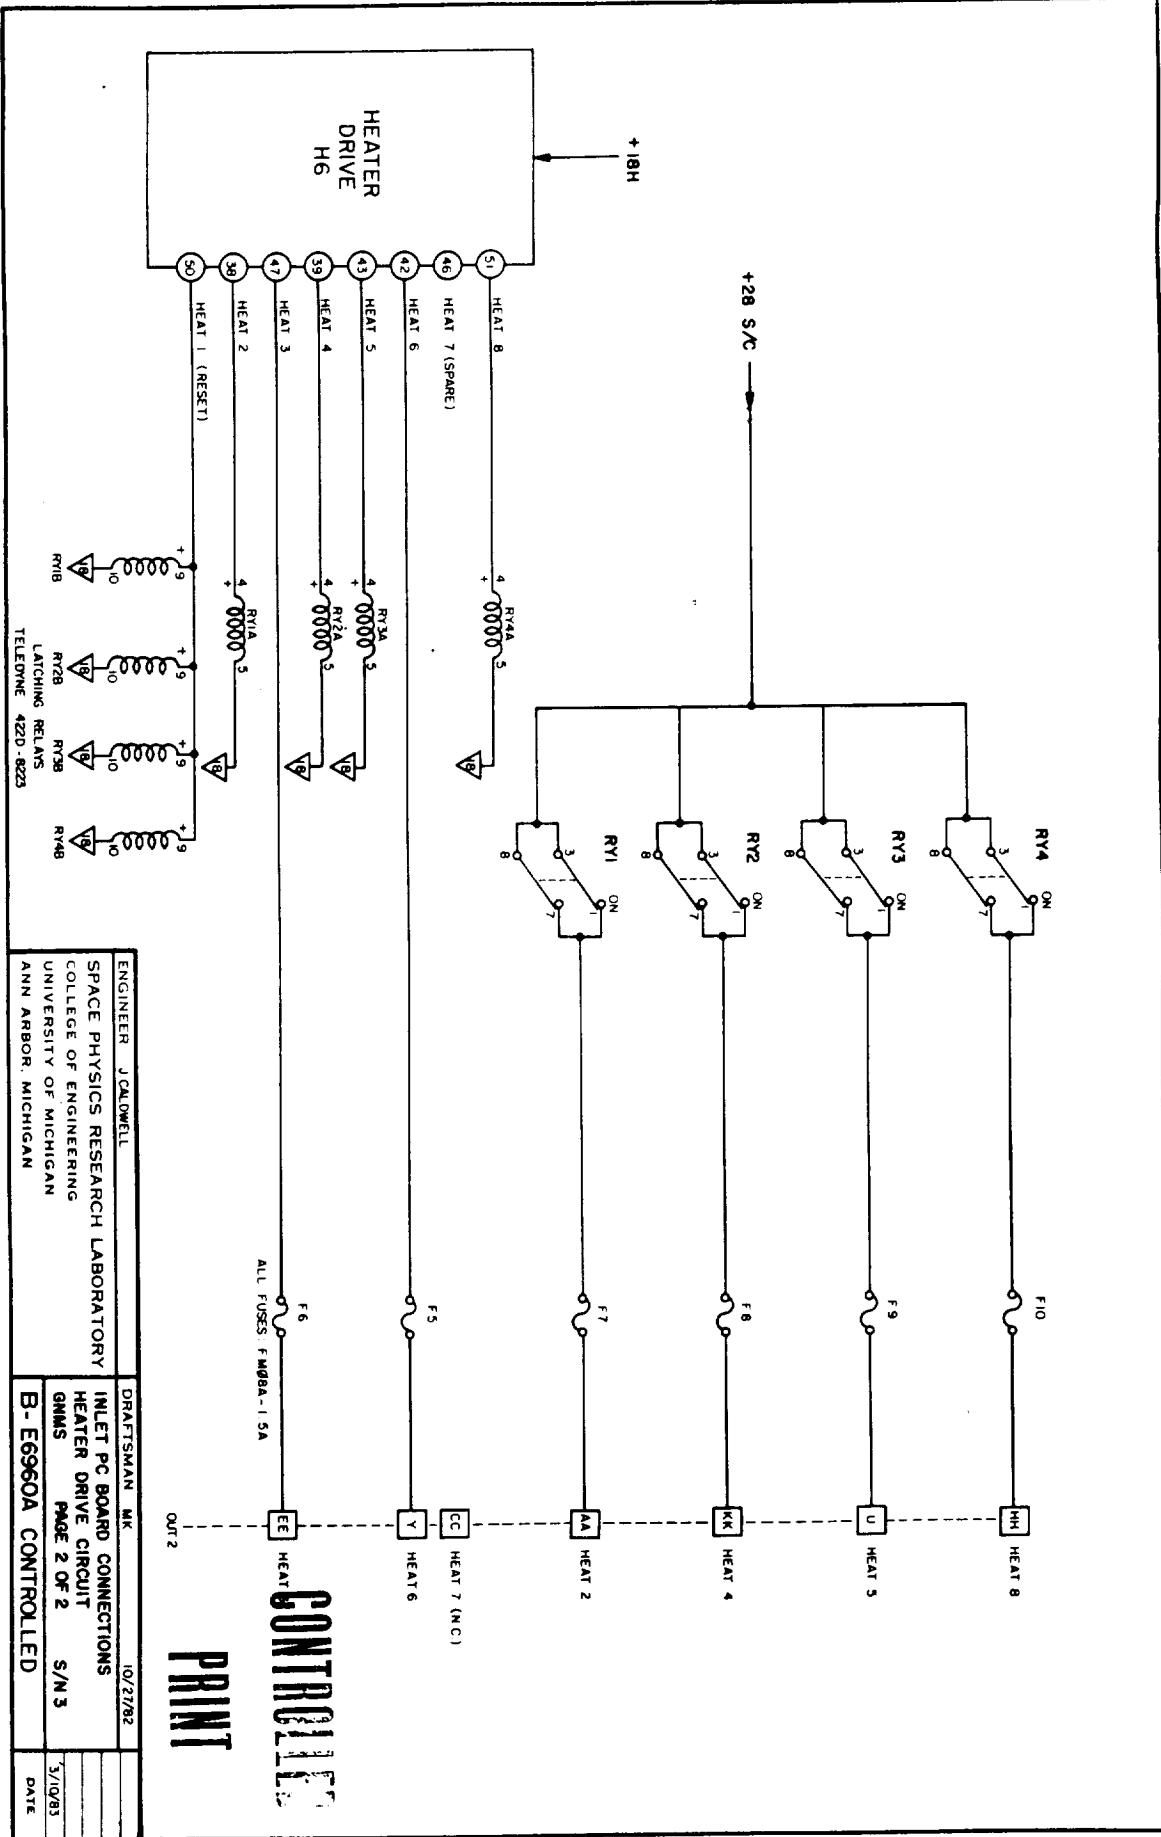

ENGINEER J CALDWELL	DRAFTSMAN MK	10/27/82
SPACE PHYSICS RESEARCH LABORATORY	INLET PC BOARD CONNECTIONS	
COLLEGE OF ENGINEERING	HEATER DRIVE CIRCUIT	
UNIVERSITY OF MICHIGAN	GNMS PAGE 2 OF 2	S/N 3
ANN ARBOR, MICHIGAN	B-E6960A CONTROLLED	DATE

MAR 24 1983 10.3B

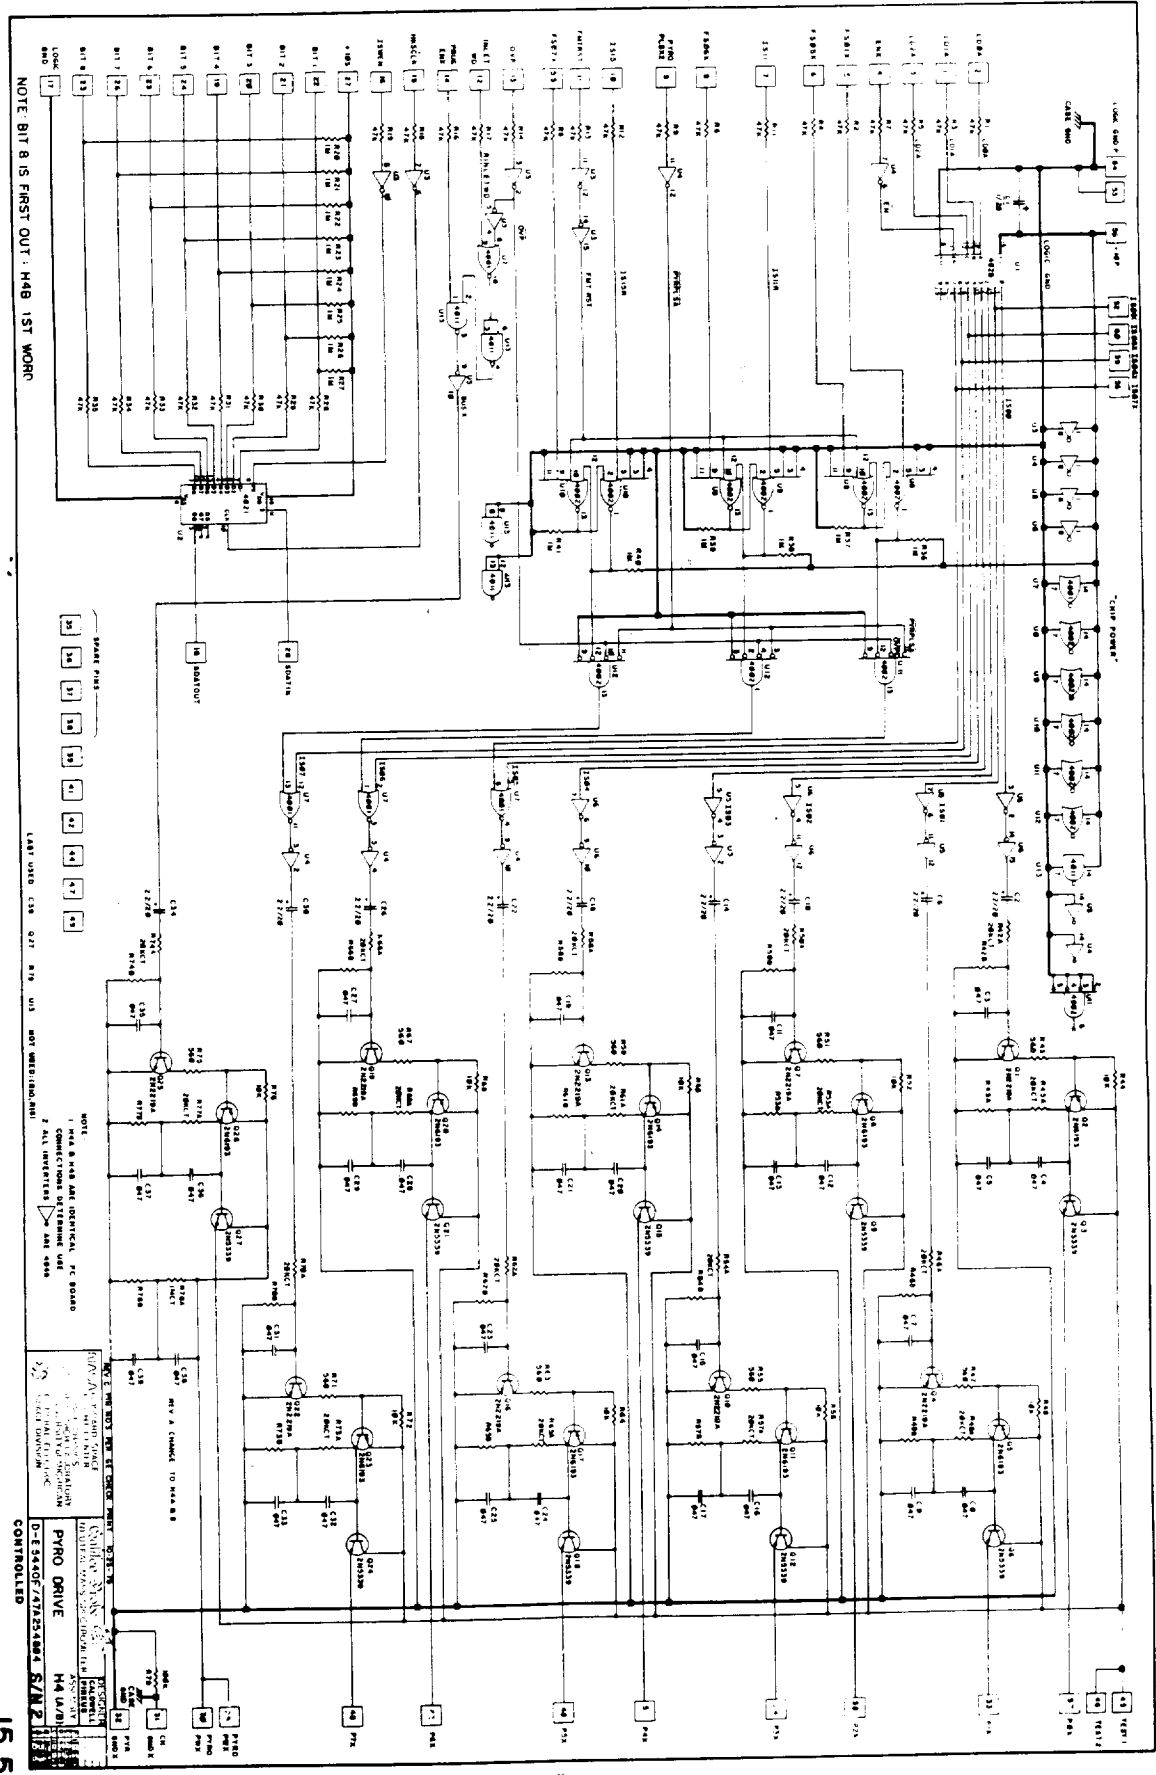


SEP 9 1982

15.5



CONTROLLED

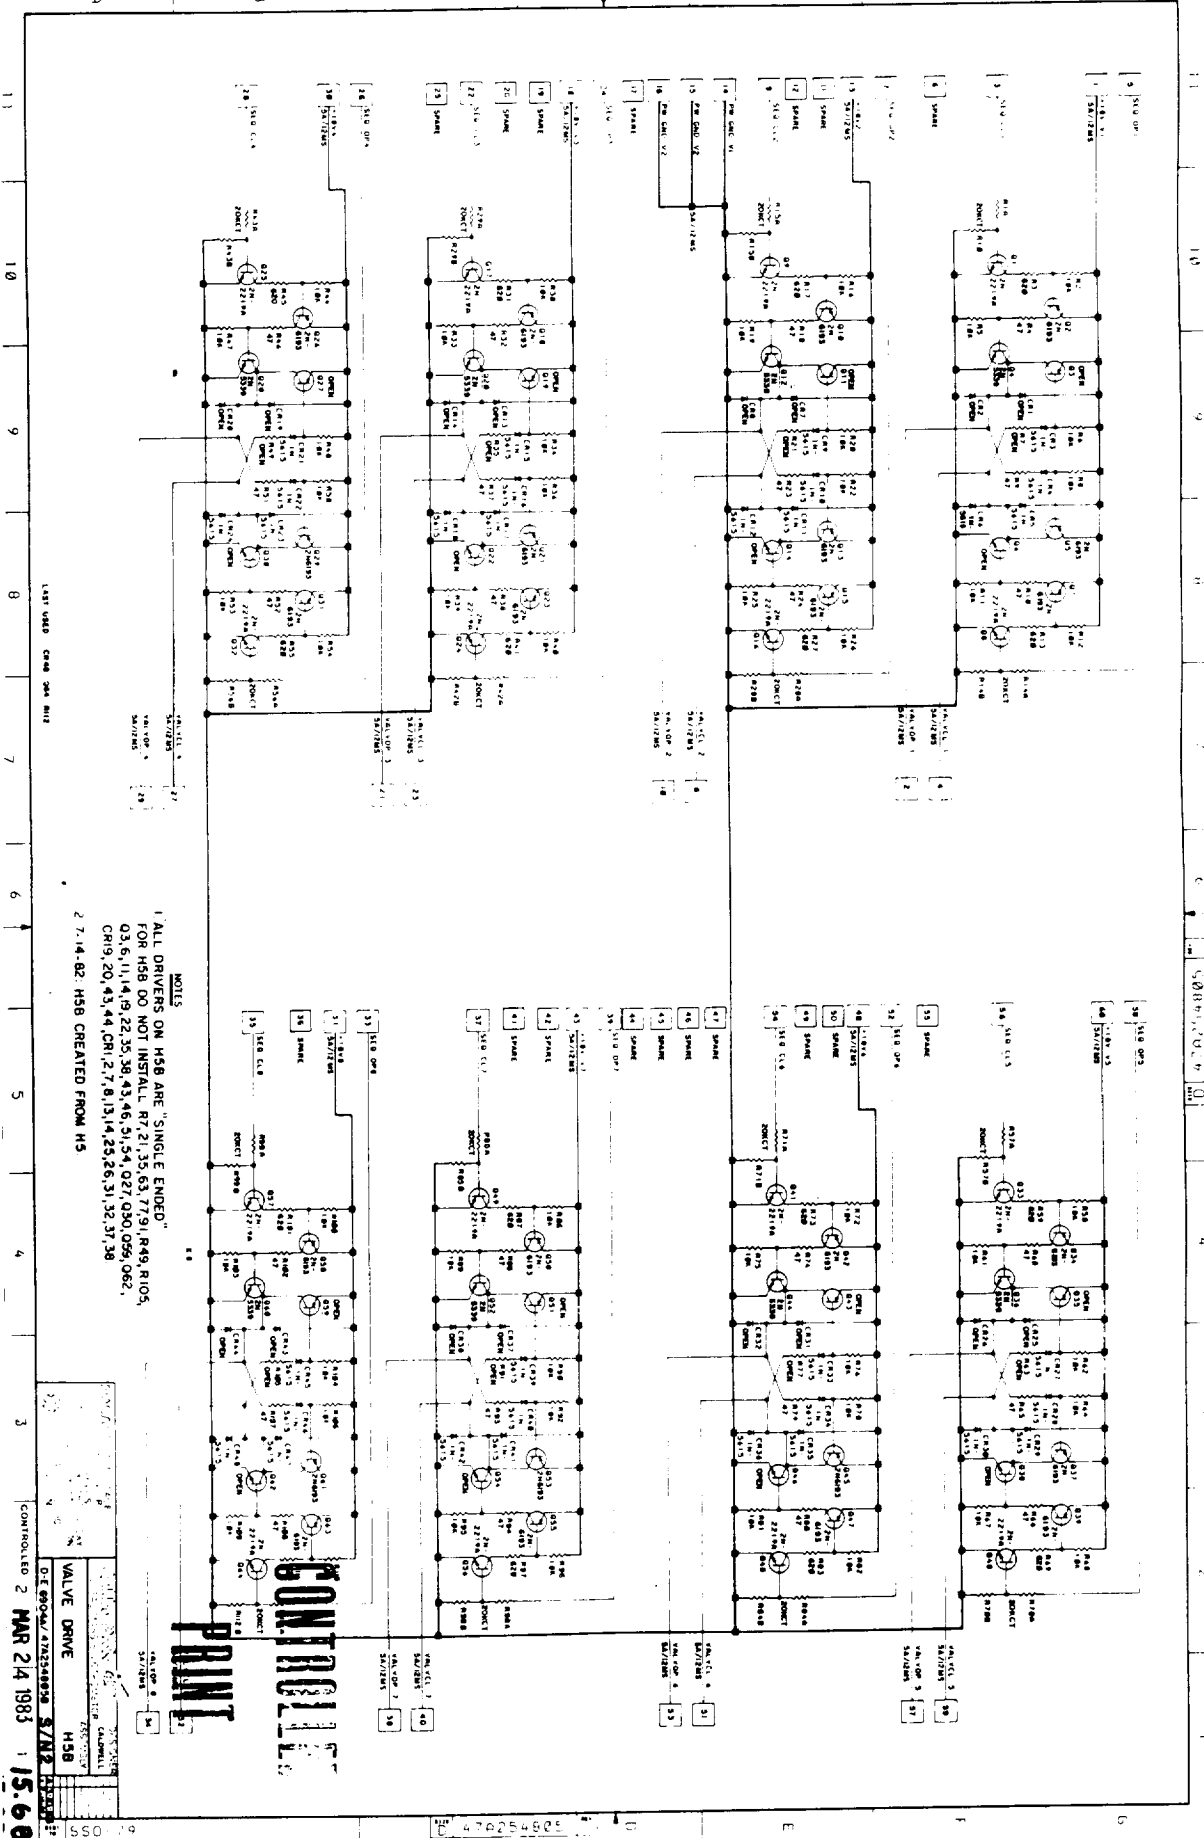

NOTES
1 ALL DRIVERS ON HSB ARE "SINGLE ENDED"
FOR HSB DO NOT INSTALL R7,21,35,63,77,91,94,9,105,
03,6,11,14,19,22,35,38,43,46,51,54,027,030,055,067,
CR19,20,43,44,CR1,2,7,8,13,14,25,26,31,32,37,38
2 7-14-82 HSB CREATED FROM HS

CONTROL POINT
VALVE DRIVE
HSB
D.E. 890-44/476248858 3/82 HSB
MAR 24 1983 15:68

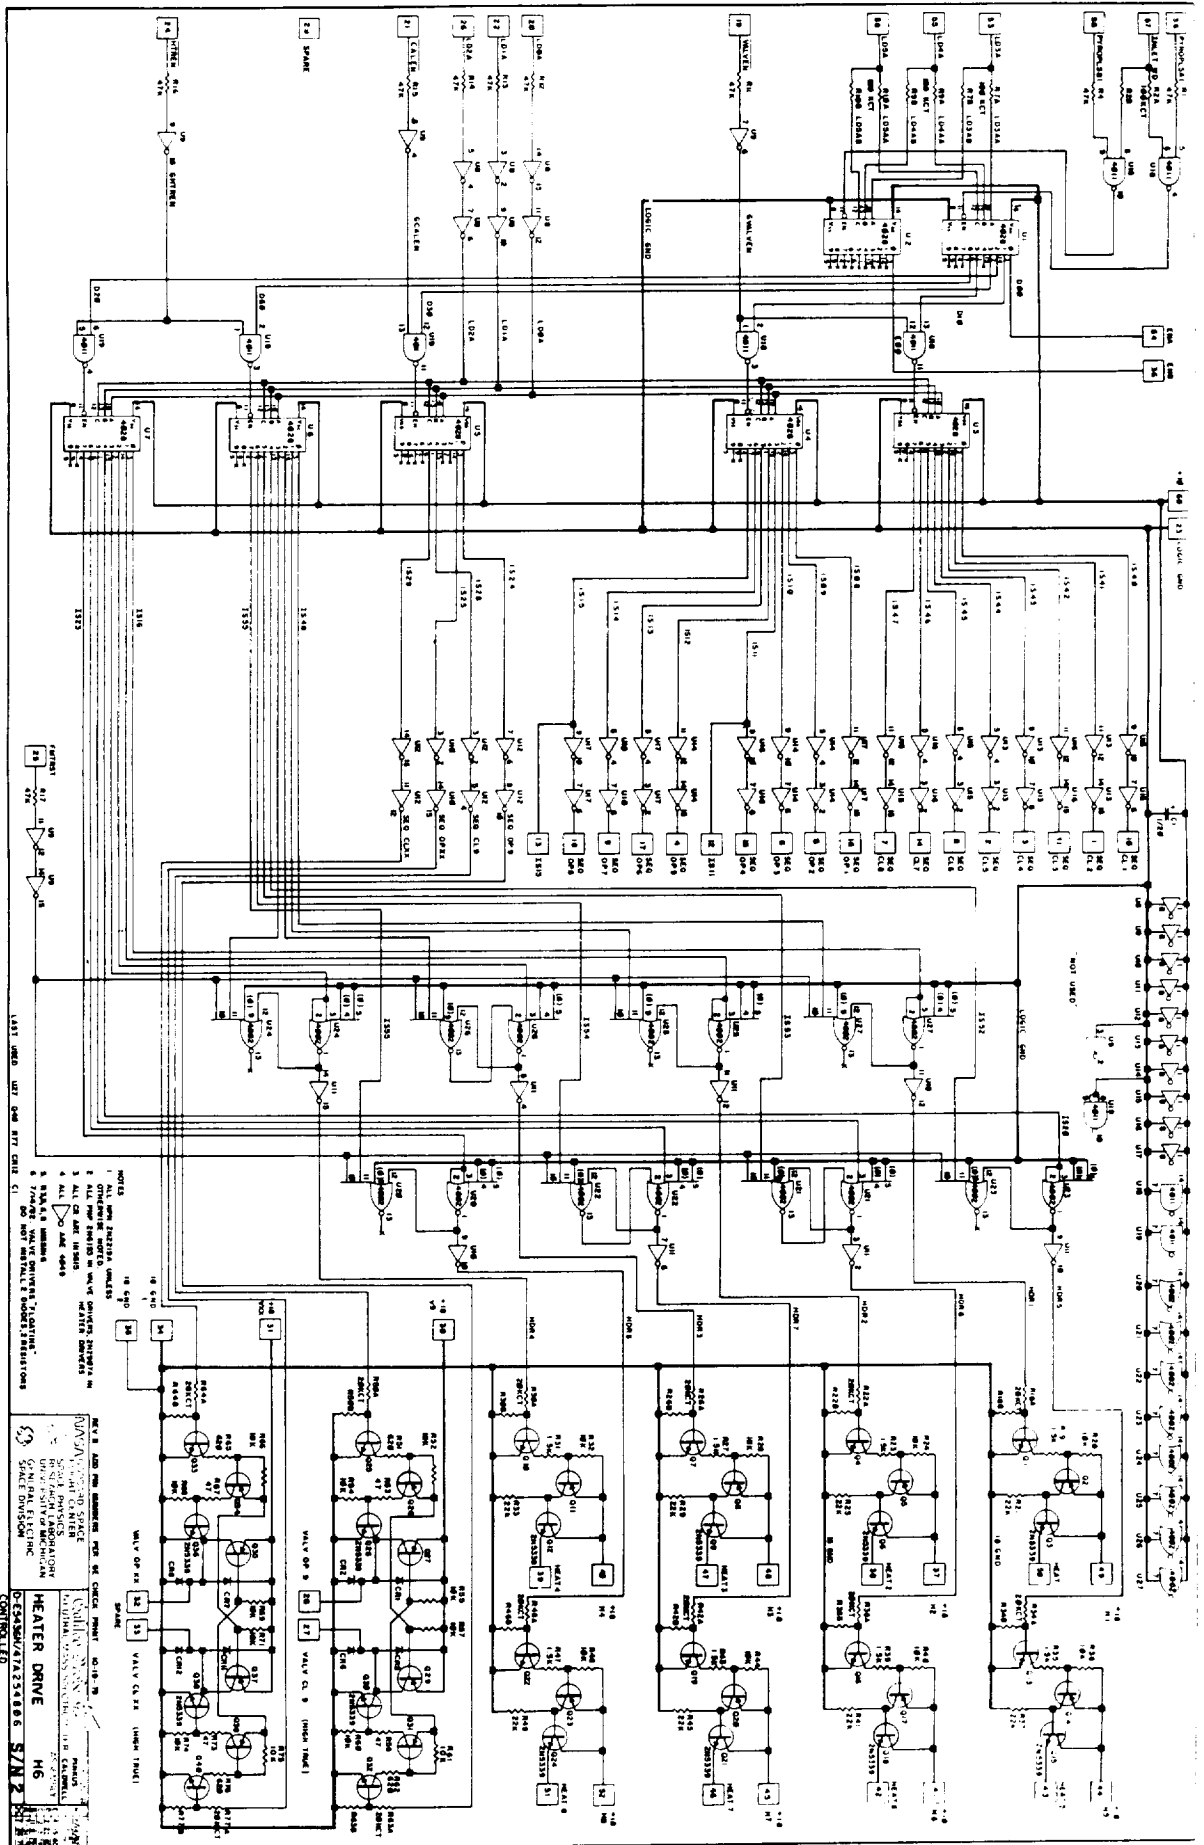

SEP 9 1982 157

[illegible]

*Page 1 of 14		*PCL BOARD INPUT PLUG...44 PIN	*INPUT FROM MAIN HARNESS
ED	IN	IN	INPUT
ED	1	1/22/81	
ED	2	1/22/81	
ED	3	18 GND	
ED	4	18 GND	
ED	5	+18 H	
ED	6	+18 H	
ED	7	+18 H	
ED	8	+10V	
ED	9	+28 S/C	
ED	10	+28 S/C	
ED	11	LD4A	
ED	17	PROG.SA1	
ED	18	PROG.SB1	
ED	19	PROG.SB2	
ED	37	PROG.SB2	
ED	38	PROG.SB2	
ED	39	PROG.SB2	
ED	40	PROG.SB2	
ED	41	PROG.SB2	
ED	42	PROG.SB2	
ED	43	PROG.SB2	
ED	44	PROG.SB2	

[illegible][illegible]

PAGE 4 of 14		
1	MMA	PMO A
2	LDIA	
3	LDMA	
4	LDZA	
5	EA R	
6	SDI	


FILE: IUTNS.PIN DISK: GNMS-1			
ENGINEER	J. MAURER	DRAFTSMAN	
SPACE PHYSICS RESEARCH LABORATORY		INLET BOARD CONNECTIONS	
COLLEGE OF ENGINEERING		1 OF 3	
UNIVERSITY OF MICHIGAN		S/M2	
ANN ARBOR, MICHIGAN		B-E5803C CONTROLLED	
LAST USED R C D L		DATE 3/10/83	

*Page 5 of 14	
1	HEATER DRIVE HYBRID -B*

ENGINEER J. MAURER		DRAFTSMAN	
SPACE PHYSICS RESEARCH LABORATORY		INLET BOARD CONNECTIONS	
COLLEGE OF ENGINEERING		2 OF 3	
UNIVERSITY OF MICHIGAN		S/N2	
ANN ARBOR, MICHIGAN		B-E5804C CONTROLLED	
LAST USED R C D L		DATE	

Page 5 of 14									
RELAYS... (Relays 10-5, 422, Latches, w/spreader pads) Pins are 04 from Tab. Bottom view. (Tab = pin 10). Do to confusion in Engineering board, this detailed input file:									
ED	R1	HEATER 2							
1	HEAT 2								

ENGINEER: J. MAURER		DRAFTSMAN	
SPACE PHYSICS RESEARCH LABORATORY		INLET BOARD CONNECTIONS	
COLLEGE OF ENGINEERING		3 OF 3	
UNIVERSITY OF MICHIGAN		S/N2	
ANN ARBOR, MICHIGAN		B-E6392C CONTROLLED	
		DATE	

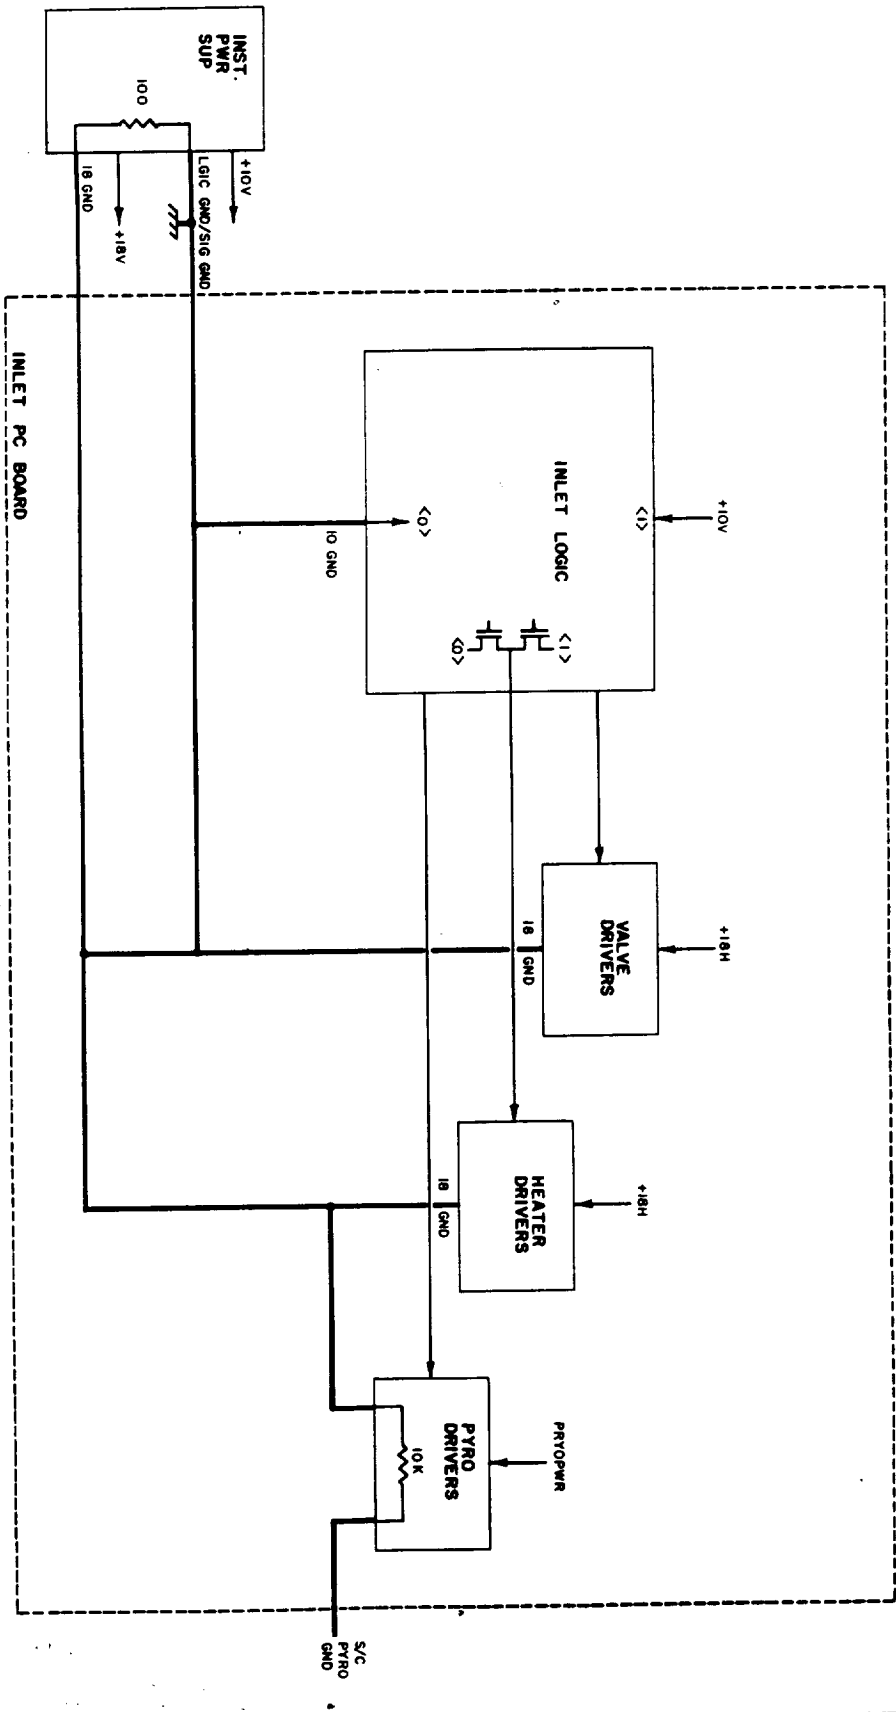

ENGINEER	J. MAHER	4-5-79	DRAFTSMAN	TS	4-17-79
SPACE PHYSICS RESEARCH LABORATORY					
COLLEGE OF ENGINEERING					
UNIVERSITY OF MICHIGAN					
ANN ARBOR, MICHIGAN					
GROUNDING PLAN			H4, H5, H6		
INLET SYSTEM			GALILEO - NMS		
B-E 5231					
DATE					

LAST USED R C D L

INLET SYSTEM FUNCTION TABLE REV 3 9-17-81 WP/JM

OCTAL SWITCHES ON LOGIC TEST BOX

NUMBER	CODE	FUNCTION
0	000	00PYRO #0 (NOT USED) (TODAY)
1	01PYRO #1 (INLET 1) (ENABLE BC1)	
2	02PYRO #2 (INLET 2)	
3	03PYRO #3 (OUTLET 1)	
4	04PYRO #4 (OUTLET 2)	
5	05VALVE #10 CL (BC 1)	
6	06VALVE #11 CL (BC 2)	
7	07VALVE #12 CL (BC 3)	

8	001	10VALVE #1 OPEN
9		11VALVE #2 OPEN
10		12VALVE #3 OPEN
11		13VALVE #4 OPEN (ENABLE BC 2)
12		14VALVE #5 OPEN
13		15VALVE #6 OPEN
14		16VALVE #7 OPEN
15		17VALVE #8 OPEN (ENABLE BC 3)

16	010	20RY HTRS OFF
17		21HEATER #2 ON (RY)
18		22HEATER #3 ON
19		23HEATER #4 ON (RY)
20		24HEATER #5 ON (RY)
21		25HEATER #6 ON
22		26HEATER #7 ON (SPARE)
23		27HEATER #8 ON (RY)

24	011	30VALVE #9 OPEN
25		31VALVE SPARE OPEN
26		32NO OPERATION
27		33NO OPERATION
28		34VALVE #9 CLOSE
29		35VALVE SPARE CLOSE
30		36NO OPERATION
31		37NO OPERATION

32	100	40NO OPERATION
33		41NO OPERATION
34		42NO OPERATION
35		43NO OPERATION
36		44NO OPERATION
37		45NO OPERATION
38		46NO OPERATION
39		47NO OPERATION

40 101 50VALVE #1 CLOSE
 41 51VALVE #2 CLOSE
 42 52VALVE #3 CLOSE
 43 53VALVE #4 CLOSE
 44 54VALVE #5 CLOSE
 45 55VALVE #6 CLOSE
 46 56VALVE #7 CLOSE
 47 57VALVE #8 CLOSE

48 110 60NO OPERATION
 49 61NO OPERATION
 50 62HEATER #3 OFF
 51 63NO OPERATION
 52 64NO OPERATION
 53 65HEATER #6 OFF
 54 66HEATER SPARE OFF
 55 67NO OPERATION

56 111 70NO OPERATION
 57 71NO OPERATION
 58 72NO OPERATION
 59 73NO OPERATION
 60 74NO OPERATION
 61 75NO OPERATION
 62 76NO OPERATION
 63 77NO OPERATION

COMMAND BIT #2 (VALVEN) DISABLES CODES 001 & 101 (VOLATILE COMMAND)
 COMMAND BIT #3 (HTREN) DISABLES CODES 010 & 110 (VOLATILE COMMAND)
 COMMAND BIT #18 (CALEN) DISABLES CODE 011 (STORED COMMAND)

LABELS AGREE WITH B-E6142D (VALVE SCHEMATIC) REV 12-16-80 WP

END FILE:ISFUNC.TXT


ENGINEER	W PINKUS	DRAFTSMAN	MSG	8/23/79
SPACE PHYSICS RESEARCH LABORATORY				
COLLEGE OF ENGINEERING				
UNIVERSITY OF MICHIGAN				
ANN ARBOR, MICHIGAN				
INLET SYSTEM FUNCTION TABLE		GNMS		
B-E 5296				
DATE		9/19/79		
		8/23/79		
		6/16/79		

LAST USED R C D L

NO. SIGNAL	FILE PIN	NO. SIGNAL	FILE PIN	NO. SIGNAL	FILE PIN
1 +10V	J 27	12 +18 H8	H6 52	18 CELL 2 TMP	IN 15
	E-A 27		E 23		OUT1 15
	P4A 50	13 +28 S/C	IN K	19 CH GND	H4A 31
	H4B 27		IN L		H4B 31
	H4B 50		RY1 3	20 EN A	H4A 4
	H6 60		RY1 8		H4B 4
2 +18 C1/C2+	H17 1		RY2 3	21 EN B	H4B 54
	H17 13		RY2 8		H4B 4
	H17 18		RY3 3	22 FMTRST	H6 36
	H17 30		RY3 8		H4A 11
	H17 31		RY3 3		H4B 11
	H17 43		RY3 8		H4A 11
	H17 48	14 +6 H	IN F		H4B 25
	H17 60		RY1 3	23 HEAT 2	OUT2 AA
	H53 1		RY1 6		RY1 1
	H53 13		E 9	24 HEAT 3	OUT2 EE
	H53 18		E 12		OUT2 47
	H53 30		E 15	25 HEAT 4	OUT2 KK
	H6 30		E 18		RY2 1
	H6 31		E 21	RY2 21	RY2 7
	C1 2		E 24	26 HEAT 5	OUT2 U
	C1 2		IN C		RY3 1
	C2 2	15 18 GND	IN D		RY3 7
	R17 2		OUT1 CC	27 HEAT 6	OUT2 Y
	R18 2		OUT1 DD		H6 42
3 +18 C3/C4+	H58 43		OUT1 EE	28 HEAT 8	OUT2 HH
	H58 48		OUT2 R		RY3 1
	H58 60		OUT2 T	29 HEAT1 HYRB	RY3 7
	H58 60		OUT2 T		RY3 7
	C3 2		H17 14		RY3 7
	C4 2		H17 15		RY3 7
	P19 2		H17 16		RY3 9
	R20 2		H5B 14		RY3 9
	IN 2		H5B 15		RY3 9
4 +16 H	IN H		H5B 16		D7 2
	E 1		H6 34	30 HEAT2 HYRB	RY1 4
	E 4		H6 35		D8 2
	E 7		RY1 5		D8 2
	E 10		RY1 10	31 HEAT4 HYRB	RY2 4
	E 13		RY2 5		RY2 4
	E 16		RY2 10		D9 2
	E 19		RY3 5	32 HEAT5 HYRB	RY3 4
	E 22		RY3 10		D10 2
	R17 1		RY3 5		D10 2
	R18 1		RY3 10	33 HEAT8 HYRB	RY3 4
	R19 1		D7 1		D11 2
	R20 1		D8 1		D11 2
5 +18 H1	H6 49		D9 1	34 HXSCLK	IN JJ
	E 2		D10 1		H4A 15
6 +18 H2	H6 37		D11 1		H4B 15
	E 5		C1 1	35 HTREN-	IN DD
	H6 48		C2 1		H6 24
7 +18 H3	H6 48		C3 1		AA 24
	E 8		C4 1	36 INLETPD	IN AA
8 +18 H4	H6 40		C4 1		H4A 12
	E 11	16 28 GND	IN LL		B 12
9 +18 H5	H6 44		IN MM		H6 57
	E 14		OUT2 PP	37 IS11	H4A 7
10 +18 H6	H6 41		OUT2 SS		H4B 7
	H6 17		OUT2 UU		H6 12
11 +18 H7	H6 45	17 CELL 1 TMP	IN PP	38 IS15	H4A 10
	E 20		OUT1 LL		H4B 13

ENGINEER J. MAURER		DRAFTSMAN	
SPACE PHYSICS RESEARCH LABORATORY		NODE NAME LISTING Pg. 1 OF 2	
COLLEGE OF ENGINEERING		INLET PC	
UNIVERSITY OF MICHIGAN		GNMS	
ANN ARBOR, MICHIGAN		B-E6379C CONTROLLED	
LAST USED R C D L		DATE	

[illegible]

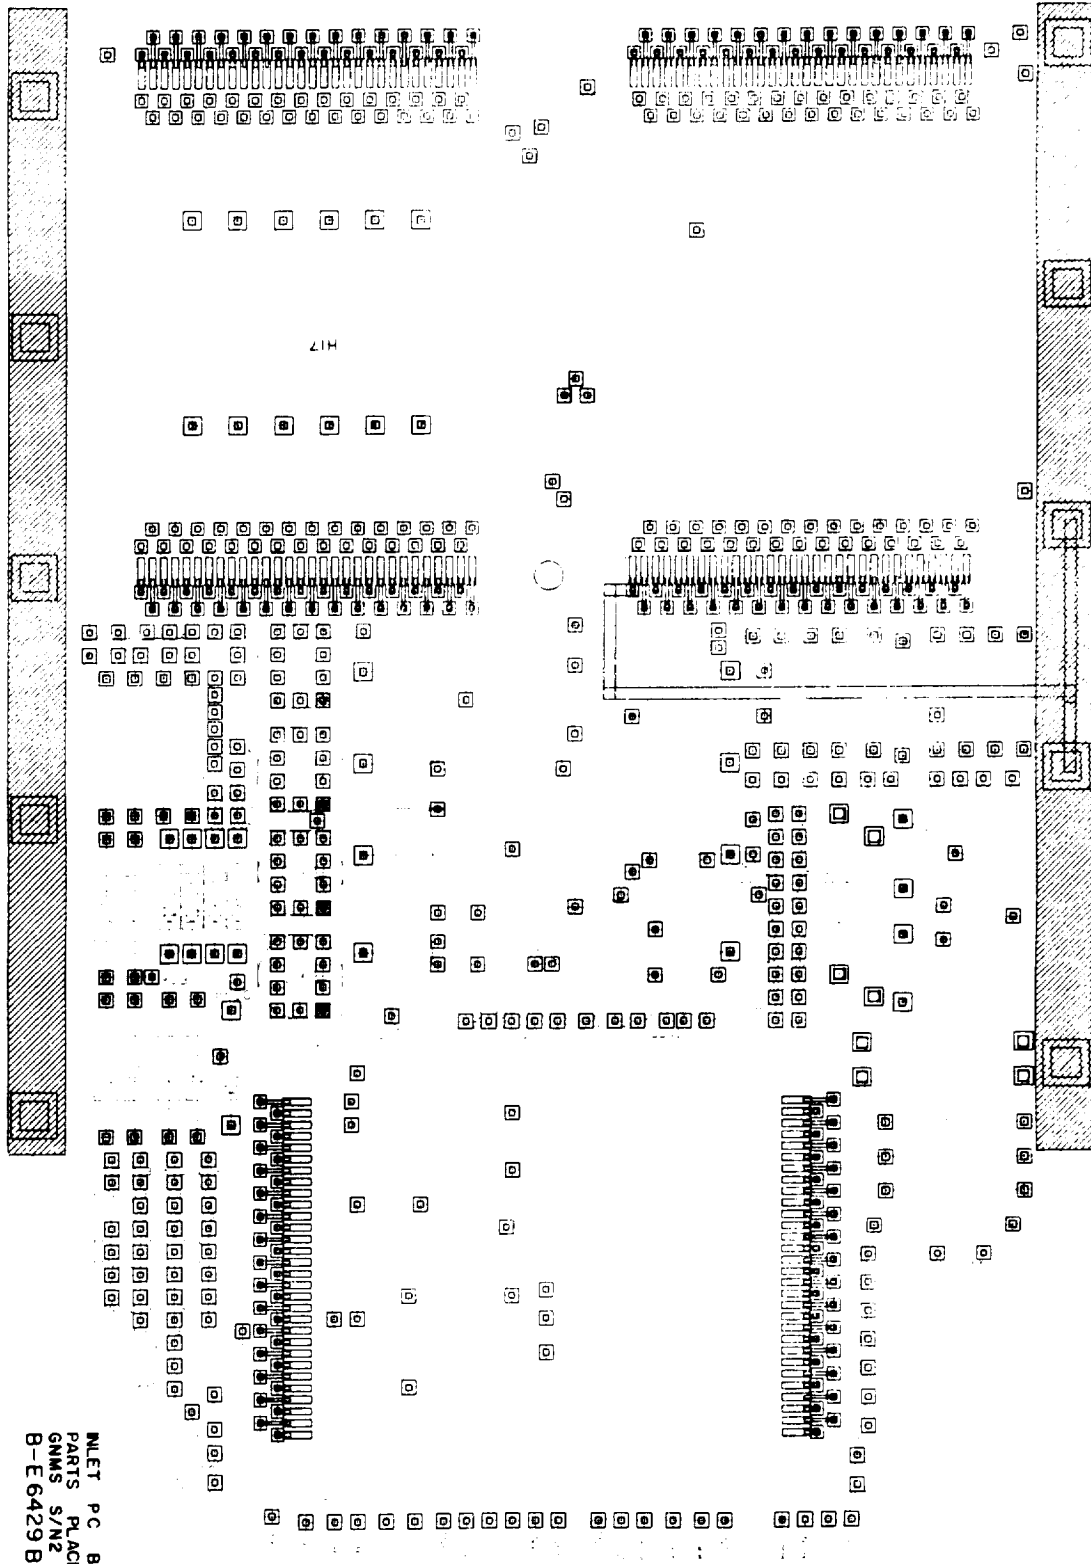

CONTROLLED
PRINT

D229390PCREVT
1APVBD, UNIC
12-10-81

NET PC BOARD
PARTS PLACEMENT A TOP
GNMS S/N2
B-E6429 B


10.21


MAR 24 1983

3/10/83


1007 465X E01: 11/17/00 by [unclear]

[illegible]

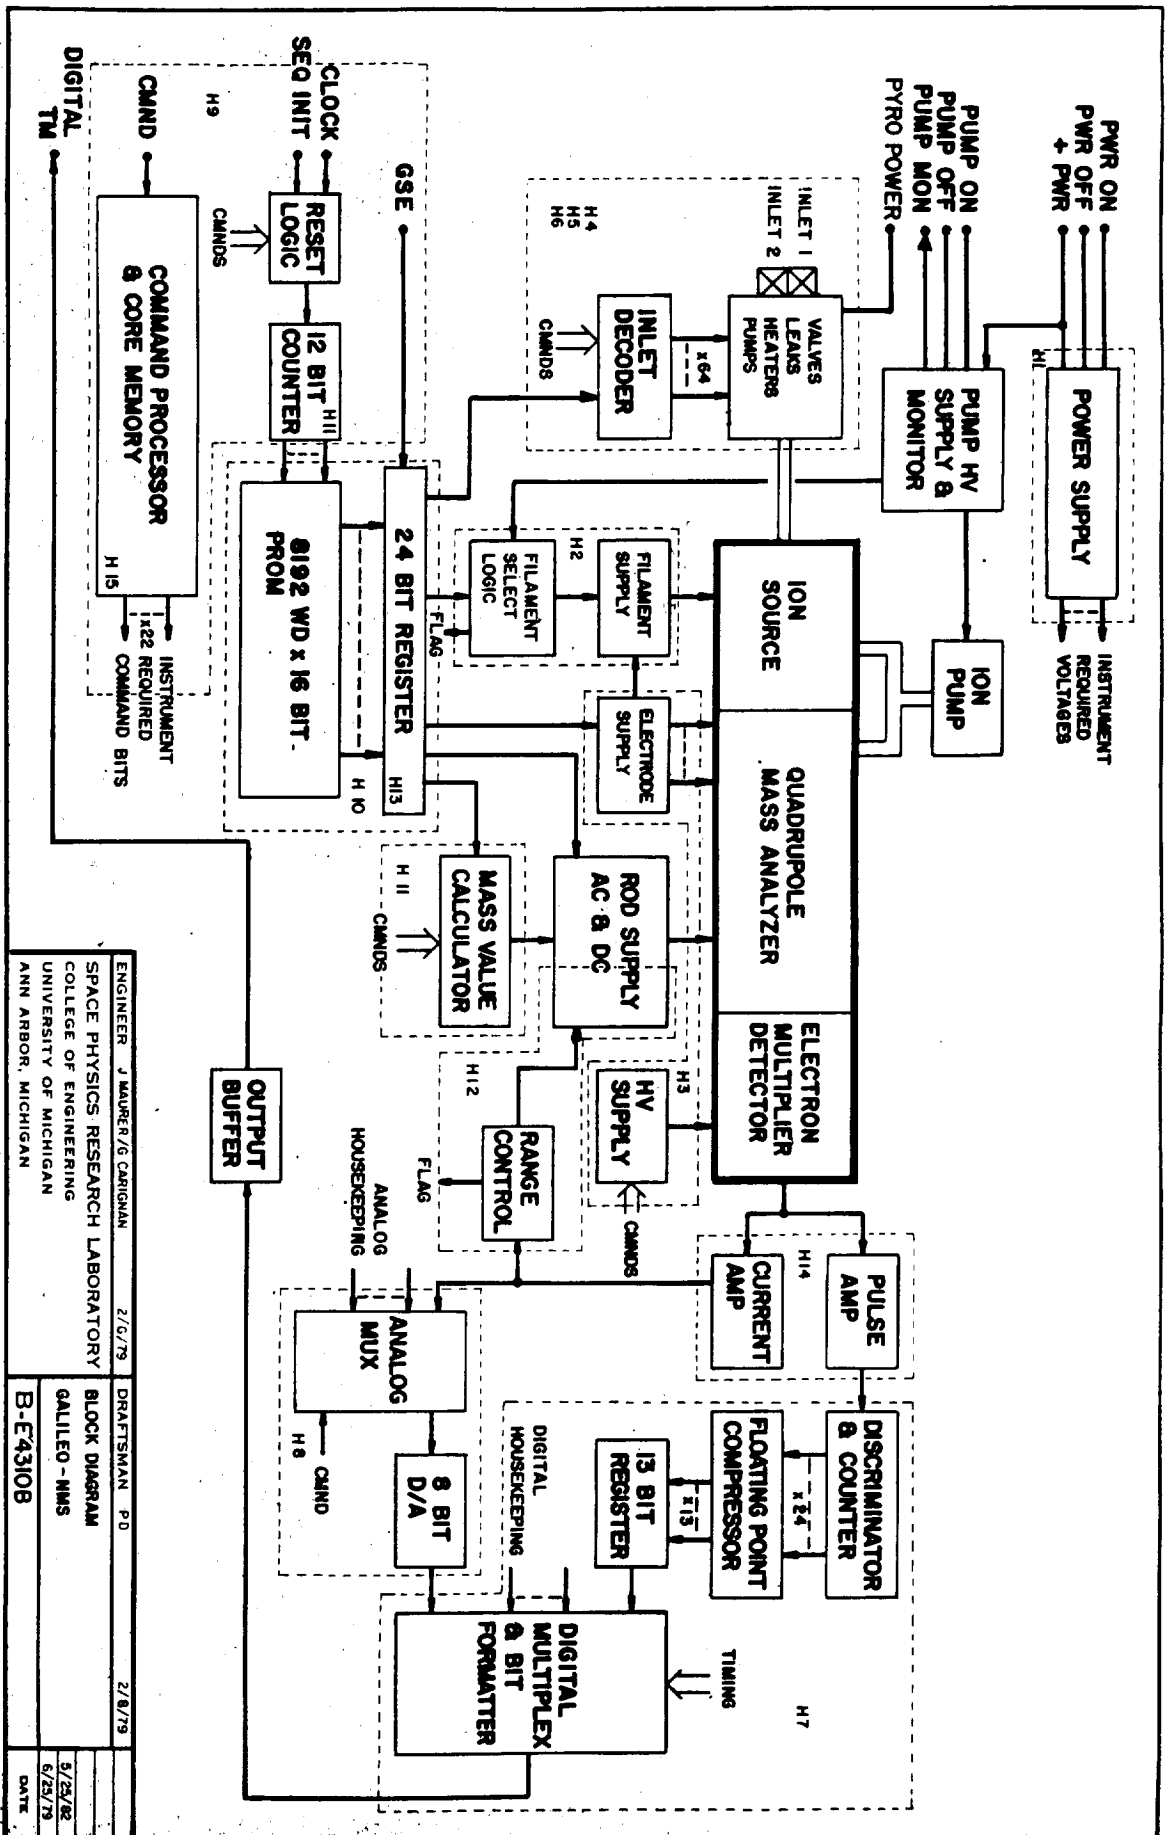

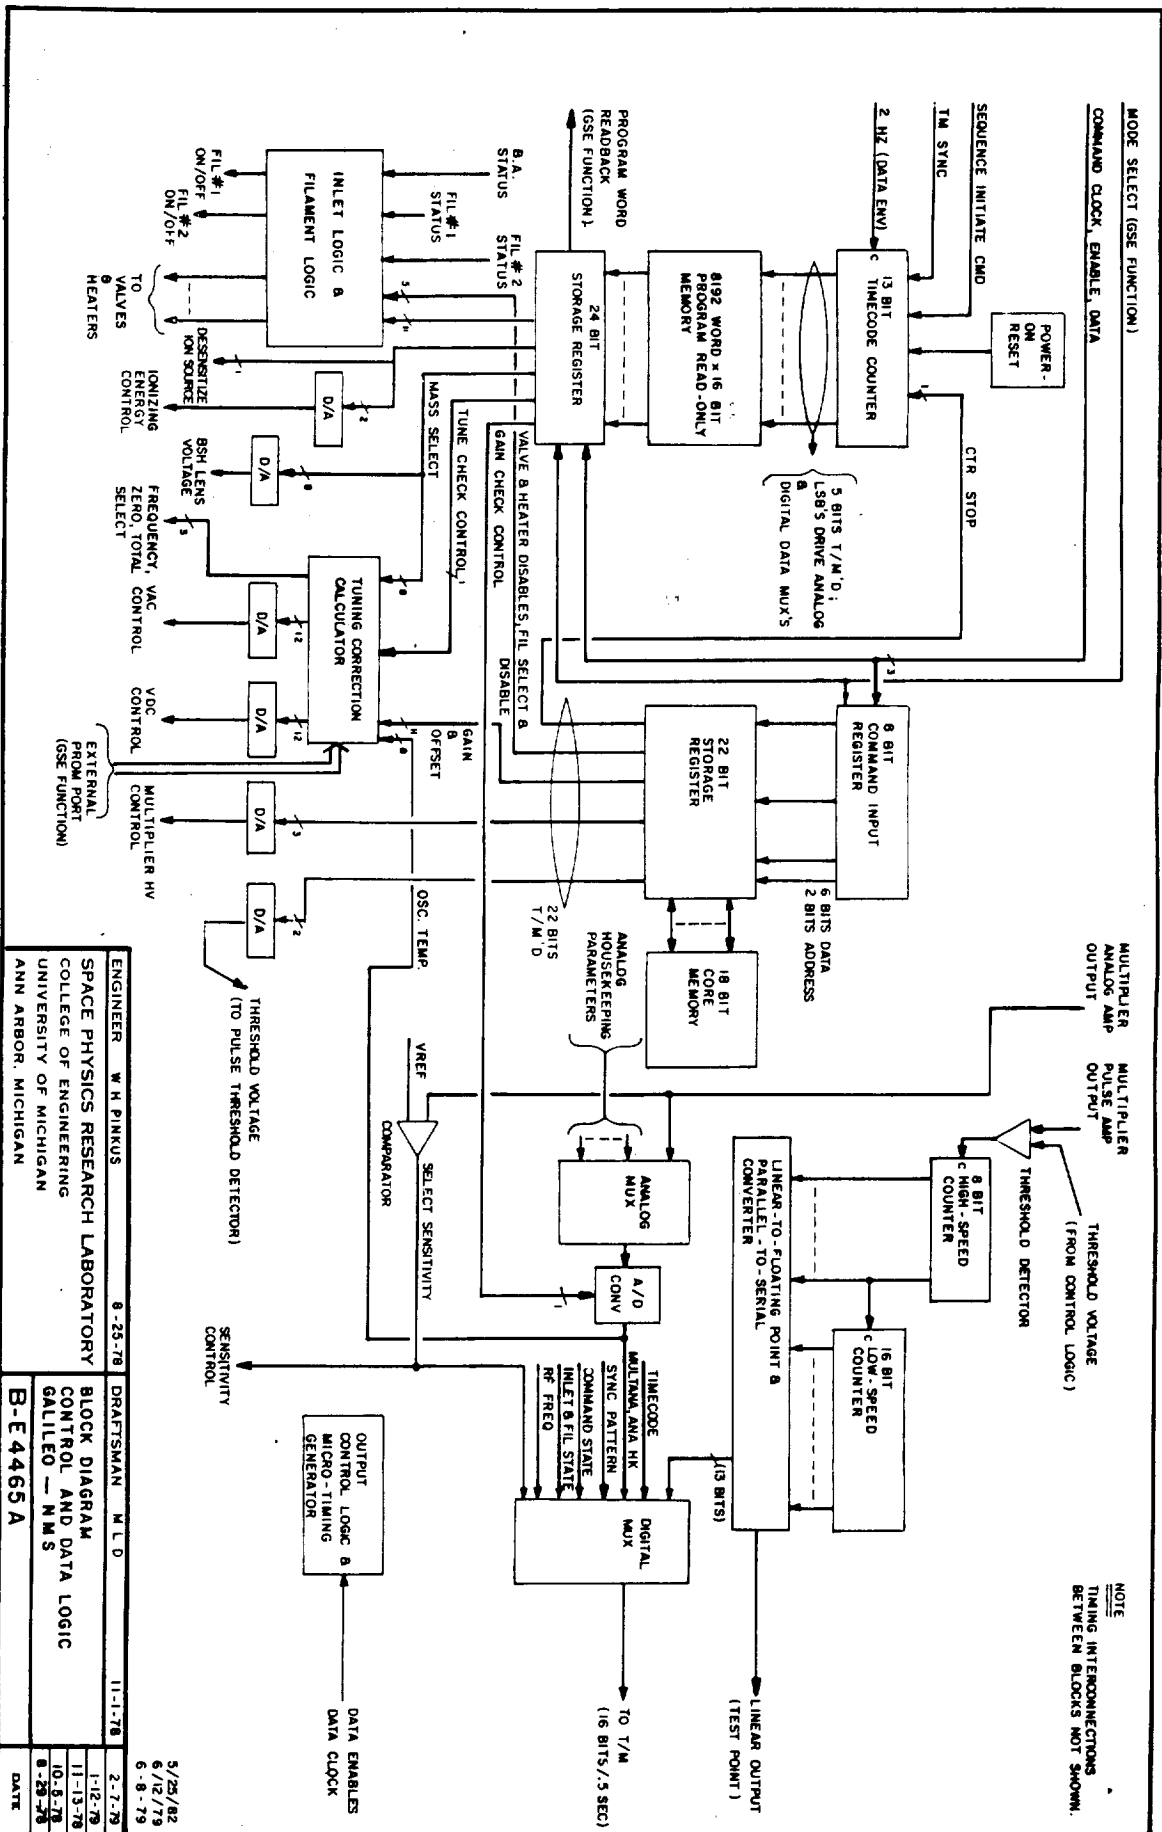


NOTE
 TIMING INTERCONNECTORS
 BETWEEN BLOCKS NOT SHOWN.

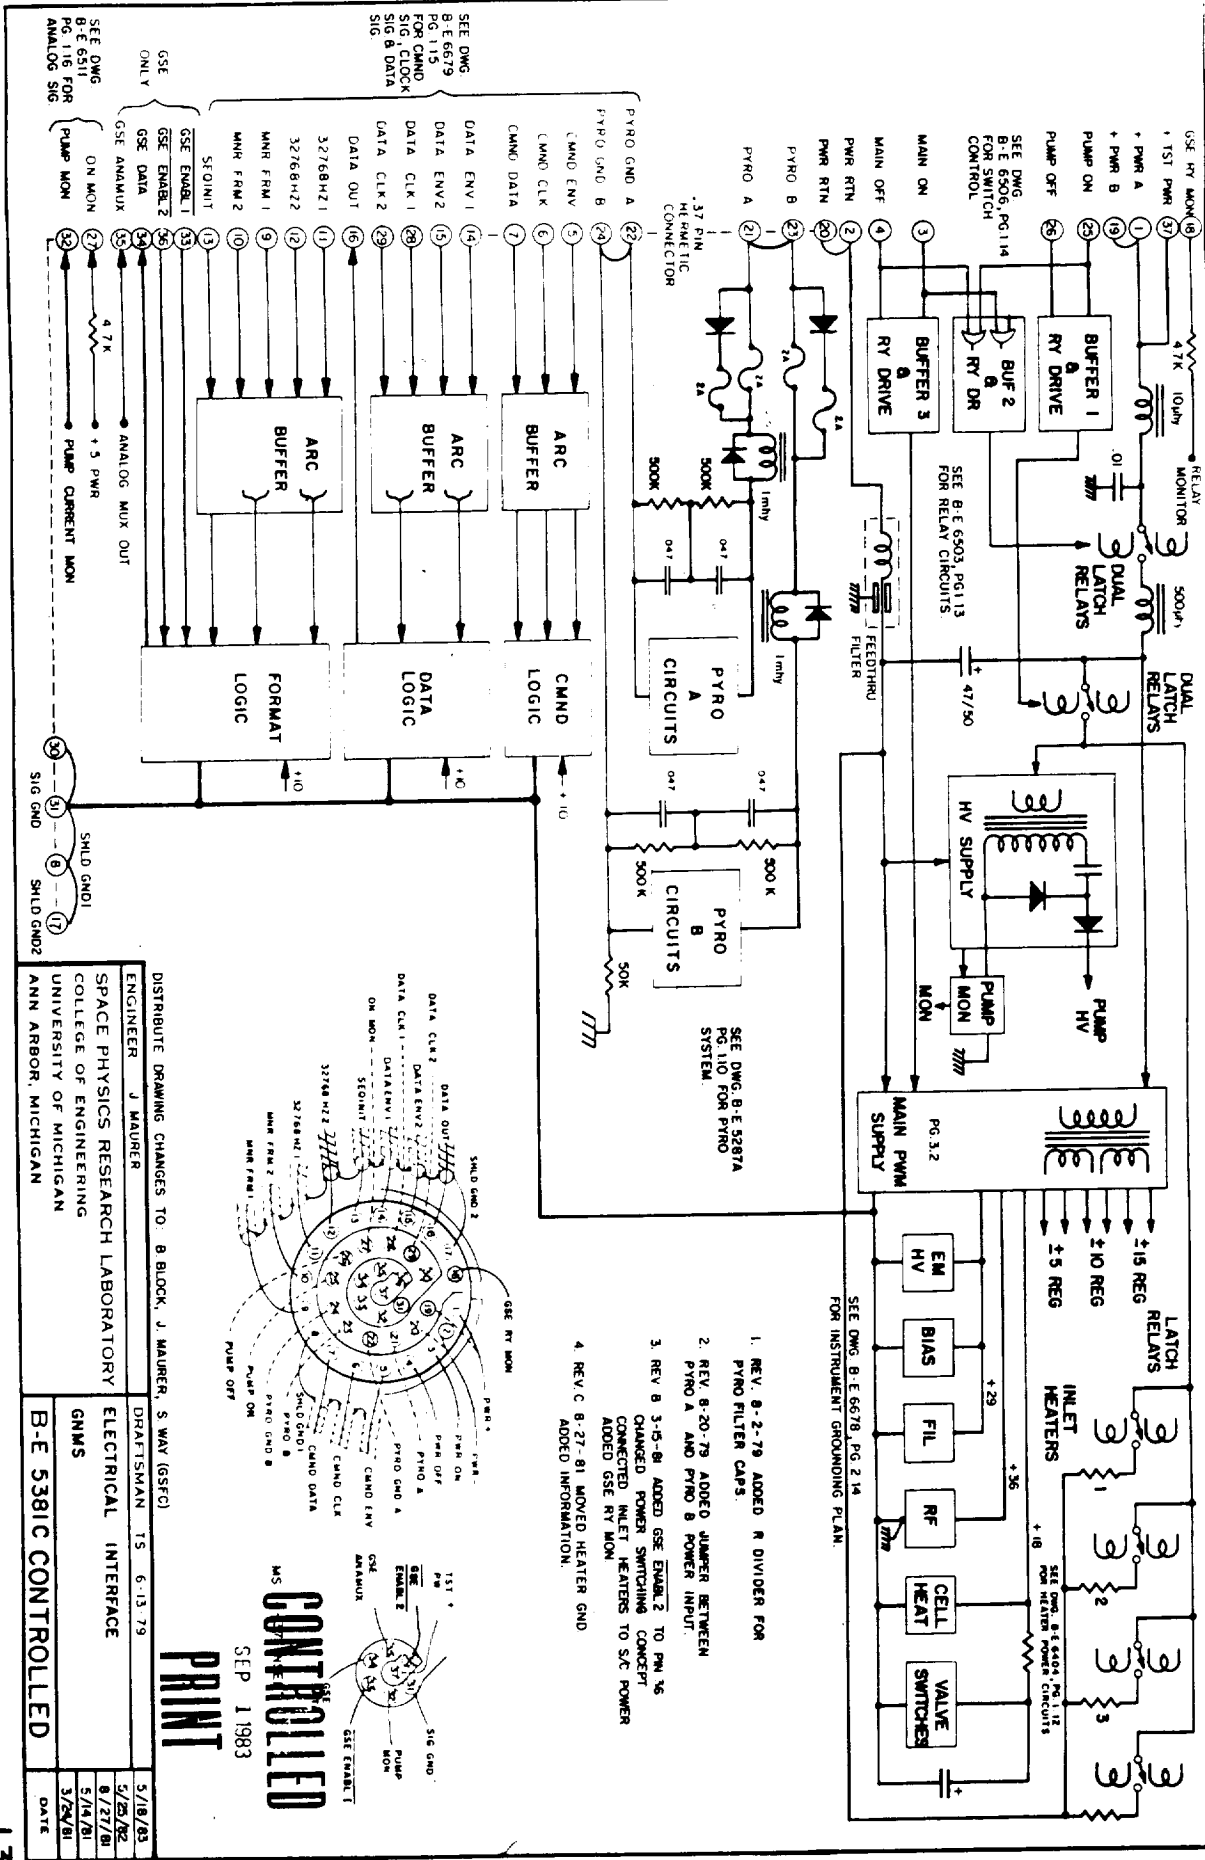

DISTRIBUTE DRAWING CHANGES TO: B BLOCK, J MAURER, S WAY (SSFC)

ENGINEER	J MAURER	DRAFTSMAN	TS 6-13-79
SPACE PHYSICS RESEARCH LABORATORY		ELECTRICAL INTERFACE	
COLLEGE OF ENGINEERING		GNMS	
UNIVERSITY OF MICHIGAN		B-E 5381C CONTROLLED	
ANN ARBOR, MICHIGAN		DATE	


CONTROLLED
SEP 1 1983
PRINT

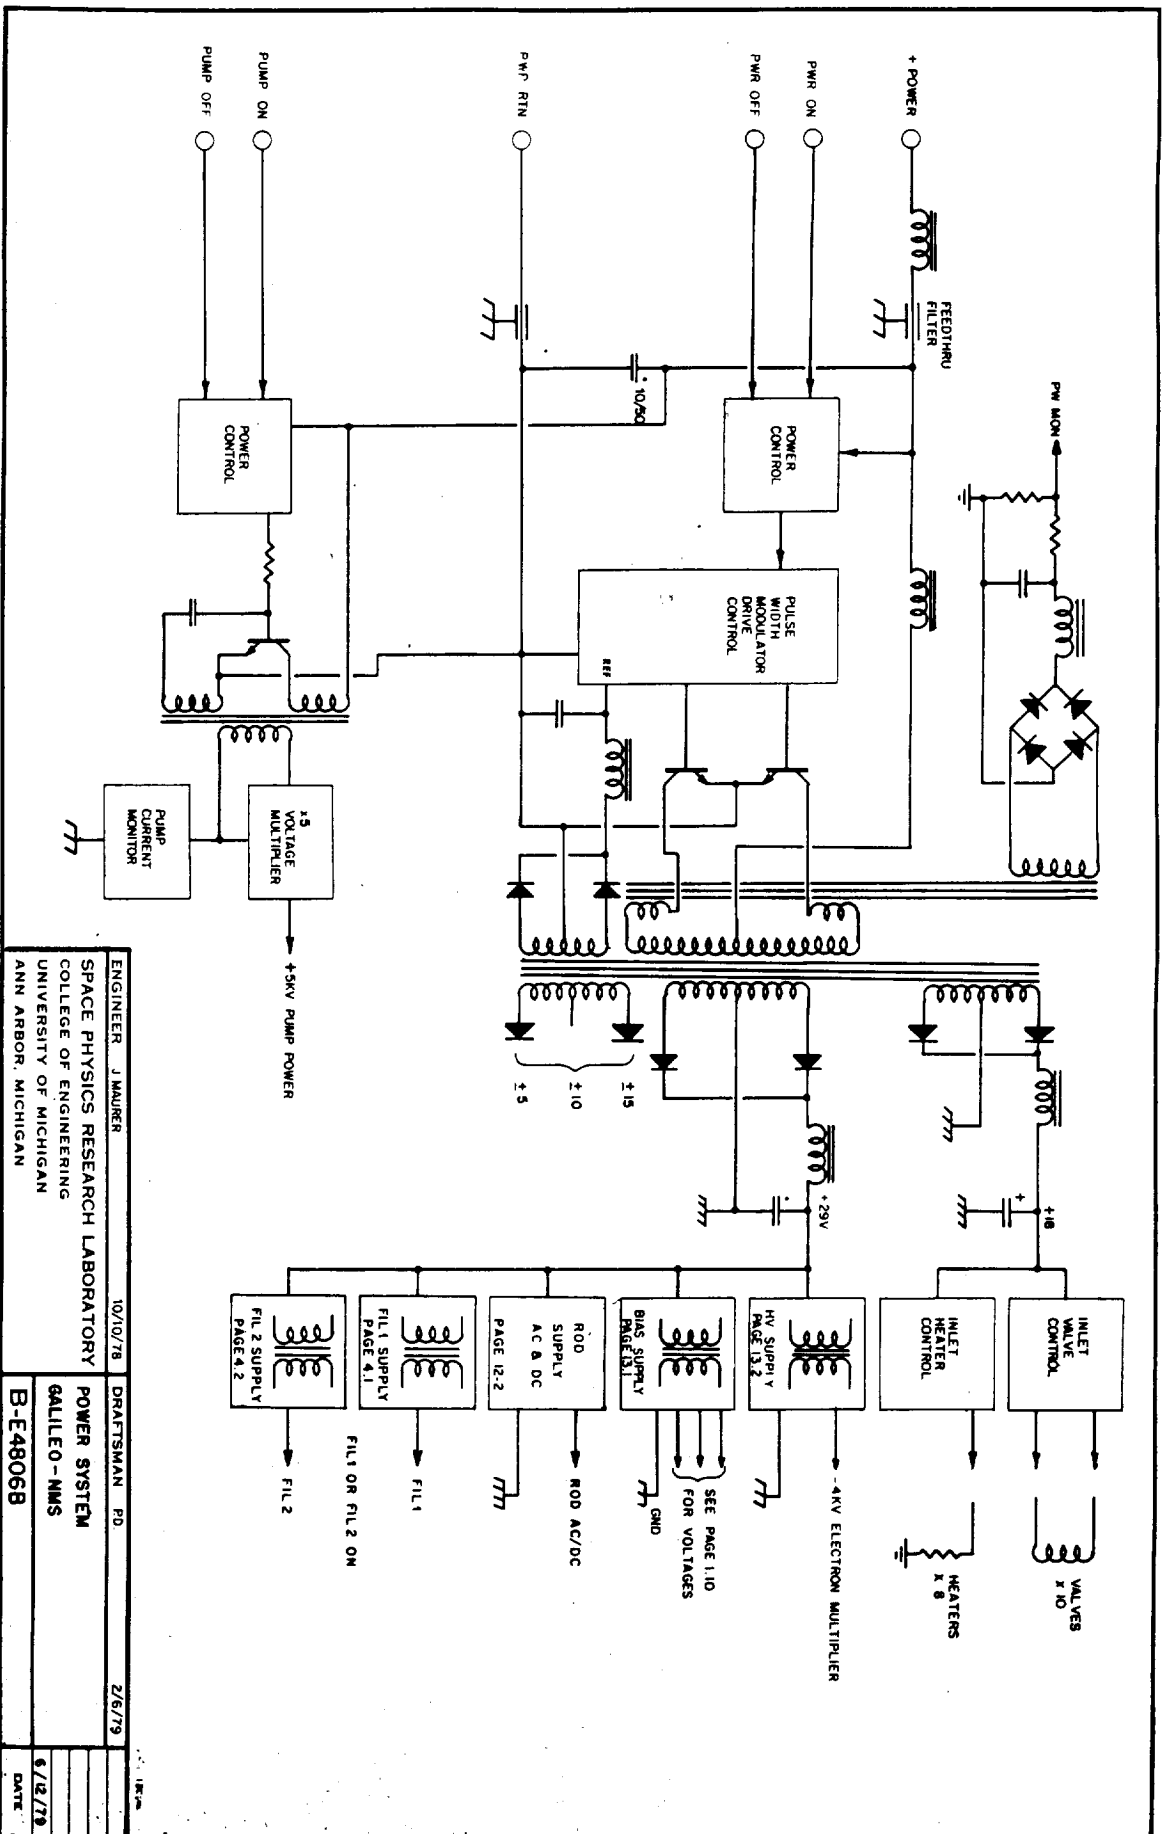

QUANTITATIVE COMMAND INPUT TABLE

		(MSB)					(LSB)				
BIT	W/D	0	1	2	3	4	5	6	7		
0		0	0	X	X	2	3	4	5		
1		0	1	6	7	8	9	10	11		
2		1	0	12	13	14	15	16	17		
3		1	1	18	19	20	21	22	23		

(FOUR QUANTITATIVE WORDS TO COMPLETELY CONFIGURE TUNE MEMORY)

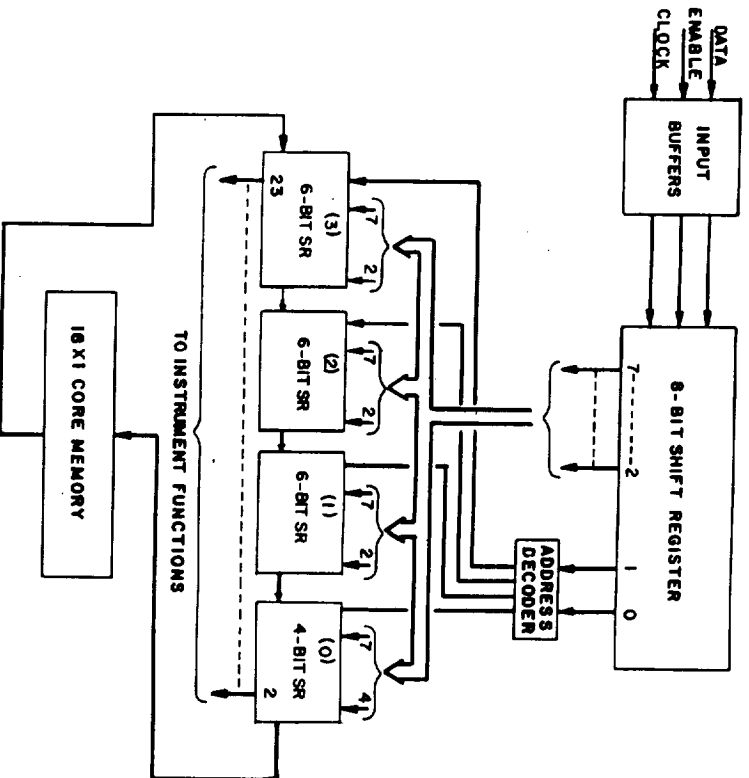


1. CORE FULLY REWRITTEN AFTER EACH RECEPTION
2. CORE DUMPED INTO REGISTER & REWRITTEN AT EACH POWER TURN-ON

(MSB)		(LSB)							
BIT WD	0	1	2	3	4	5	6	7	
5	X	X	2	3	4	5	6	7	
6	8	9	10	11	12	13	14	15	
7	16	17	18	19	20	21	22	23	

(READ BACK ONLY WHEN PROGRAM STEP
(HK WORD 2) READS 0 OR 1)

SEE ALSO: B-E6692 (QUANTITATIVE COMMANDS)


ENGINEER	W.H. FINKUS	DRAFTSMAN	AGK	2-4-79
SPACE PHYSICS RESEARCH LABORATORY		COMMAND SYSTEM CONCEPT		
COLLEGE OF ENGINEERING		GALILEO - NMS		
UNIVERSITY OF MICHIGAN		5/26/82		
ANN ARBOR, MICHIGAN		2-8-79		
		DATE		
		B-E4717C		

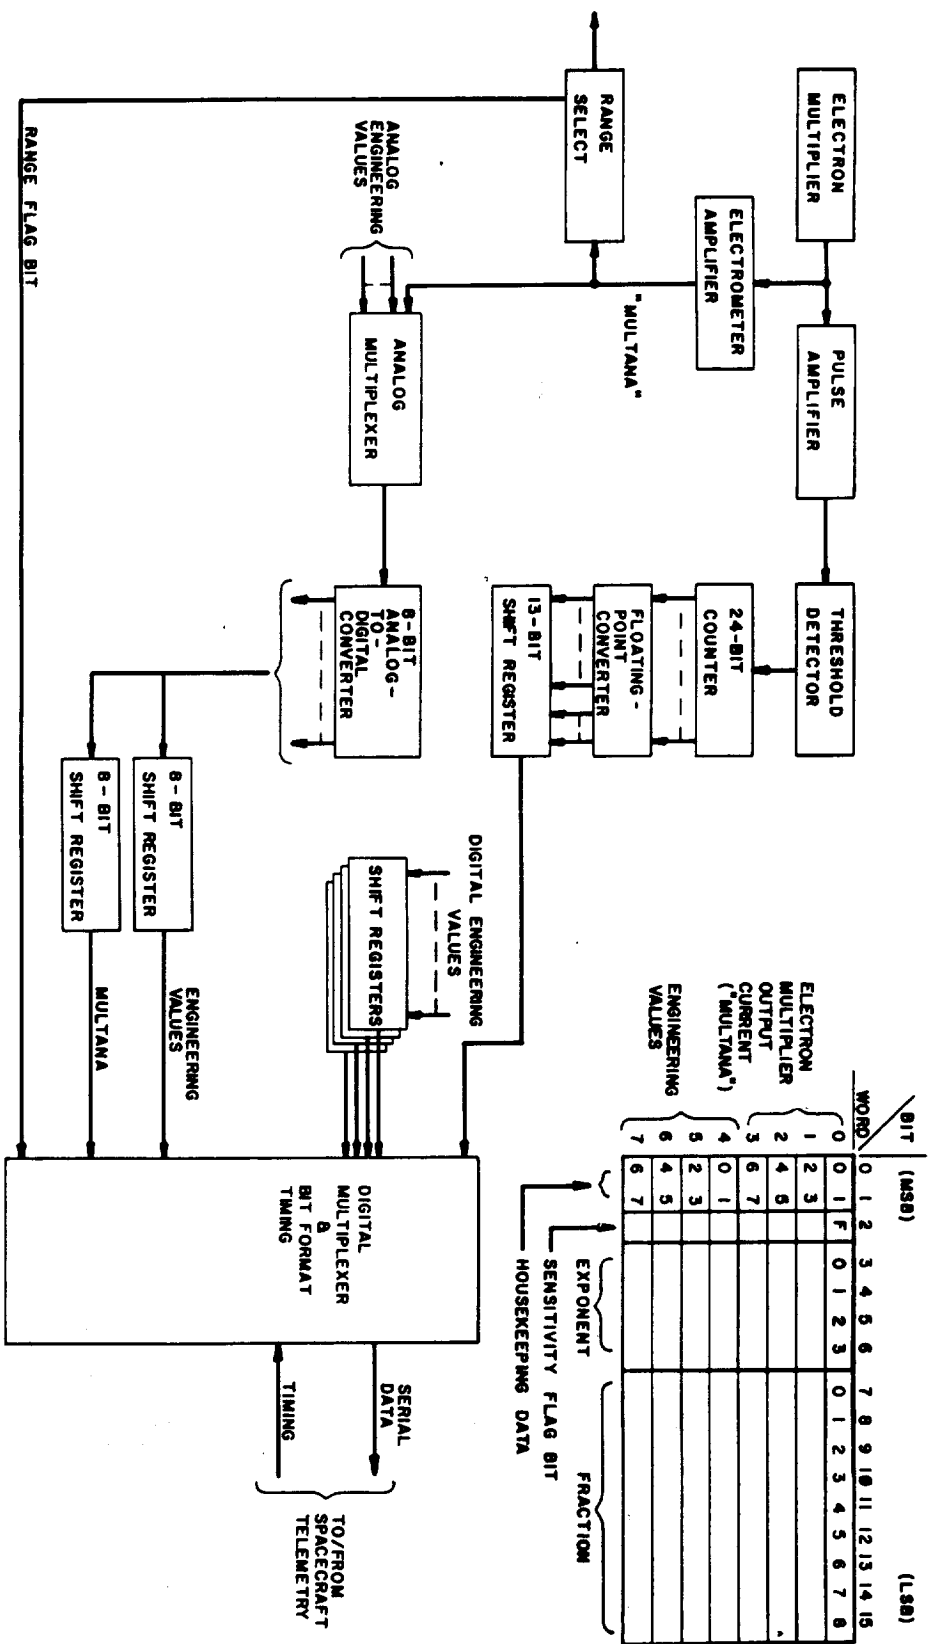

SEE ALSO: B-E5269 (DATA FORMAT)

ENGINEER: WH PINKUS	DRAFTSMAN: GAW	2-6-79
SPACE PHYSICS RESEARCH LABORATORY	DATA SYSTEM CONCEPT	
COLLEGE OF ENGINEERING	GALILEO - NMS	
UNIVERSITY OF MICHIGAN	B-E 47188	
ANN ARBOR, MICHIGAN		
	DATE	

LAST USED: R C D L

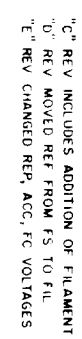

11/10/78		
	12/23/8	
	11/1/83	
	DATE	

GALILEO PROBE TM MINOR FRAME

0	1	2	3	4	5	6	7
8						14	15
16						22	23
24						30	31
32						38	39
40						46	47
48						54	55
56						62	63

NMS MINOR FRAME STARTS WITH 1ST AFTER MINOR FRAME SYNC.

64 WORDS / MINOR FRAME		8 BITS / WORD	
BIT / SEC	64	128	512
WORDS / SEC	8	16	64
FRAMES / SEC	.125	.25	1
SEC / MAJOR F	256	128	32

NMS WILL OPERATE AT ANY OF THE ABOVE BIT RATES WITH PROPER SCALING FOR COUNTS PER INTEGRATION TIME.


NO PROBE MAJOR FRAME SYNC USED

NMS DATA STARTS WITH 1ST MINOR FRAME SYNC AFTER SEQ INIT. RESULT OF FIRST INTEGRATION IN FORMAT READS OUT IN MF WORDS 14 & 15.

NMS 16 BIT WORD															
MAIN FRAME WD6								MAIN FRAME WD7							
0	1	2	3	4	5	6	7	8	9	10	11	12	13	14	15
MSKP	S	EXPONENT	MSB FRACTION				LSB								

SENSITIVITY 1: LOW 0: HIGH

NMS 8 WORD MINOR FRAME

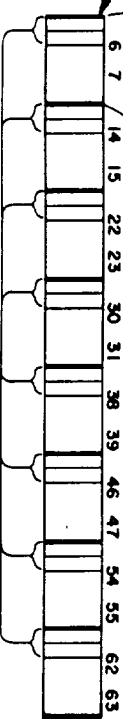

6	14	22	30	38	46	54	62
0	1	2	3	4	5	6	7

MULTIPLIER CURRENT

HOUSEKEEPING SUBCOM

MULTIPLIER CURRENT VALUE COLLECTED DURING ANY ONE INTEGRATION IN PREVIOUS MINOR FRAME - AS SELECTED BY PROGRAM PROM.

HOUSE KEEPING ANALOG VALUES COLLECTED DURING MF WORD 7. DIGITAL VALUES COLLECTED AT BEGINNING OF MF WORD 36.

64 WORDS / MINOR FRAME

FIRST 2 WORDS CONTAIN A 16-BIT NASA-STD SYNC (0000010101010101) MSB

BETWEEN POWER TURN-ON A SEQUENT COMMANDS PROGRAM COUNTER CYCLES THRU LAST MAJOR FRAME REPEATEDLY. SEQUENT RESETS PROGRAM COUNTER TO WORD 0 AND RELEASES IT FOR NORMAL OPERATION.

PROGRAM STEP IS THE NMS 16-BIT WORDS PER PROBE TM MINOR FRAME. "00" BEFORE SEQ. INIT. COMMAND STATUS IS A COMPLETE READ BACK OF THE COMMAND MEMORY.

THE HOUSEKEEPING WORD IS MULTIPLIED TO MAKE A NMS OF 32, 8-BIT WORDS

TWO BITS PER NMS WORD ASSEMBLED TO MAKE 16-BIT HOUSEKEEPING WORD 8-BIT HOUSEKEEPING WORD CURRENT WORD PER PROBE MINOR FRAME.

0	1	2	3	4	5	6	7
8	9	10	11	12	13	14	15
16	17	18	19	20	21	22	23
24	25	26	27	28	29	30	31

NMS MAJOR FRAME

BEFORE SEQ INIT AND

FOLLOWING MAJOR FRAMES

- 0 SYNC MSB
- 1 SYNC LSB
- 2 PRGM STEP
- 3 VALVE STATUS 1
- 4 VALVE STATUS 2
- 5 CMD STATUS 1
- 6 CMD STATUS 2
- 7 CMD STATUS 3
- 8 PWR MON
- 9 MULTANA
- 10 PUMP CURRENT
- 11 HV MON
- 12 EMIS 1 MON
- 13 EMIS 2 MON
- 14 RF FREQ
- 15 FIL 2 I
- 16 REP MON
- 17 ACC MON
- 18 +29 MON
- 19 SHELL PRS
- 20 BIAS T2
- 21 PUMP VOLTS
- 22 OSC AGC
- 23 OSC TMP
- 24 ELECT TMP
- 25 CELL 1 TMP (T5)
- 26 LEAK 1 TMP (T3)
- 27 INLT 1 TMP (T2)
- 28 ANODE (T8)
- 29 ANALYZER (T7)
- 30 RF FREQ
- 31 RF FREQ

SEE ALSO: B-E4718 (DATA SYSTEM CONCEPT)

8/1/80 REV ANALOG SUBCOM (JM)

ENGINEER PINKUS/MAURER 4-28-79

SPACE PHYSICS RESEARCH LABORATORY

COLLEGE OF ENGINEERING

UNIVERSITY OF MICHIGAN

ANN ARBOR, MICHIGAN

DRAFTSMAN TS 5-4-79

DATA FORMAT & SYNC

GNMS


B-E 5269B

DATE

LAST USED R C D L

SPACECRAFT

NEUTRAL MASS SPECTROMETER

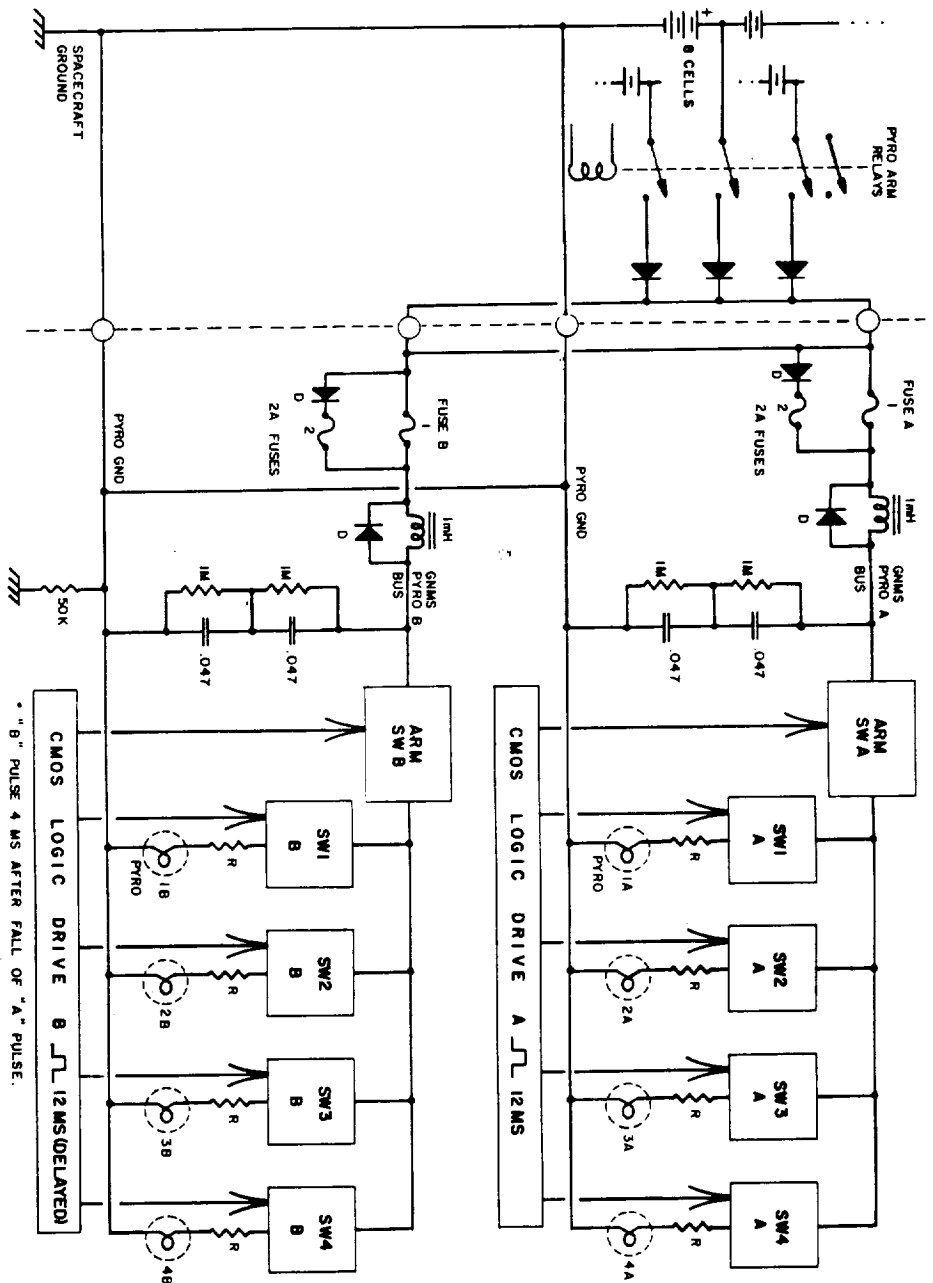

NOTES:

R: E (VOLTAGE AVAILABLE)
4 AMP

F 4.5 OHM (E: 18V)

FUSE: PROOFUSE FM08-125 2A PER MIL-F-23419/8

R: RWR-01-3483FS PER MIL-R39007/9 (4.53 OHM)


D: UTX480 PER JPL GALILEO BUY

* "B" PULSE 4 MS AFTER FALL OF "A" PULSE.

4/15/81	ADDED 1MΩ INDUCTORS	8/21/81	CHANGED TO 4 PYRO DEVICES
ENGINEER	J MAUER	REV 4A	5/8/79
SPACE PHYSICS RESEARCH LABORATORY			
COLLEGE OF ENGINEERING			
UNIVERSITY OF MICHIGAN			
ANN ARBOR, MICHIGAN			
DRAFTSMAN		TS	5-8-79
PYROTECHNIC SYSTEM			
GNMS			
B-E 5287A			
DATE:			


LAST USED R C D L

ENRICHMENT SYSTEM A

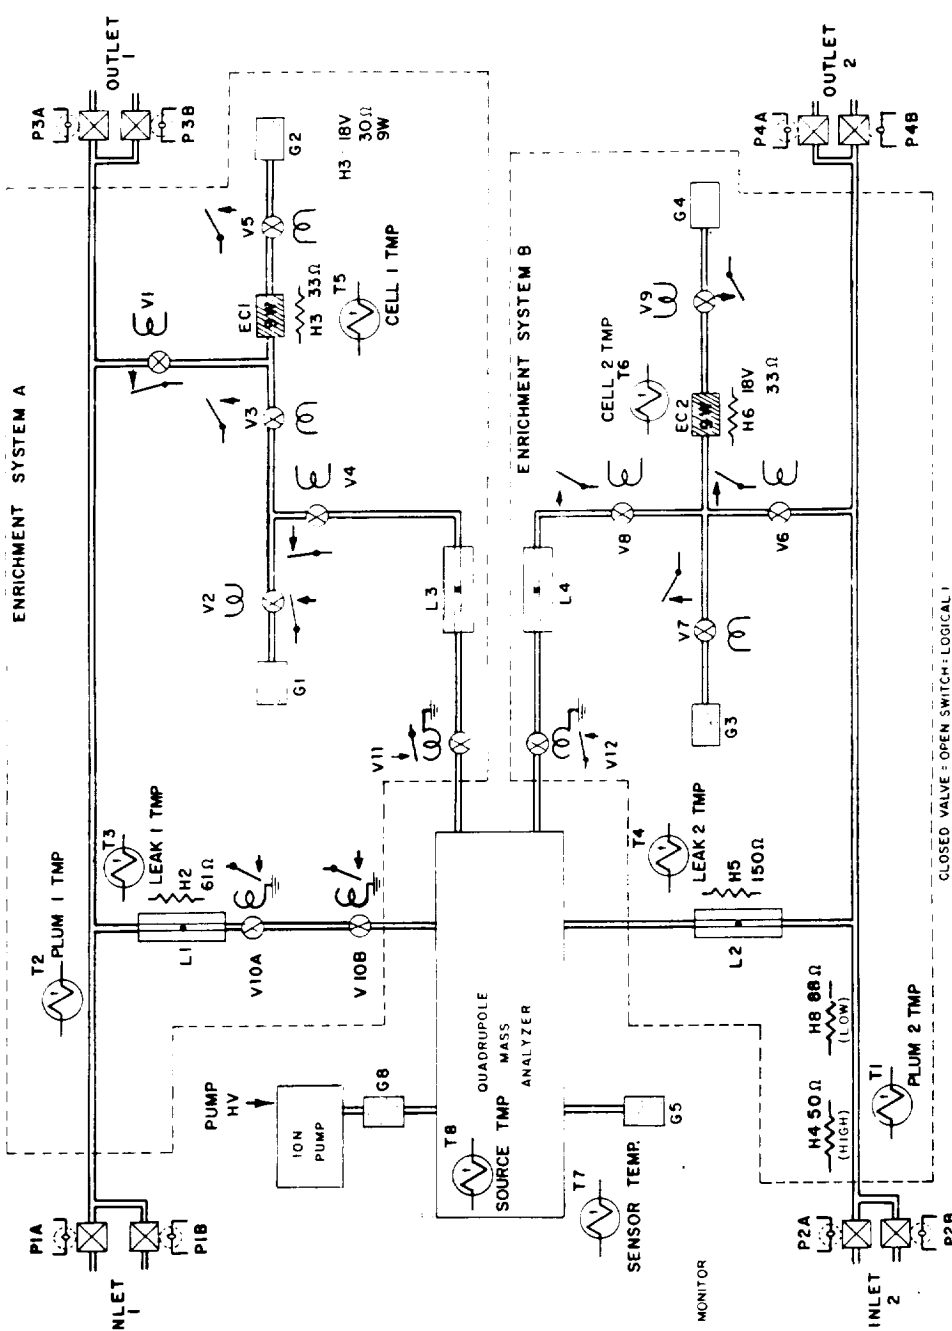

CLOSED VALVE = OPEN SWITCH = LOGICAL 1

SYMBOLS

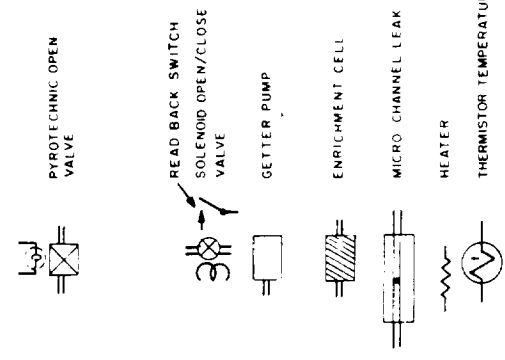

NOTES 1 PI THROUGH P4 ARE LOCATED OUTSIDE OF THE MAIN INSTRUMENT CASE

2 SEE DWG B-E 5296 (PAGE 10 18) FOR FUNCTION/CODING TABLE

3 V3B, V4, V6B, V8

INTERCHANGED TO MATCH H4 HARD WIRE OVP LOGIC

REV 5 10 13-1980 PER J.M.

4 11/5/80 HEATER DESIGNATIONS

CHANGED PER J. COOLEY COMMENTS

5 HEATER 2, 4, 5, 8 ARE POWERED DIRECT FROM SC POWER THRU LATCHING RELAYS

6 H1B, H7 DELETED FROM DESIGN 12/16/80

7 V11B, 8, V12B DELETED 11/16/81

8 CHANGE TO ONLY 2 SYSTEM PLUGS 5/18/82

ADD COIL GROUNDS TO V10, 11, 12

9 MOVE V1 TO MATCH GSFC DRAWING OF 11/13/81. DELETE G6, 67 10/12/83

ENGINEER J. MAURER 3/27/80

DRAFTSMAN MG 4/17/80

SPACE PHYSICS RESEARCH LABORATORY

COLLEGE OF ENGINEERING

UNIVERSITY OF MICHIGAN

ANN ARBOR, MICHIGAN

GAS INLET SYSTEM

REV 9

GNMS

B-E 6142 F

DATE

10/12/83

7/12/82


5/8/82


11/16/81

GNMS CONTROLLED DISTRIBUTION

OCT 19 1983

1-11

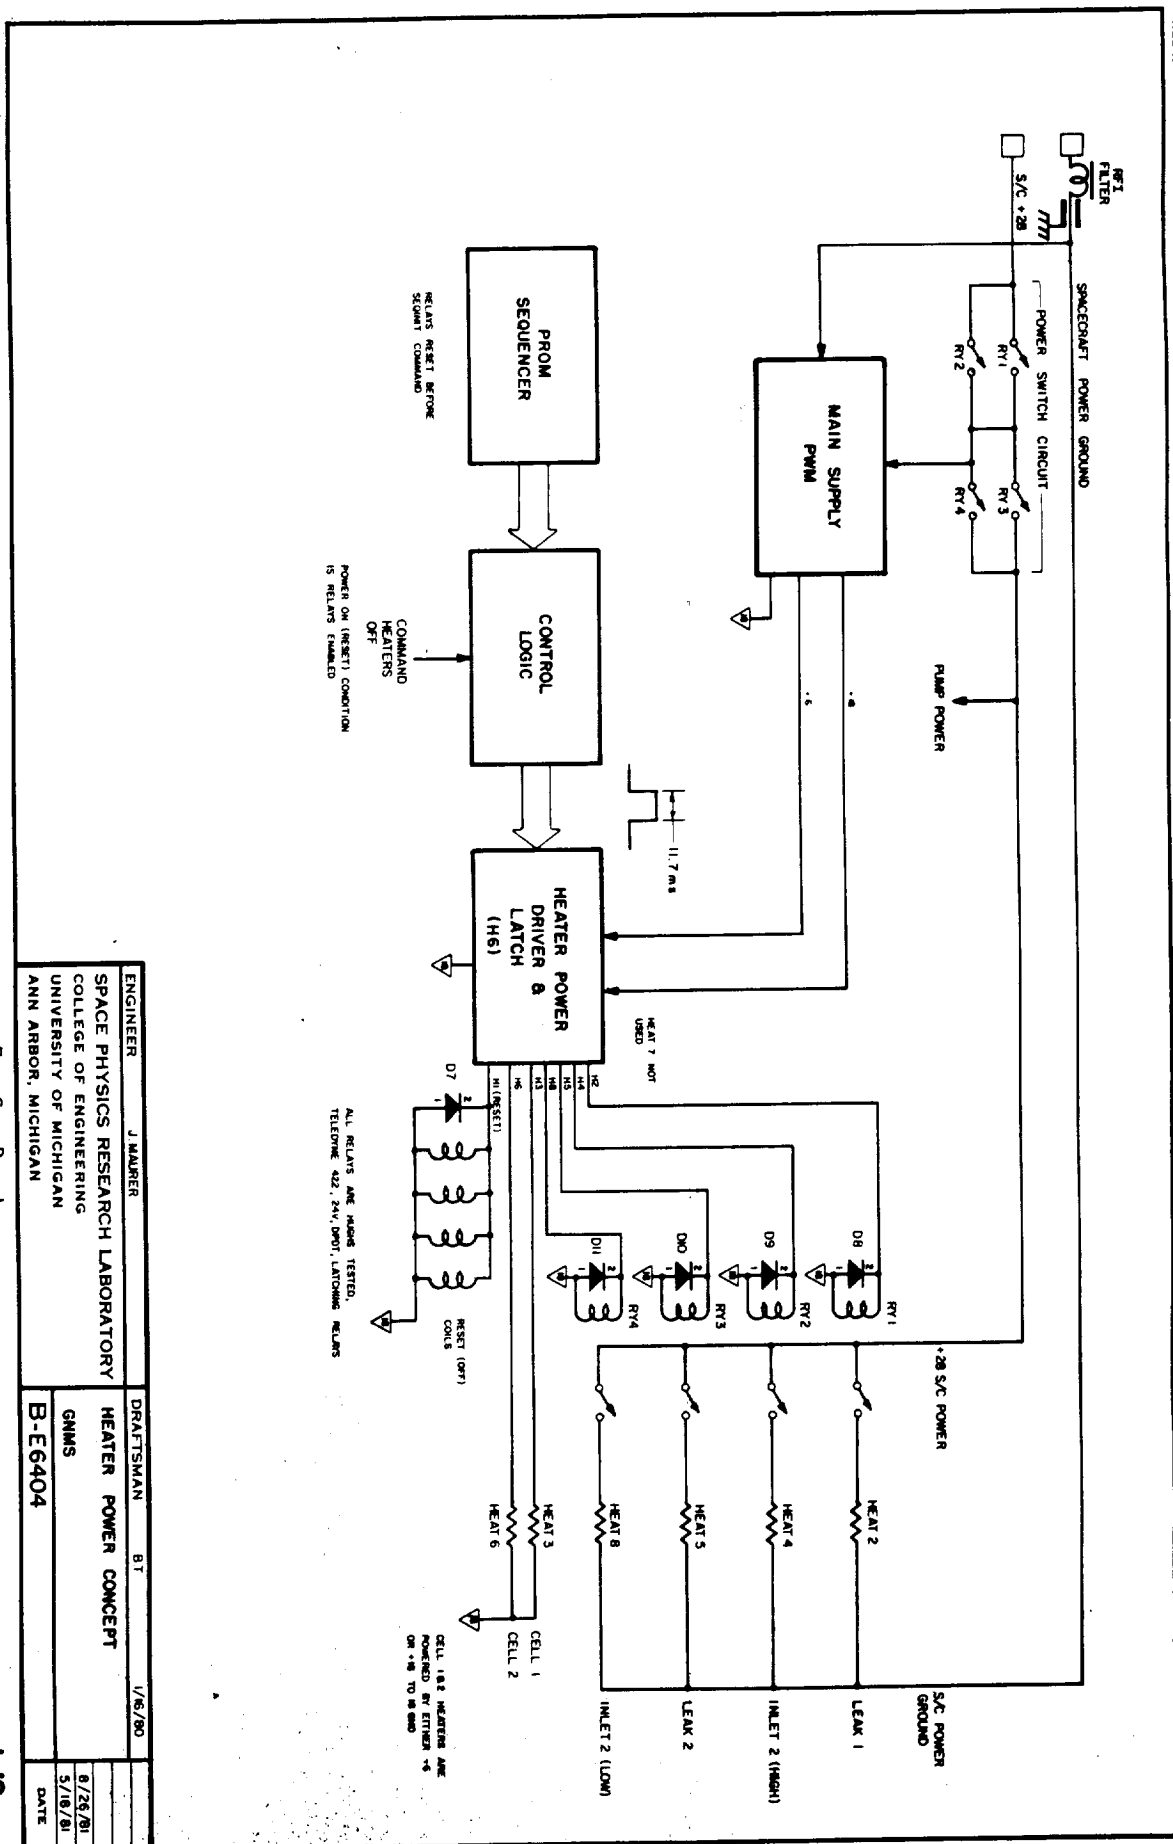

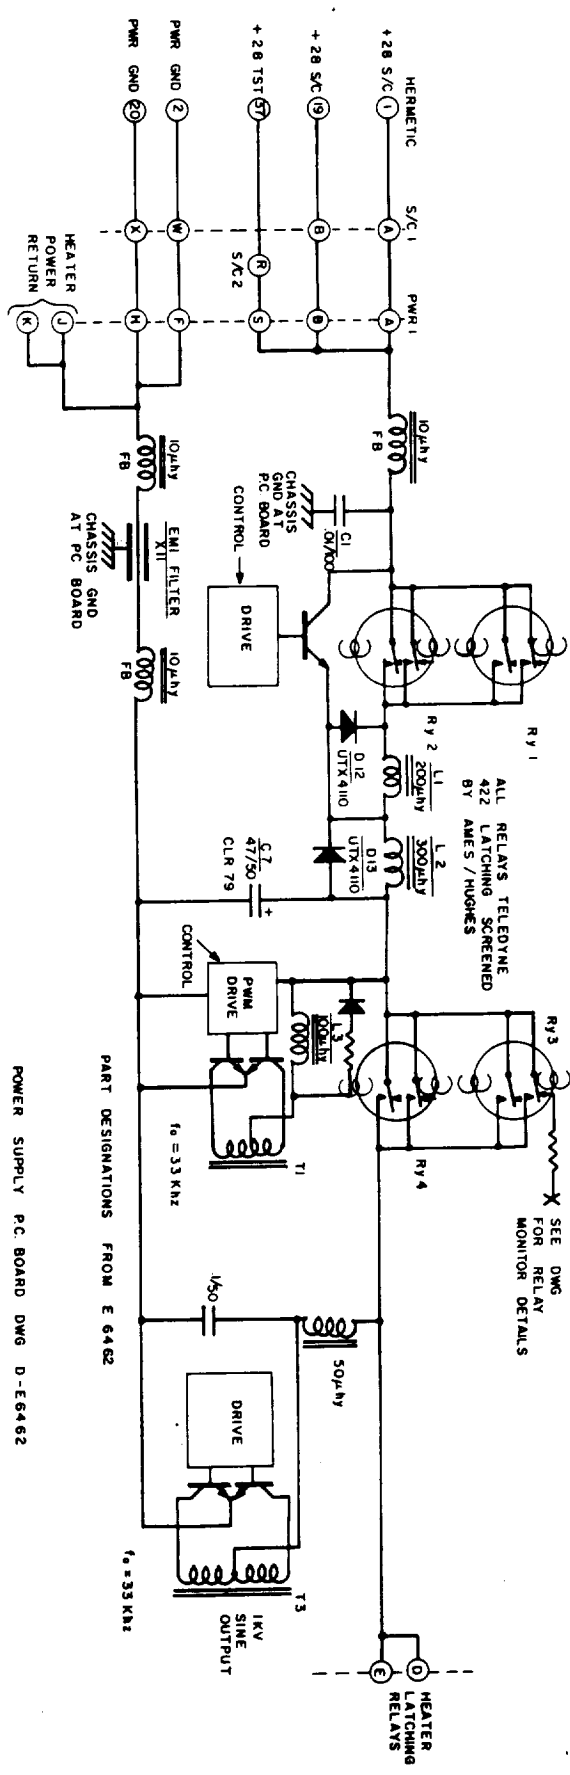


POWER SUPPLY P.C. BOARD DWG D-EG462


PART DESIGNATIONS FROM E 6462

ENGINEER MAURER	DRAFTSMAN G. WIGGINS	4/13/81
SPACE PHYSICS RESEARCH LABORATORY	POWER SWITCH INTERFACE	
COLLEGE OF ENGINEERING	GNMS	5/25/82
UNIVERSITY OF MICHIGAN	B-E 6503	DATE
ANN ARBOR, MICHIGAN		


LAST USED R C D L

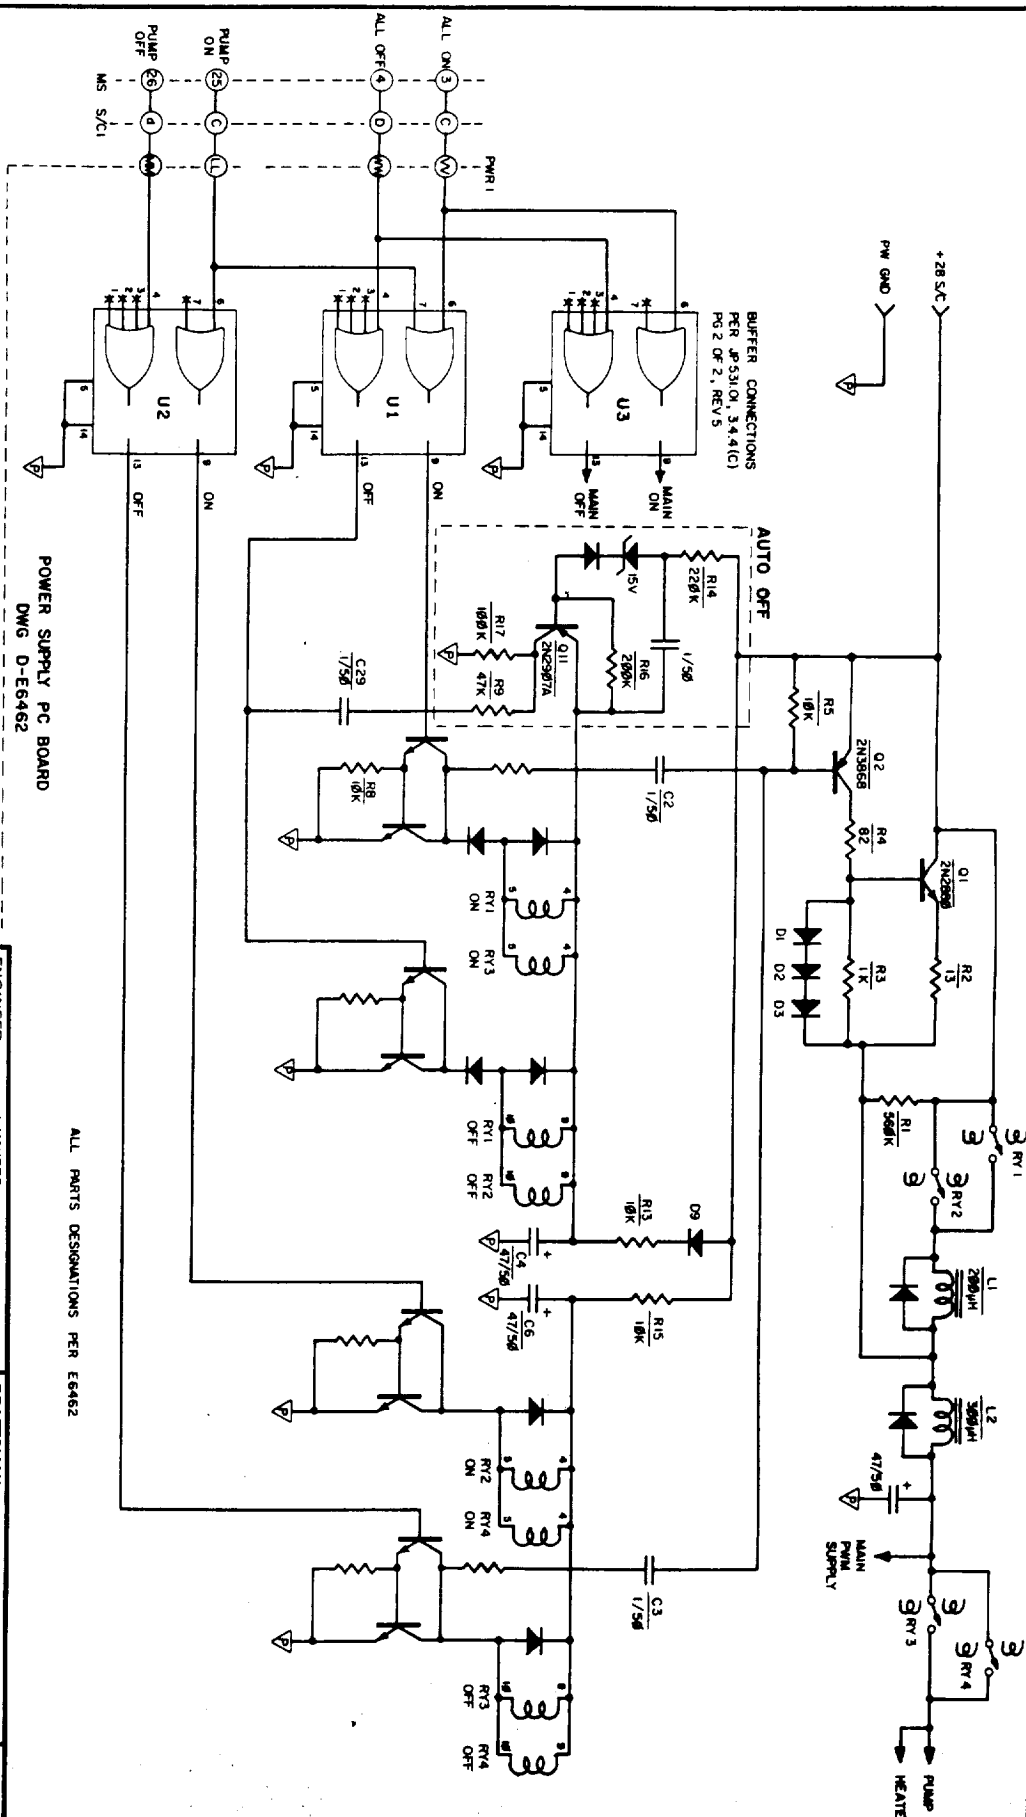

[illegible]

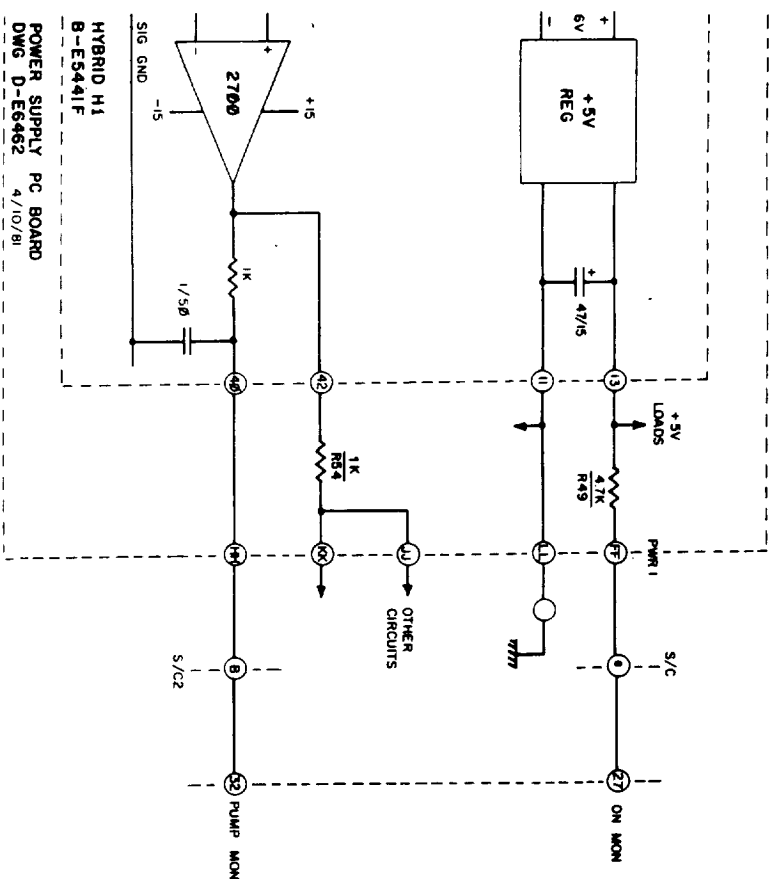


ENGINEER	J MAURER	DRAFTSMAN	J G	4/10/81
SPACE PHYSICS RESEARCH LABORATORY				
COLLEGE OF ENGINEERING				
UNIVERSITY OF MICHIGAN				
ANN ARBOR, MICHIGAN				
ANALOG MONITOR INTERFACE				
GNMS				
B-E6511				
DATE				

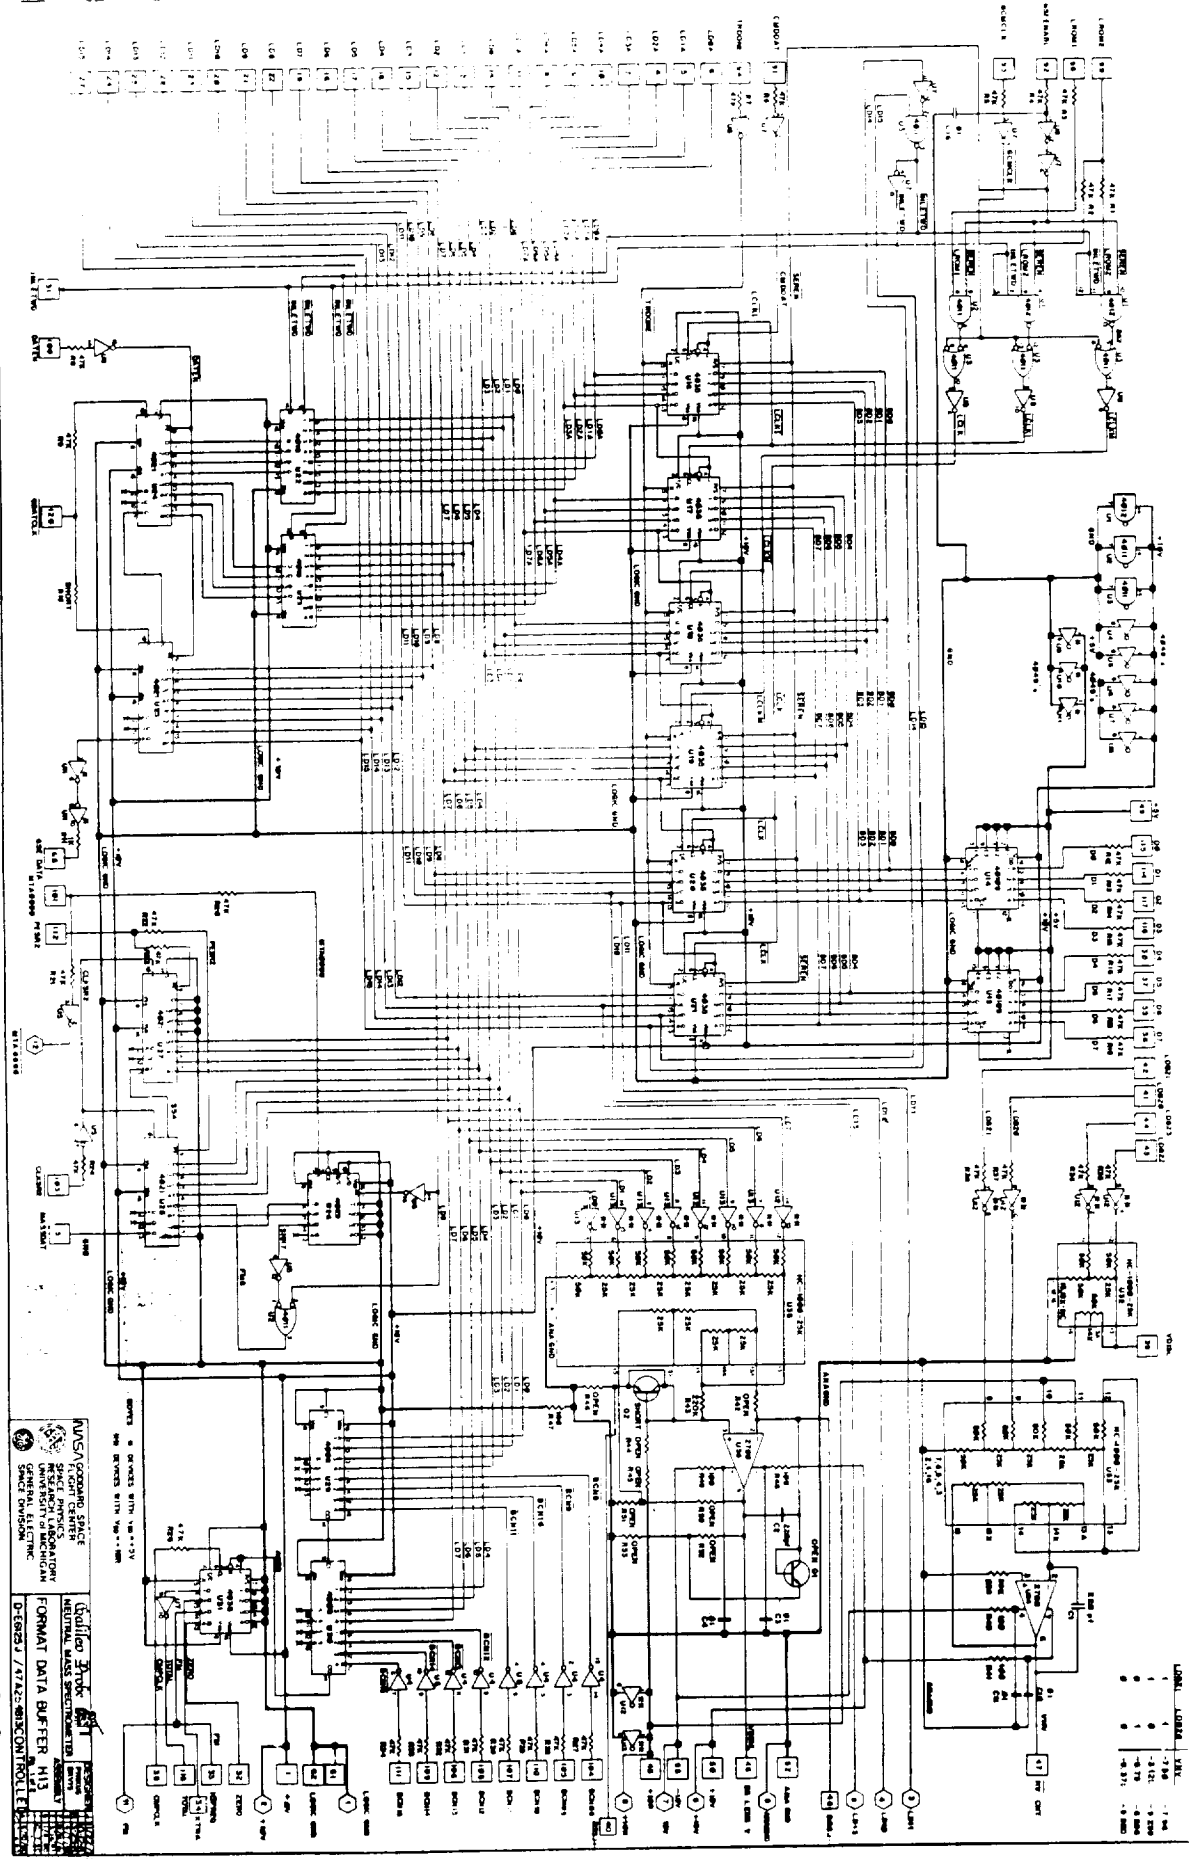



 

NASA GOODARD SPACE
FLIGHT CENTER
SPACE PHYSICS
RESEARCH LABORATORY
UNIVERSITY OF MICHIGAN
GENERAL ELECTRIC
SPACE DIVISION

0-E6126A	S/N 2	11/17/82
----------	-------	----------


SEP 9 1982
15.20

H11		H11 Mass Calculator		*FILE: LG1N3.PIN DISC:GNMS WIRE LISTS (PMT REFERENCE FILE:R1/103	
1	2	3	4	5	6
1	10V	61	154		
2	+10V	62	LS6		
3	CLSR2-	63	LS7		
4	MTA0	64			
5	MTA0	65			
6	MTA0	66			
60	MTA0	120			
*pins continued on next		*end of pins for H11		*FILE: LG1N3.PIN DISC:GNMS WIRE LISTS (PMT REFERENCE FILE:R1/103	
				REFER TO DRAWING B-E6146 (PG.11.1) FOR ADDITIONAL INFORMATION	
				EDITS: 3-11-81 BY JM	
				Added LGC1, LGC2, LGC3, Plug layouts per Main Harness	
				3-16-81 BY JM & WP	
				CHANGED MUX1 TO CMUX1, CHGD ELECTMP to TMP PMR, CHGD	
				HKSCLK ILT/RF to HKSCLK, ADDED EXTRA for DESNS	
				OPTIONS, CHANGED H13:LD12 to LD12 DESNS.	
				3-30-81 BY JM	
				ASSIGNED PINS TO H7, H11, & H13, PER GE DWG.	
				4-2-81	
				Included red lines from 4-1-81, check prints.	
				4-3-81	
				Released to GE Multilayer for design.	
				5-18-81	
				Changed duplicate pin H13-36 (D6) to pin 35 and;	
				Changed duplicate pin H13-21 (LD21) to pin 42. Both	
				changes redlined in Bob Gehris's copy. No other known	
				errors this date.	
				5-20-81	
				Reversed pins 5 and 6 on H7, per latest GE check print.	
				This changes 2 nodes: -5V, PA SHLD COAX.	
				5-22-81	
				Changed IC2 from a 34P to a 20P, to provide clearance	
				between plug and instrument shell. This changes 6	
				nodes: CMUX0, CMUX1, CMUX2, +10R, CMDAT-, TMP PMR.	
				8-24-81	
				Added crossreference between GE E numbers and plug no's.	
				PIN T of IC2 from "NOT USED" to "LGC GND". No layout	
				change.	
				9-29-81	
				Changed notation of sex of harness conn	
				This conforms to harness listings.	
				5-6-83	
				Added MTA1000 to IC1-T and LGCGND to IC1-LT. BPP 1 1983	
				5-25-83	
				Added C14 to H7-34, added BSSJ+, BSSJ- names and	
				added C13, R7, R8, and R9. BPP	
				* * *	
				ENGINEER J MAURER	
				DRAFTSMAN	
				SPACE PHYSICS RESEARCH LABORATORY	
				COLLEGE OF ENGINEERING	
				UNIVERSITY OF MICHIGAN	
				ANN ARBOR, MICHIGAN	
				LOGIC I NODE INPUT LIST PG. 1 OF 3	
				GNMS	
				B-E6320A CONTROLLED	
				DATE	

[illegible]

1	H13	61	LOGGND	1	R1	VDISC	
2	+10V	62	LOGGND	2	VTH		
3	MACSDAT	63		2	VDISC		
4	LD2A	64		2			
5	LD1A	65	GSE DATA	2	R2	THERM PW	
6	LD0A	66	FIL2FLG	2	VTH		
7	LD3A	67	ADMUXA-	2	-10R		
8	LD6A	68	MTAO	2			
9	LD5A	69	BMT3	2			
10	LD4A	70	BMT4	2			
11	LD7A	71	BMT5	2			
12	LD7A	72	BMT5	2			
13	LD1	73	BMT7	2			
14	LD0	74	BMT1	2			
15	LD3	75	BMT6	2			
16	LD6	76	BMT8	2			
17	LD5	77	MT6	2			
18	LD4	78		2			
19	LD7	79	MT5	2			
20	LD10	80	MT5	2			
21	LD9	81	MULT	2			
22	LD8	82		2			
23	LD11	83	MT4	2			
24	LD14	84	CHUX0	2			
25	LD13	85	CHUX1	2			
26	LD12 DESNS	86	CHUX2	2			
27	LD15	87	-5V	2			
28		88	MT0	2			
29		89	MT1	2			
30	D4	90	MT2	2			
31	INLETHD	91	CMDAT-	2			
32	ZERO	92	GSEENABL-	2			
33	HIFREQ	93	GCHCLK	2			
34	*EXTRA	94	TRDNE	2			
35	D6	95	T-29	2			
36	D7	96	LROM1	2			
37	D5	97	FTRST	2			
38	CMFCLK	98		2			
39	VDISC	99	LROM2	2			
40	BSSJ+	100	DATEN	2			
41	LD820	101	MTA0000	2			
42	LD821	102	CLKSR2-	2			
43	LD822	103	BCN08	2			
44	LD823	104	BCN09	2			
45	+10R	105	BCN10	2			
46	BS LENS V	106	BCN11	2			
47	-HV CNT	107	BCN12	2			
48	BSSJ-	108	BCN14	2			
49	+5V	109	BCN10	2			
50	+15V	110	BCN15	2			
51		111	PESR2	2			
52	ANAGND	112		2			
53		113	D1	2			
54	-15V	114	D0	2			
55	T2 CNT	115	D3	2			
56	T3 CNT	116	D2	2			
57		117	TOTAL	2			
58		118		2			
59		119		2			
60		120	GDATCLK-	2			

CONTROLLED AUG 15 1983 PRINT

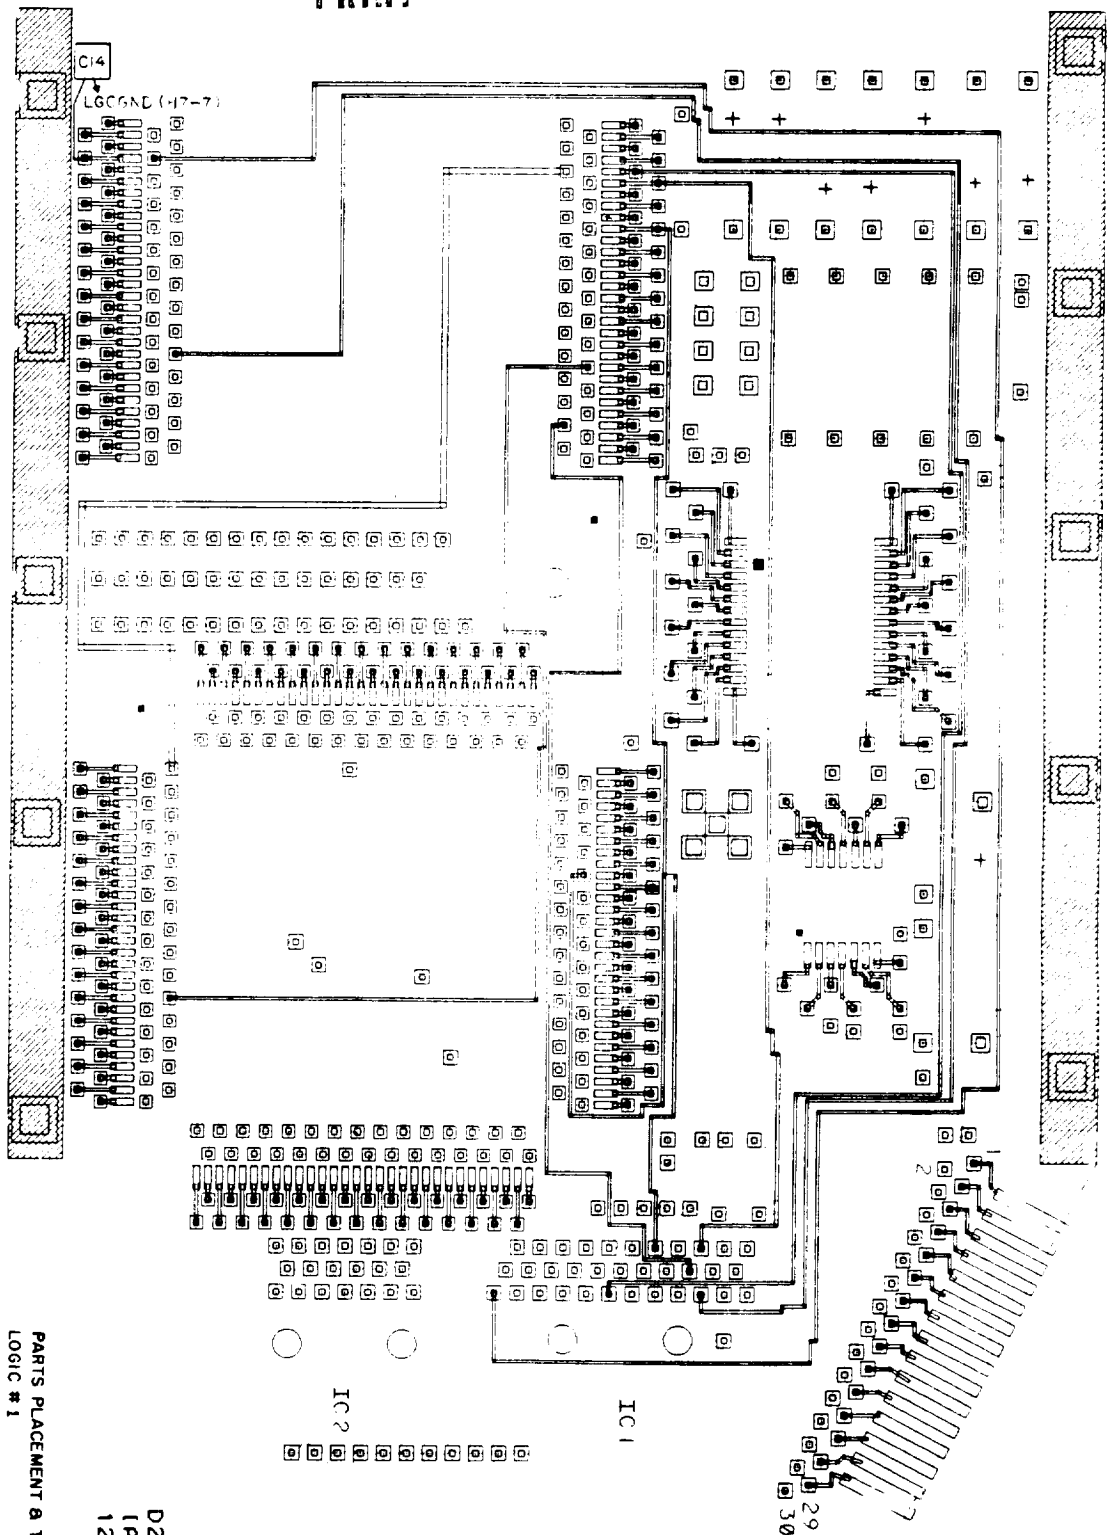

PARTS PLACEMENT & TOP LAYER 5/25/83
LOGIC #1
GMS
S/N2
B-E 6811


D229388PCREVB
IAPWBD, UMICH1
12-09-81


CA

LAYER 2
LOGIC #1
GNMS S/N2
B-E 6813

D229388PCREVI
(APVBD, UMICH
12-09-81

DA

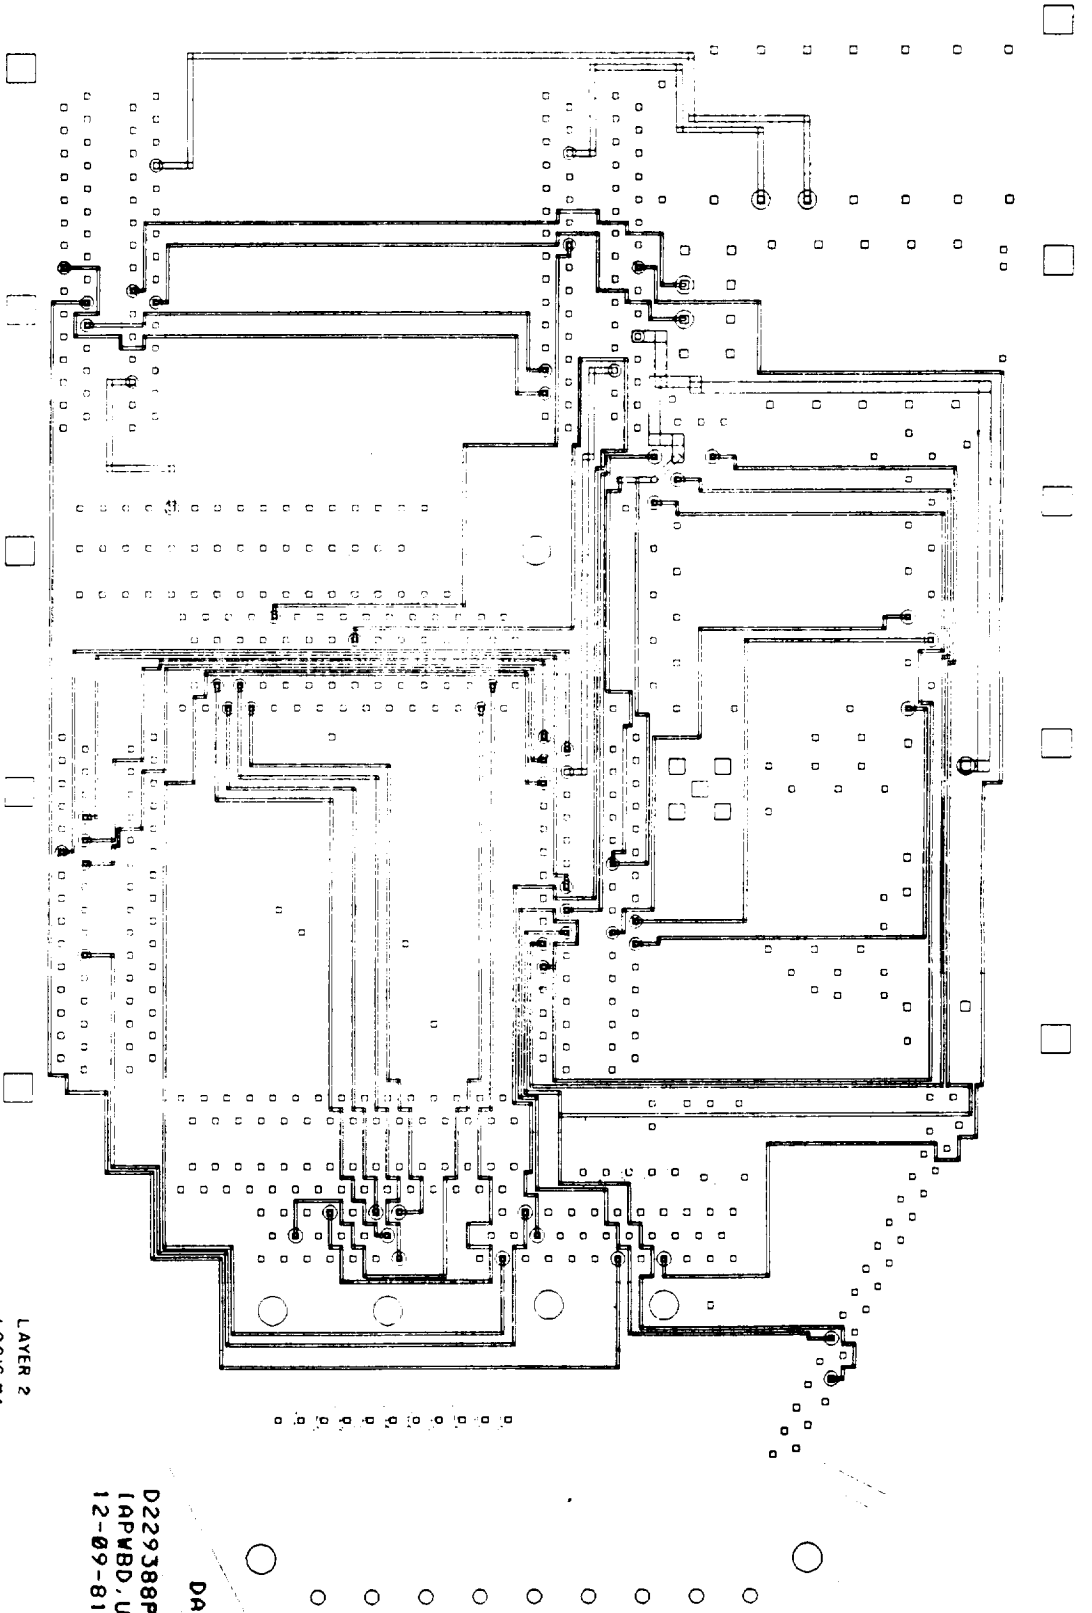


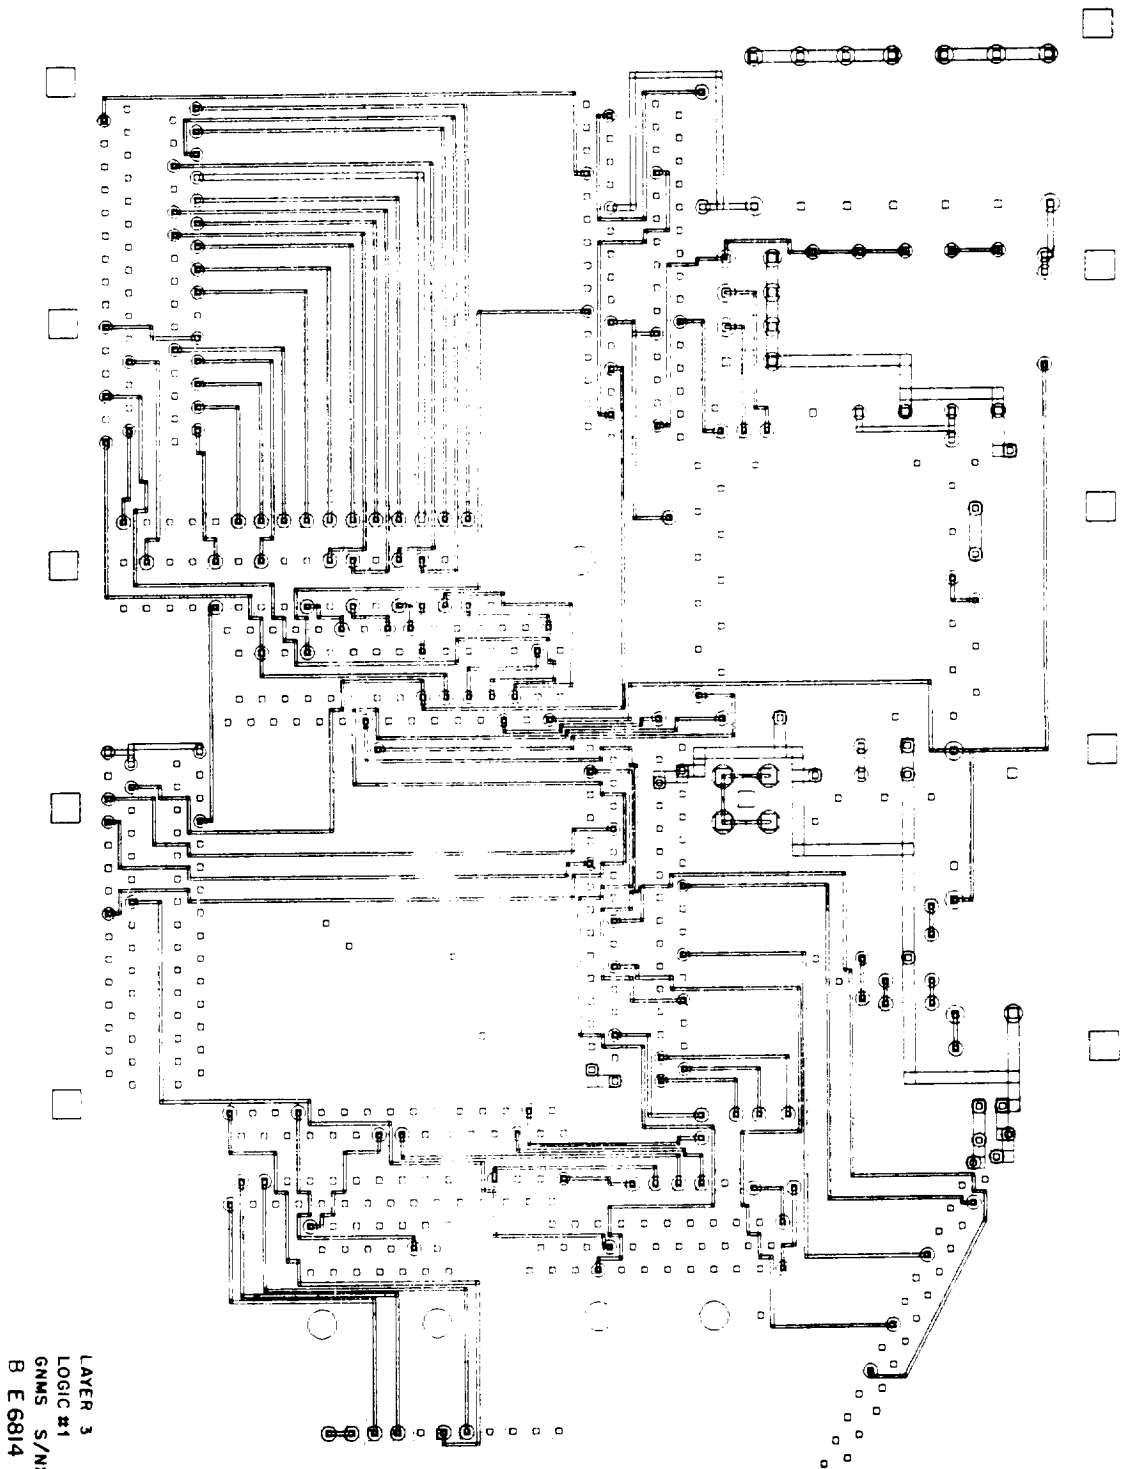

LAYER 3
LOGIC #1
GNMS S/N2
B E6814

D229388PCREVB
(APWBD, UMICH)
12-09-81

EA

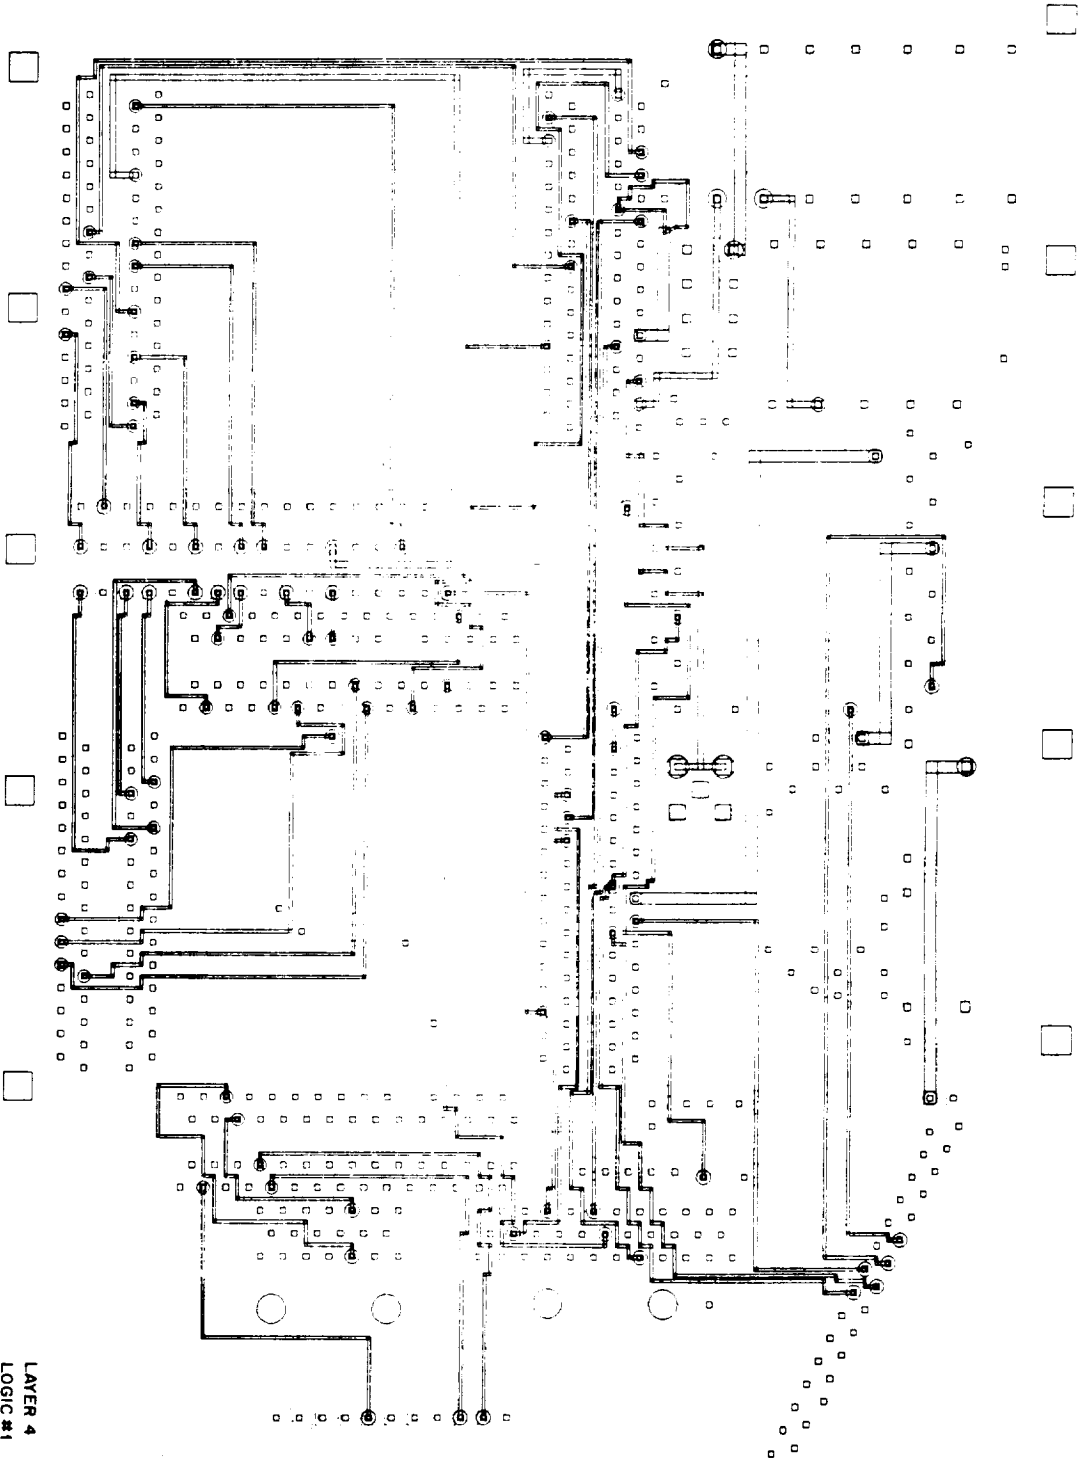

FA


D229388PCREVB
(APWBD, UMICH)
12-09-81

LAYER 4
LOGIC #1
GNMS S/N2
B E 6815

LAYER 5
 LOGIC #1
 GNMS S/N2
 B-E 6816

D229388PCREVE
 (APWBD, UMICH)
 12-09-81


HA

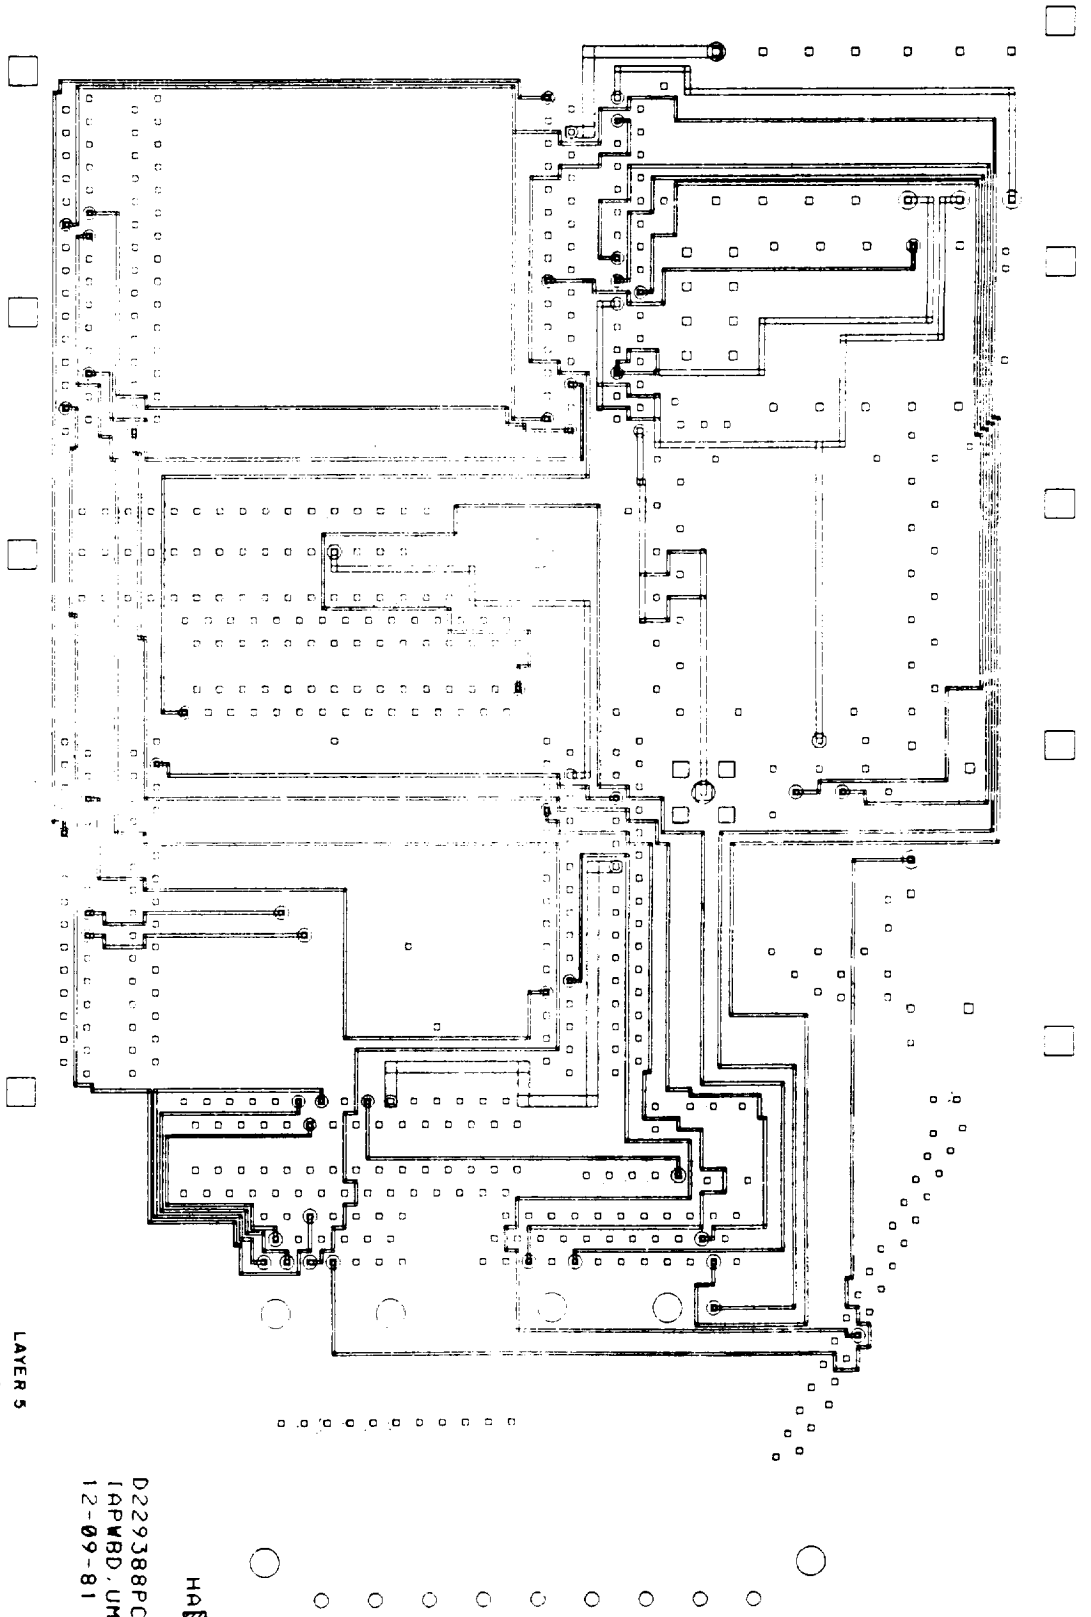


LAYER 6
LOGIC #1
GNMS S/N2
B E 6817


D22938PCREY
IAPVBD, UMICH
12-09-81

JA

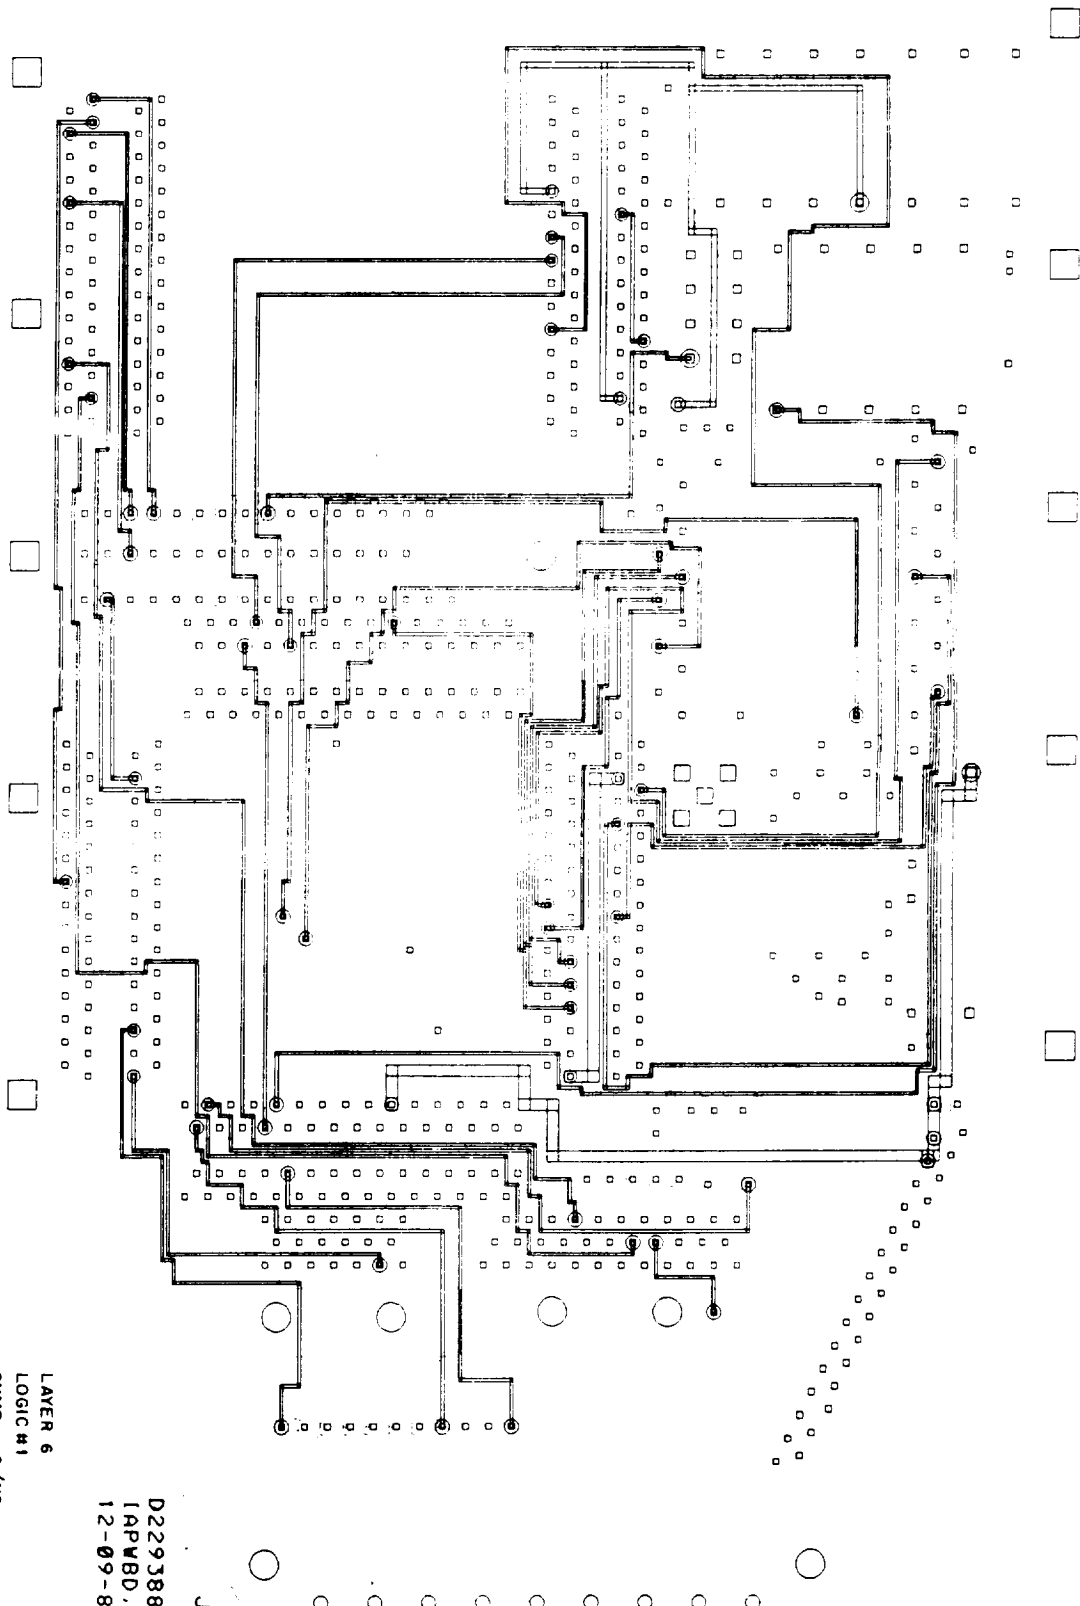

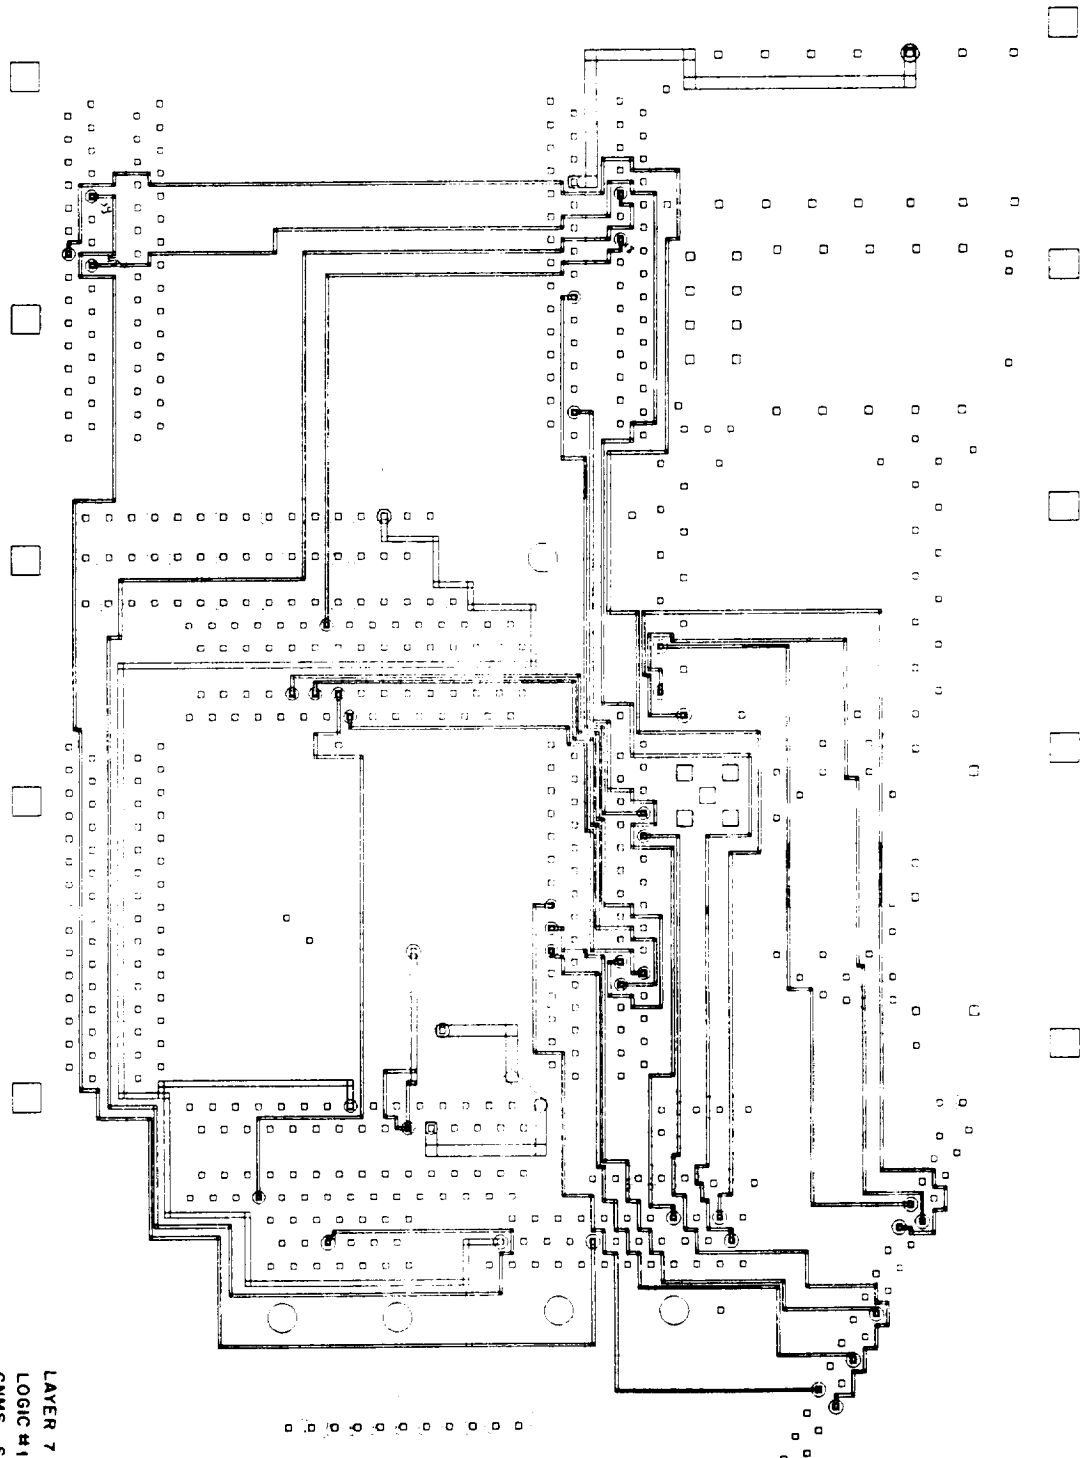

LAYER 7
LOGIC #1
GNMS S/M2
B E 6818

KA 
D229388PCREYB
(APWBD, UMICH)
12-09-81

MOUNTS - SEE DRAWN

AUTOM - THE VIEW IS FROM THE COMPONENT TOP SIDE

X
POINT




CONTROLLED

APR 21 1983


PRINT

PARTS PLACEMENT & BOTTOM LAYER
LOGIC #1
GMS
S/N2
H E GR12

D229388PCREVB
(APWBD, UMICH)
12-09-81

52841-13055A2880

L4

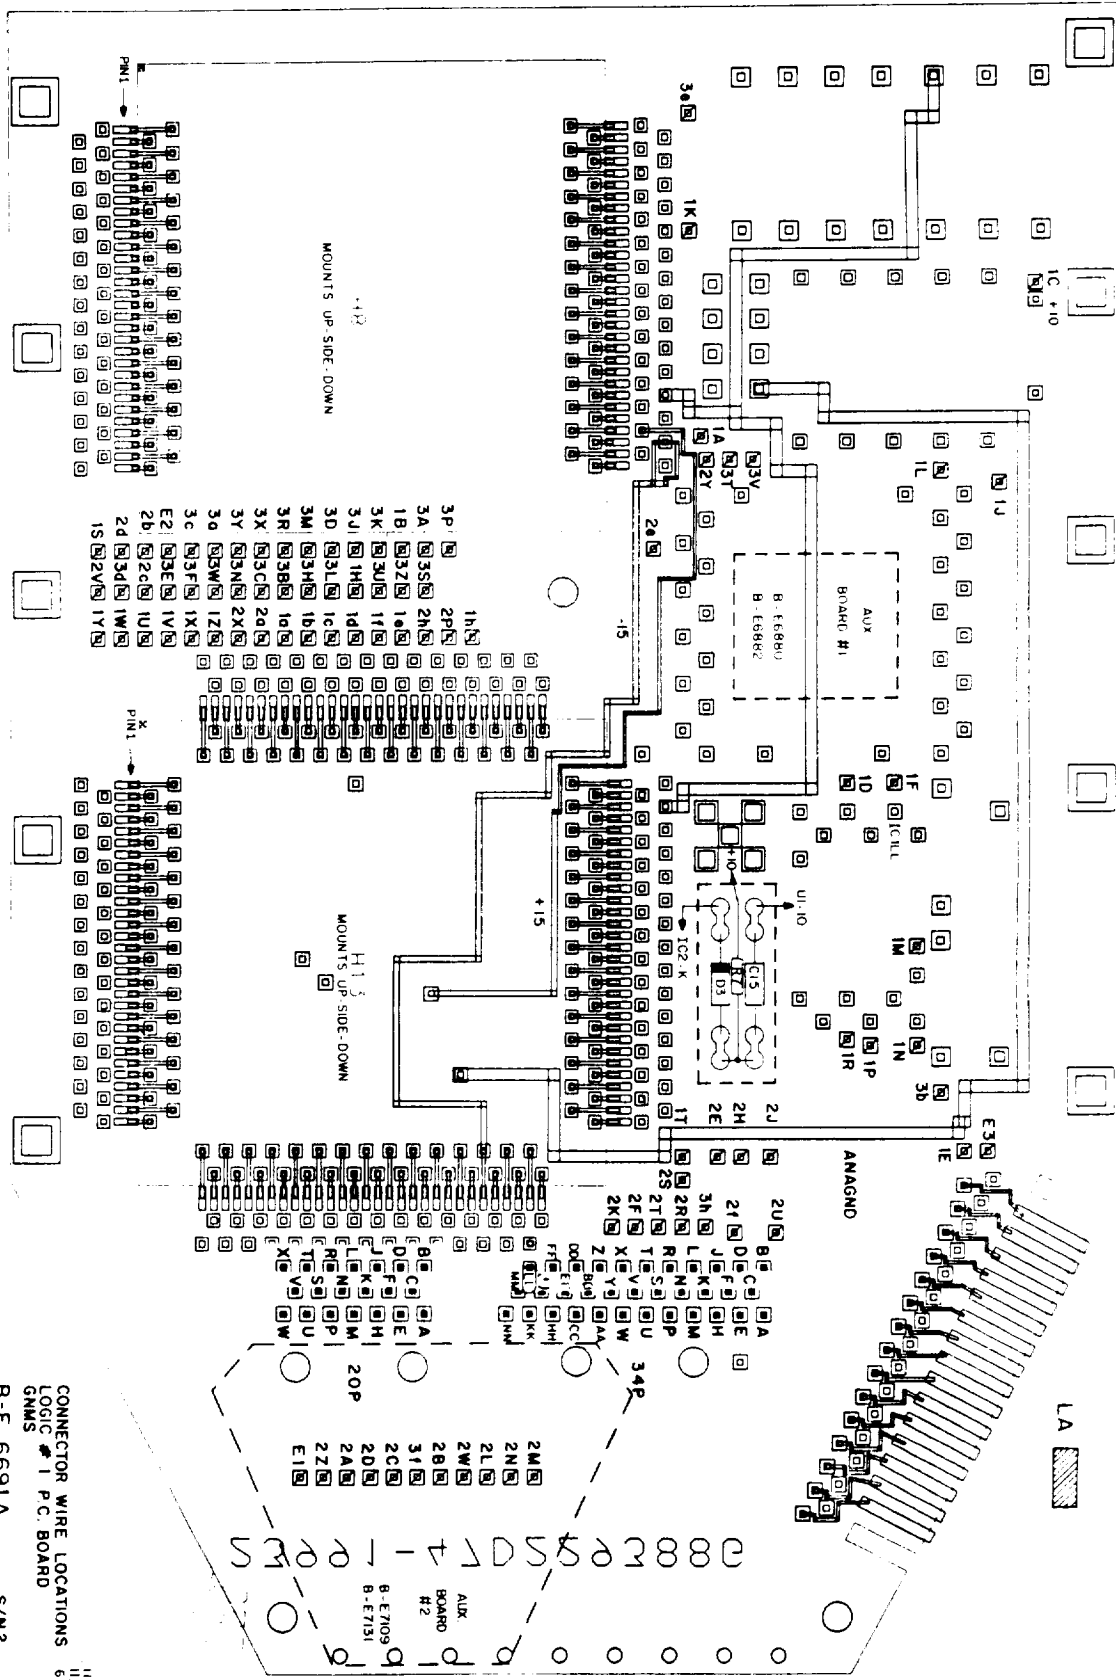


CAUTION THIS VIEW IS FROM THE COMPONENT (TOP) SIDE

CONTROLLED

11 15

CONNECTOR WIRE LOCATIONS
LOGIC #1 P.C. BOARD
GMS
11/24/83
11/2/83
6/1/82

B-E 6691A S/N2

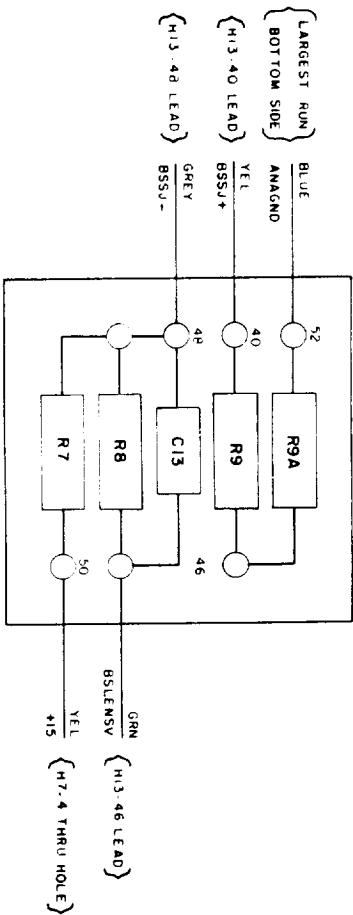


REFER TO B-E6880

ENGINEER: FREED / PINKUS	DRAFTSMAN: BT	5/27/82	
SPACE PHYSICS RESEARCH LABORATORY	LOGIC 1 AUX. BOARD	S/N 2	
COLLEGE OF ENGINEERING	GNMS		
UNIVERSITY OF MICHIGAN			
ANN ARBOR, MICHIGAN	B-E6882		
		6/1/82	
		DATE	

LAST USED R C D L


COMPONENT SIDE

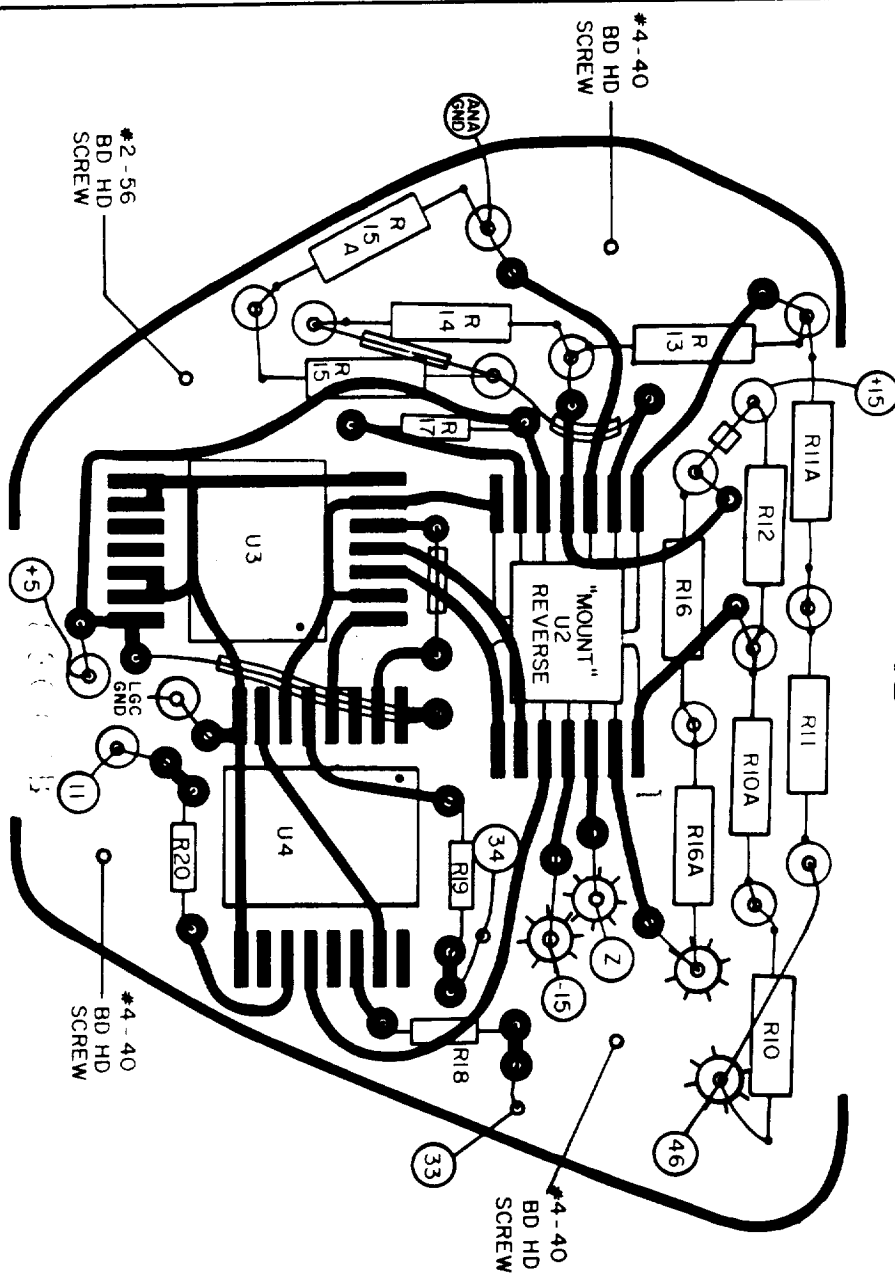

1. PROFILE #830068 TO OUTSIDE OF LINES.
2. #2520A-4 SWAGE TERMINALS REQUIRED.
3. #2520A-4 SWAGE TERMINALS MODIFIED.
4. #830068 AUX 2 BD (.031" THICK) MOUNTS TO LGC 1 BD WITH DELRIN SPACERS. SEE MECH DWG IN LGC 1 LOG BOOK.
5. COMPONENT U2 MUST BE MOUNTED UPSIDE DOWN, WITH LAYER OF KAPTON TAPE.
6. ALL WIRES EXITING FROM #830068 MUST SOLDER TO SWAGE TERMINALS OR STRESS LOOP ON A SIDE OF BD. R17, 18, 19 & R20 CUT LEADS OFF FLUSH WITH SURFACE ON A-SIDE

CONTROLLED
AUG 11 1983
PRINT

DESIGNED BY: BRUCK/MAN	DRAFTSMAN: MAH/MK	DATE: 8/11/83
SPACE PHYSICS RESEARCH LABORATORY		
UNIVERSITY OF MICHIGAN		
ANN ARBOR, MICHIGAN		
AUX. BOARD 2	DELTA IF - LOGIC 1	GALILEO NMS
B-E7131	CONTROLLED	DATE: 8/11/83

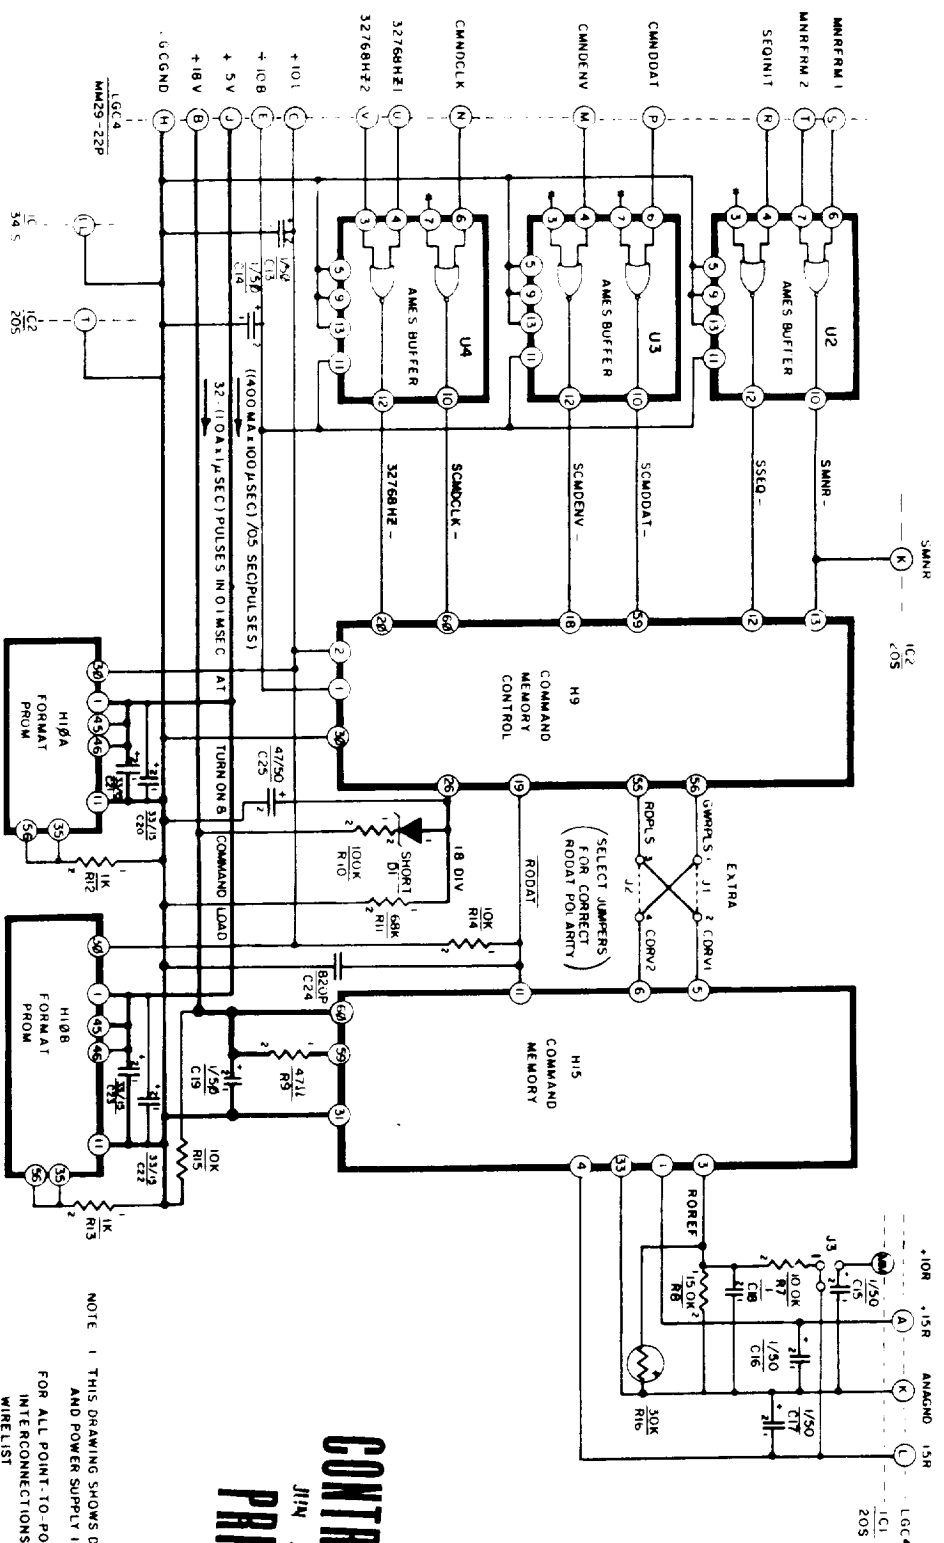


CONTROLLED
JUN 3 1985
PRINT


NOTE 1 THIS DRAWING SHOWS DISCRETE PARTS
AND POWER SUPPLY INTERCONNECTIONS
FOR ALL POINT-TO-POINT SIGNAL
INTERCONNECTIONS, SEE LOGCON PIN
WIRELIST
2 ALL RESISTORS SHOWN ARE
SELECT - AT - TEST VALUES

ENGINEER: WH PINKUS	4/7/80	DRAFTER: MFG	4/24/80
SPACE PHYSICS RESEARCH LABORATORY		LOGIC 2 PC SCHEMATIC	
COLLEGE OF ENGINEERING		GALILEO-NMS	S/N 3
UNIVERSITY OF MICHIGAN		B-E6948	CONTROLLED
ANN ARBOR, MICHIGAN			DATE

CASE USED R₁₄ C₂₃ D L

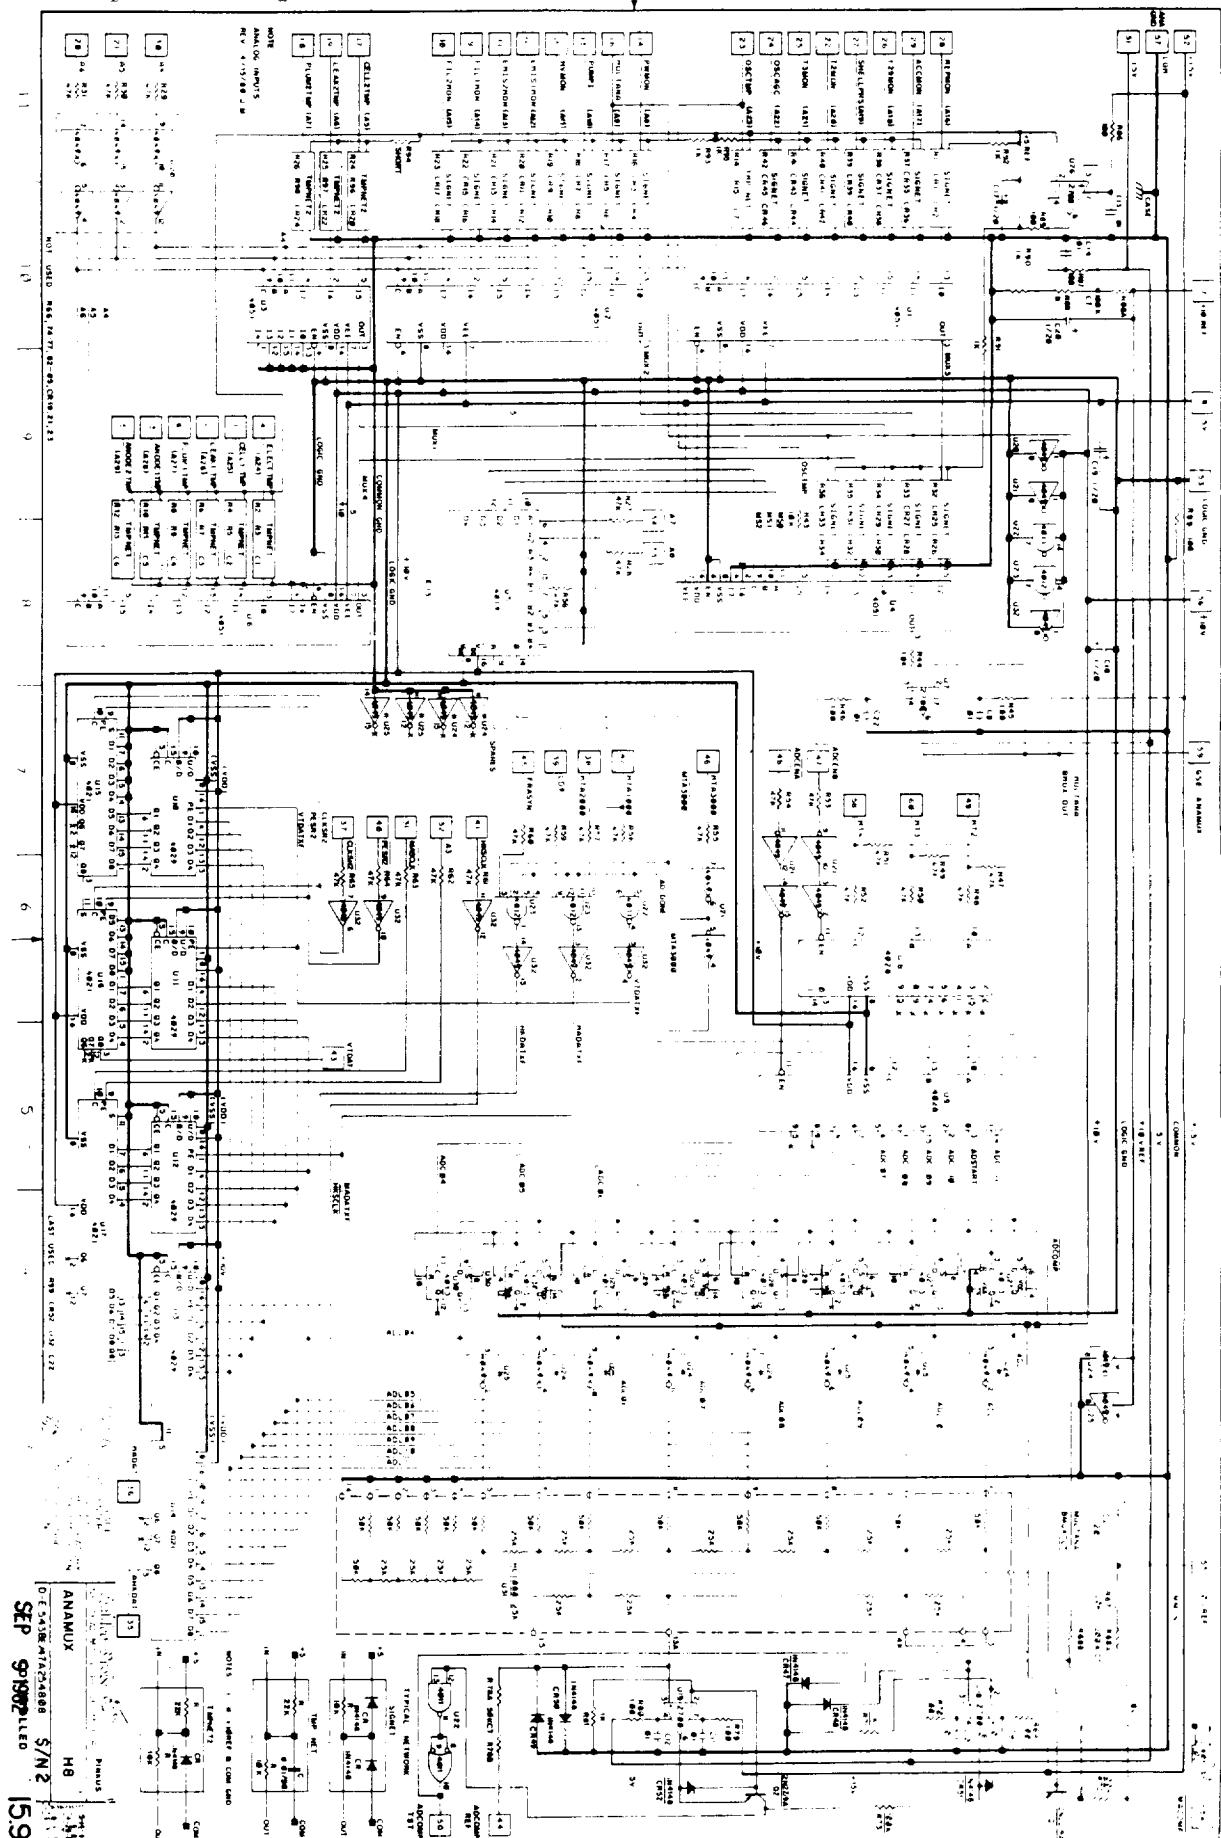

ANAMUX
SEP 9 1992 LEO
159

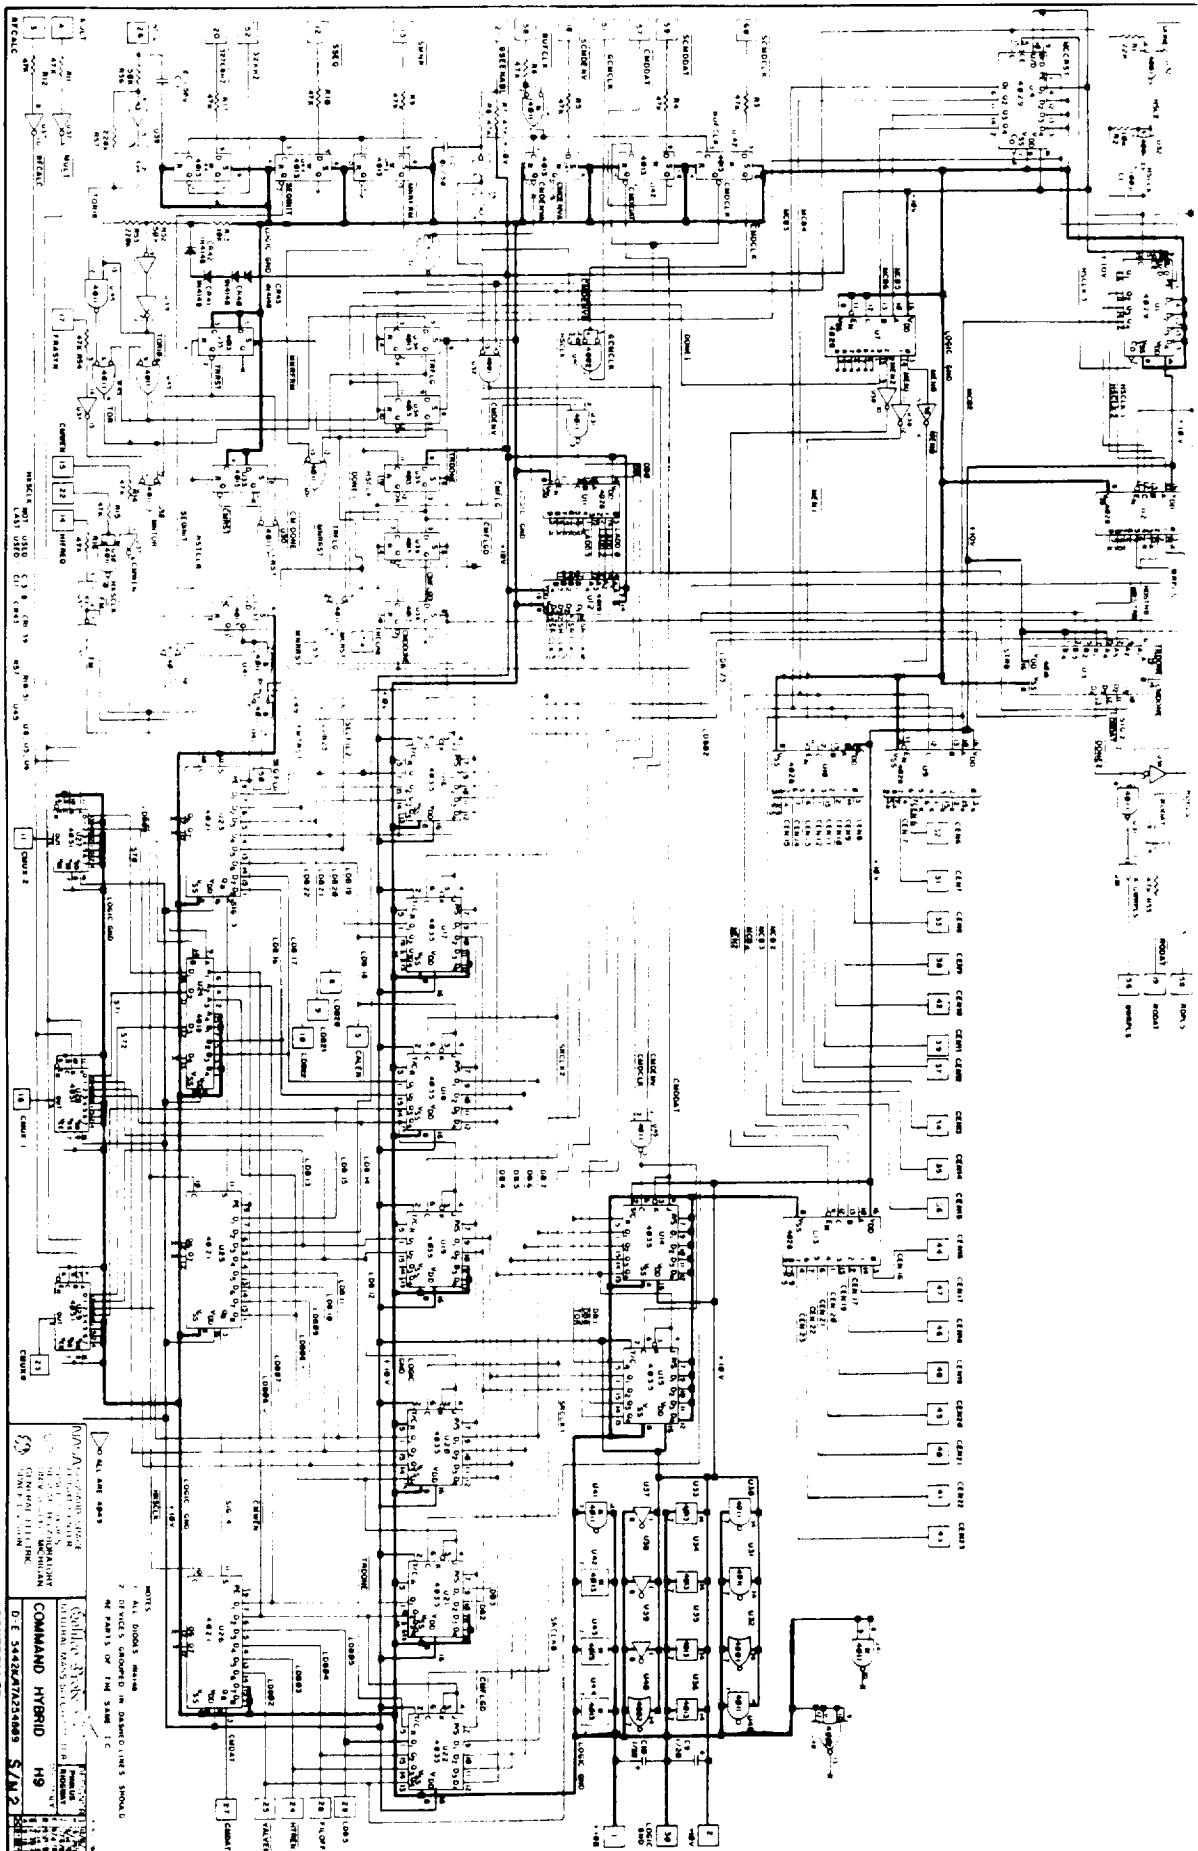


SEP 9 1982 15:10

CONTROLLED

COMMAND HYBRID
S/N 2

NOTES:
1. DO NOT REMOVE
2. DEVICES SHOWN IN DISCONNECTED STATE
3. PARTS OF THE SAME TYPE

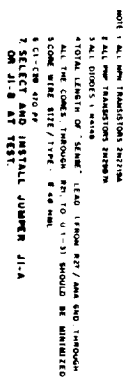

SEP 14 1966

(Bullfinch) 3700c	DE SIGNER
NEUTRAL MASS SPECTROMETER	PRINTER
CORE MEMORY	HIS
O-68204H / 417254815	S/N 2

CONTROLLED


```
*****
*                               *
* LOGIC : PC BOARD CONNECTION LIST *
*                               *
* INPUT FILE FOR NODE NAME SUMMARY *
*                               *
*****
```

ED LGC4 29 P
*9-29-81

3-31-81
Include new pinout for H9, & H10

4-13-81

Revise H15 pins per latest GE pinout, (per phone from J. Booth).

5-4-81
Revise H9 pins 37, 38, 39 to correct original
GE lists. [CEN9, CEN11, CEN12]

5-15-81

Change H9, CMUX0 and CMUX2, pin assignment.
Previous prints had H9 pins 11 and 23 reversed.

Changed IC2 from a 345 to

and CMDAT-

8-26-81

9-9-81

9-29-81

Corrected spelling of CMUX0 on IC2

6-22-82

11-8-82

5-6.83 Added MTA1000 to IC1-T and ICGND to IC1-

(THRU LG2 FOR THIS MON)

EDIT'S.....
3/10/81

Included newest board connector list

Removed PC Board, added buffers, resistors caps, jumper, A01's to A1's etc.

Include new pinout for H9, & H10

... of book and change

Revise M15 pins per latest GE pinout, (per phone from J. Booth).

Revise H9 pins 37, 38, 39 to correct original GE lists. [CEN9, CEN11, CEN12]

the following:

Change H9, CMUX0 and CMUX2, pin assignment.
Previous prints had H9 pins 11 and 23 reversed.

Channelled IC2 from a 34s to

and CMDAT-

"T" of TC3 plug.

connector from S to P.

Corrected spelling of CMUX0 on IC2


014 sh33333 B7D1 to -15B

Added MTA1000 to IC1-T and ICGND to IC1-

11.18

H9		H10A		H10B		H10C		

LC2CON.PIN NO. SIGNAL	22-Jun-82 PLUG PIN	LC2CON.PIN NO. SIGNAL	06-May-83 PLUG PIN	92 RODAT-	H9 19
1 +10B	LCG4 E	16 A12A	IC1 R	36 CEN14	H9 35	62 D3	IC2 D	81 LDB5	IC1 U	93 KOREF	H9 11		
	H9 1		H10A 17	37 CEN15	H9 26		H10A 57	82 LGCGND	LCG4 H		H9 11		
	U2 11	17 A13A	IC1 S		H9 36		H10B 57		IC1 LL		H9 11		
	U3 11		IC2 R	38 CEN16	H9 25	63 D4	IC2 E		IC2 T		H9 11		
	U4 11	18 A13A-	IC2 R	39 CEN17	H9 44		H10A 60		IC2 T		H9 11		
2 +10L	LCG4 C		IC2 R		H9 47		H10B 60		H9 30	94 SCHDCLK-	H9 11		
	H9 2	19 A2	IC1 D	40 CEN18	H9 14	64 D5	IC2 F		H10A 11	95 SCHDDAT-	H9 11		
	H10A 30		IC2 D		H9 46		H10A 31		H10B 11		H9 11		
	H10B 30		IC1 2		H9 15		H10B 31		H9 31	96 SCHDENV-	H9 11		
	IC13 2	20 A3	IC1 E	41 CEN19	H9 48	65 D6	IC2 H		U2 5		H9 18		
	IC14 2		IC1 E		H9 13		H10A 32		U2 9	97 SEL FIL 2	H9 12		
3 +10R	IC1 MH	21 A4	IC1 F	42 CEN20	H9 45	66 D7	H10B 32		U2 13		H9 6		
	IC13 2		IC1 F		H9 45		IC2 J		U3 3	98 SEQFLG	H9 6		
	IC15 2		IC1 F	43 CEN21	H9 40		H10A 33		U3 9		H9 50		
4 +15R	LCG4 A		IC1 F		H9 16		H10B 33		U3 13	99 SEQUINIT	H9 13		
	IC16 2	22 A5	IC1 H	44 CEN22	H9 41	67 ENROM	IC2 EE		U4 5		H9 4		
	IC19 2		IC1 H		H9 20		H10A 12		U4 9	100 SMNR-	H9 13		
5 +18V	LCG4 B	23 A6	IC1 H	45 CEN23	H9 43		H10B 12		U4 13		H9 10		
	IC19 2		IC1 J		H9 18	68 FILSOFF	LCG4 C		C13 1	101 SSEQ-	H9 10		
	IC19 2		IC1 J	46 CEN26	H9 32		IC2 P		C14 1	102 THP PWR	H9 12		
6 +5V	LCG4 J	24 A7	IC1 K	47 CEN27	H9 29	69 FTRST	LCG4 b		C19 1		H9 12		
	IC10 2		IC1 K		H9 31		IC2 V		C20 1	103 TRDOME	H9 12		
	IC10 2		IC1 K	48 CEN8	H9 30		IC2 V		C21 1		H9 12		
	IC10 4	25 A8	IC1 L		H9 33	70 FRASYN	IC2 P		C22 1	104 VALVEN-	H9 12		
	IC10 4		IC1 L	49 CEN9	H9 28		IC2 P		C23 1		H9 12		
	IC10 4		IC1 L		H9 38	71 GCMLK	IC2 51		R11 1	105 VBUS H10A	H9 12		
	IC10 4		IC1 M	50 CNDAT	H9 23		IC2 51		R12 1		H9 12		
	IC10 4	26 A9A	IC1 M		H9 27	72 GSEFNABLI-	LCG4 M		R13 1		H9 12		
	IC10 4		IC1 M	51 CHDDAT-	H9 22		IC2 M		U2 6	106 VBUS H10B	H9 12		
	IC10 4		IC1 M		H9 57		IC2 M		U2 6		H9 12		
7 -15R	LCG4 L	27 ANAGND	IC1 K	52 CHNDCLK	H9 57	73 GMRPLS	IC2 21		U2 7		H9 12		
	LCG4 L		IC1 K		H9 56		IC2 21		U2 7		H9 12		
	LCG4 L												

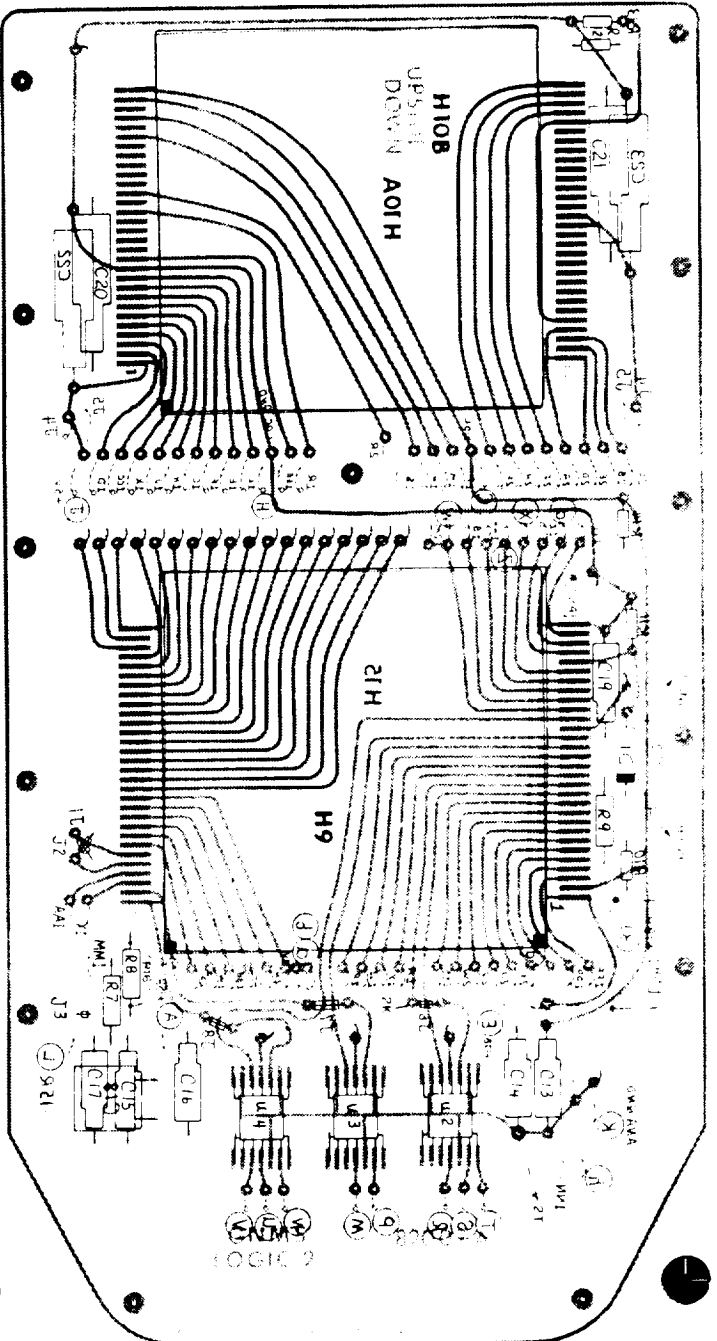


CONTROLLED
JUN 3 1985
PRINT

CIRCUIT SIDE


NOTE: H10B THERMISTOR FROXED TO H10

ENGINEER MAURER		COMPONENT LAYOUT REVERSE	
SPACE PHYSICS RESEARCH LABORATORY		LOGIC 2 BOARD	
COLLEGE OF ENGINEERING		S/N 2	
UNIVERSITY OF MICHIGAN		DATE	
ANN ARBOR MICHIGAN		BE-6906 CONTROLLED	

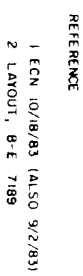

ENGINEER B BLOCK	DRAFTSMAN C WIGGINS	9/2/82	
SPACE PHYSICS RESEARCH LABORATORY	AUX BOARD 1		
COLLEGE OF ENGINEERING	LOGIC 2		
UNIVERSITY OF MICHIGAN	GALILEO - NMS	S/N 2	
ANN ARBOR MICHIGAN	B-E 6915A CONTROLLED		DATE
			10/16/83

COMPONENT SIDE

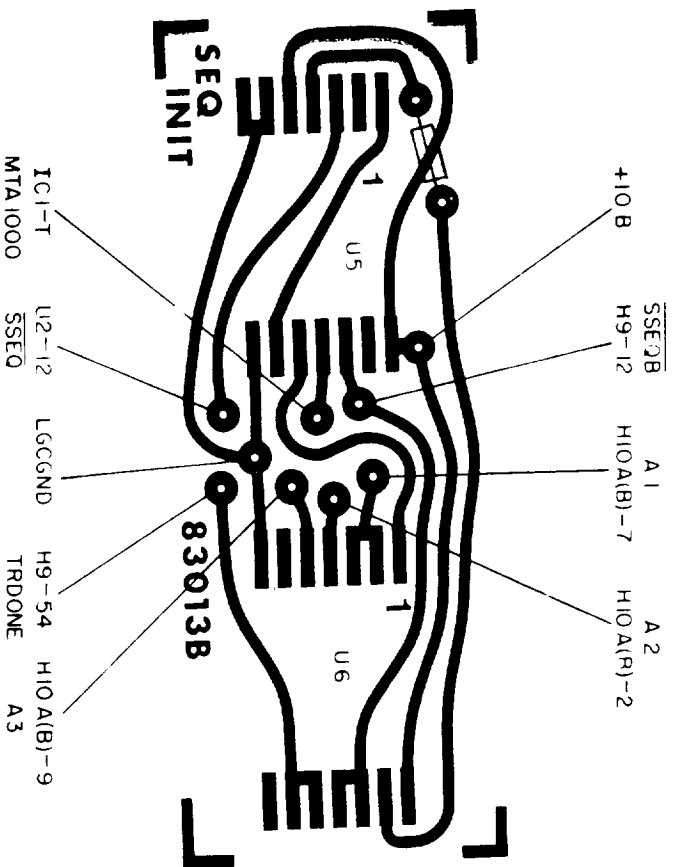


NOTES:

- 1) .031" PC LAMINATE
- 2) CUT MAIN BOARD RUN BETWEEN U2-12 AND H9-12 AND RECONNECT EACH SIDE TO AUX. BD
- 3) REF. ECM 10/18/83, B-E-6915 A

CONTROLLED
NOV 21 1983
PRINT


ENGINEER: B BLOCK-MAH	10/18/83	DRAFTSMAN: J. J. W.	11/8/83
SPACE PHYSICS RESEARCH LABORATORY		COMPONENT LAYOUT	
COLLEGE OF ENGINEERING		SEQ. INIT. AUX. BD.	S/N 2
UNIVERSITY OF MICHIGAN		LOGIC # 2	10/18/83
ANN ARBOR MICHIGAN		B-E-7189 CONTROLLED	DATE


LAST USED R C D L

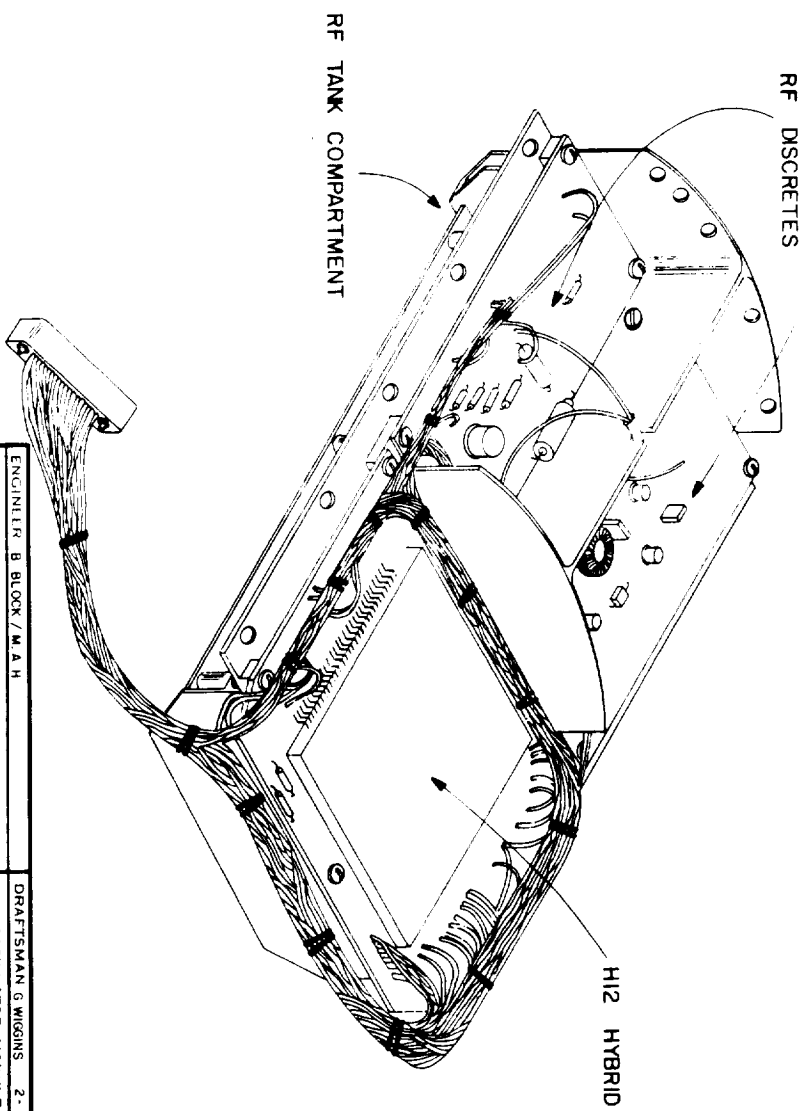


ENGINEER: B. BLOCK / M.A.H.	DRAFTSMAN: G. WIGGINS	2-16-79
SPACE PHYSICS RESEARCH LABORATORY	R. F. OSCILLATOR MODULE	
COLLEGE OF ENGINEERING	GNMS	
UNIVERSITY OF MICHIGAN		
ANN ARBOR, MICHIGAN	B-E5095	
		DATE
		2-18-82

LAST USED: R C D L

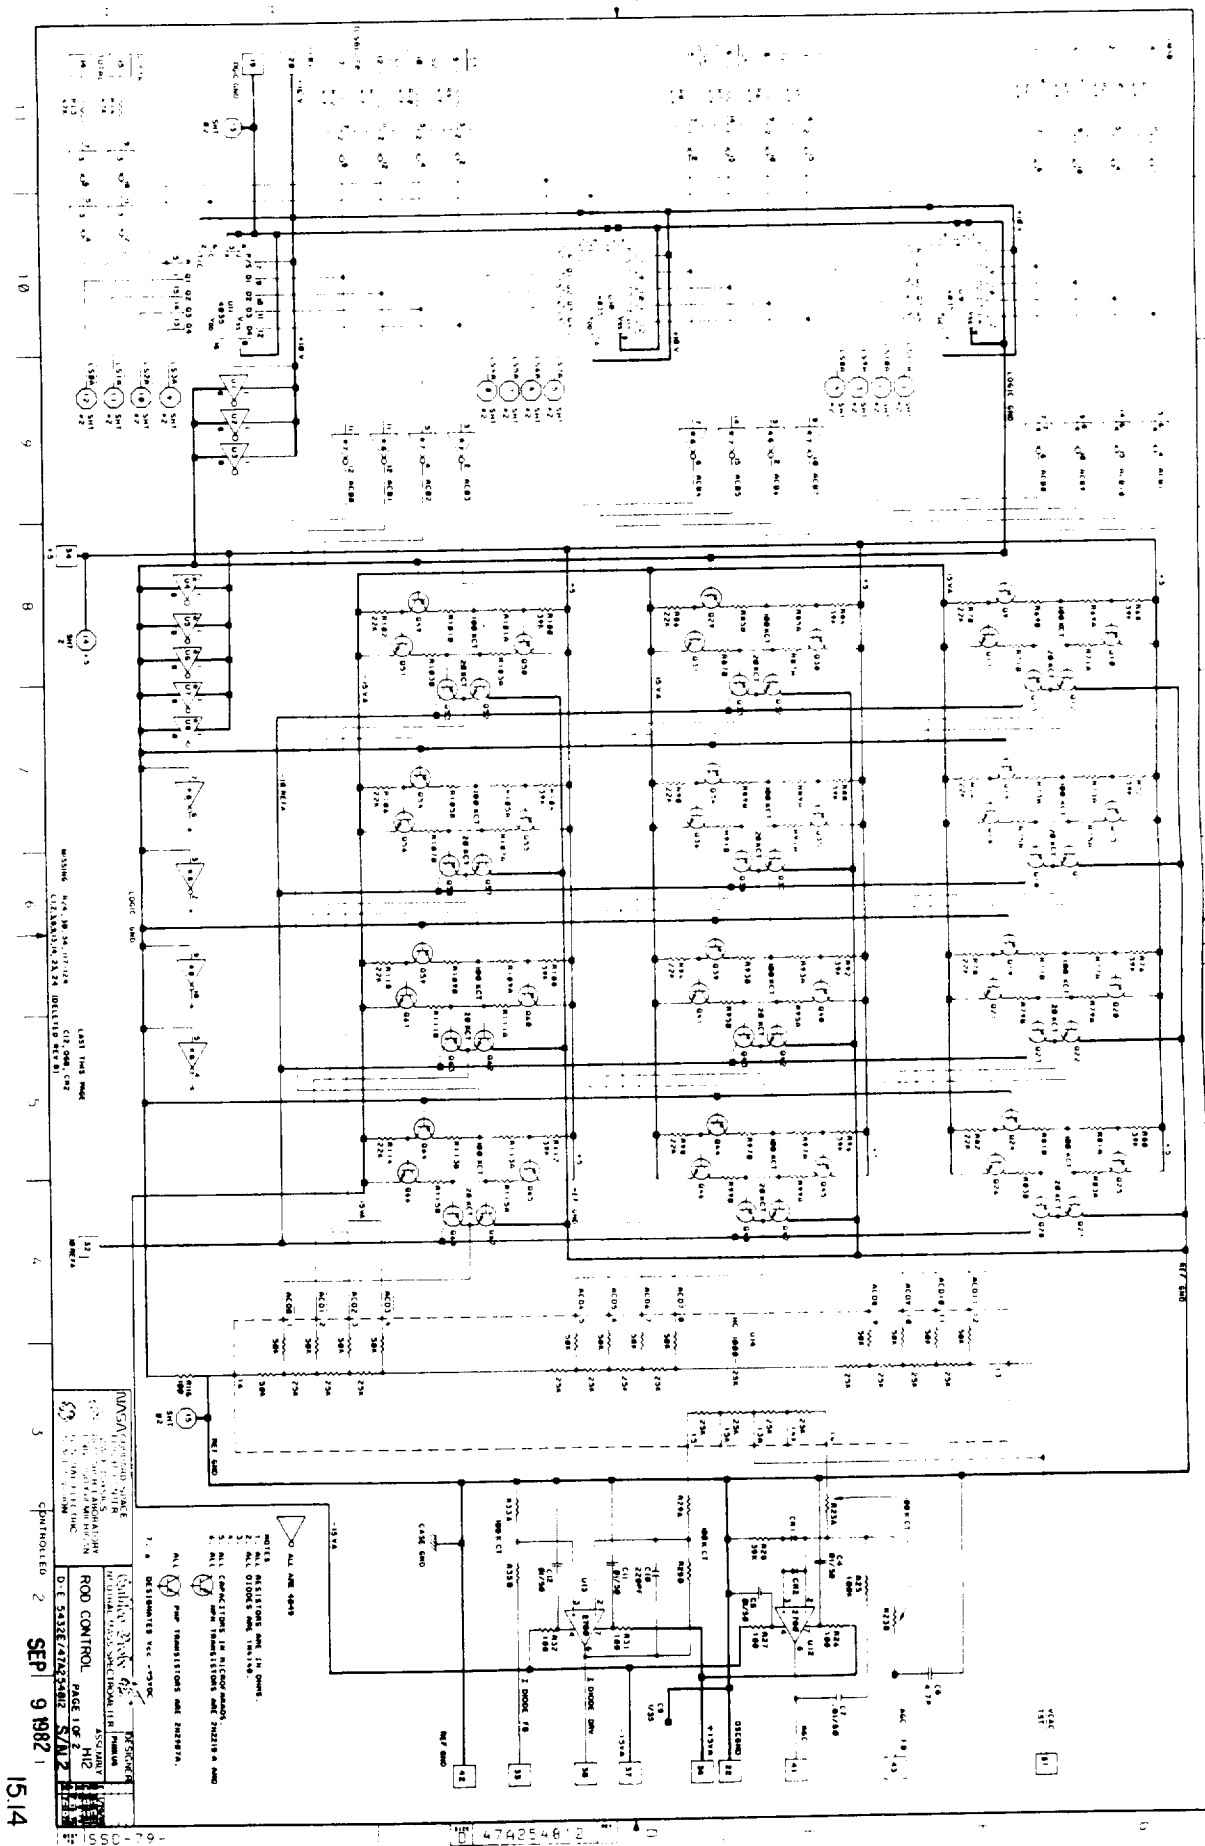


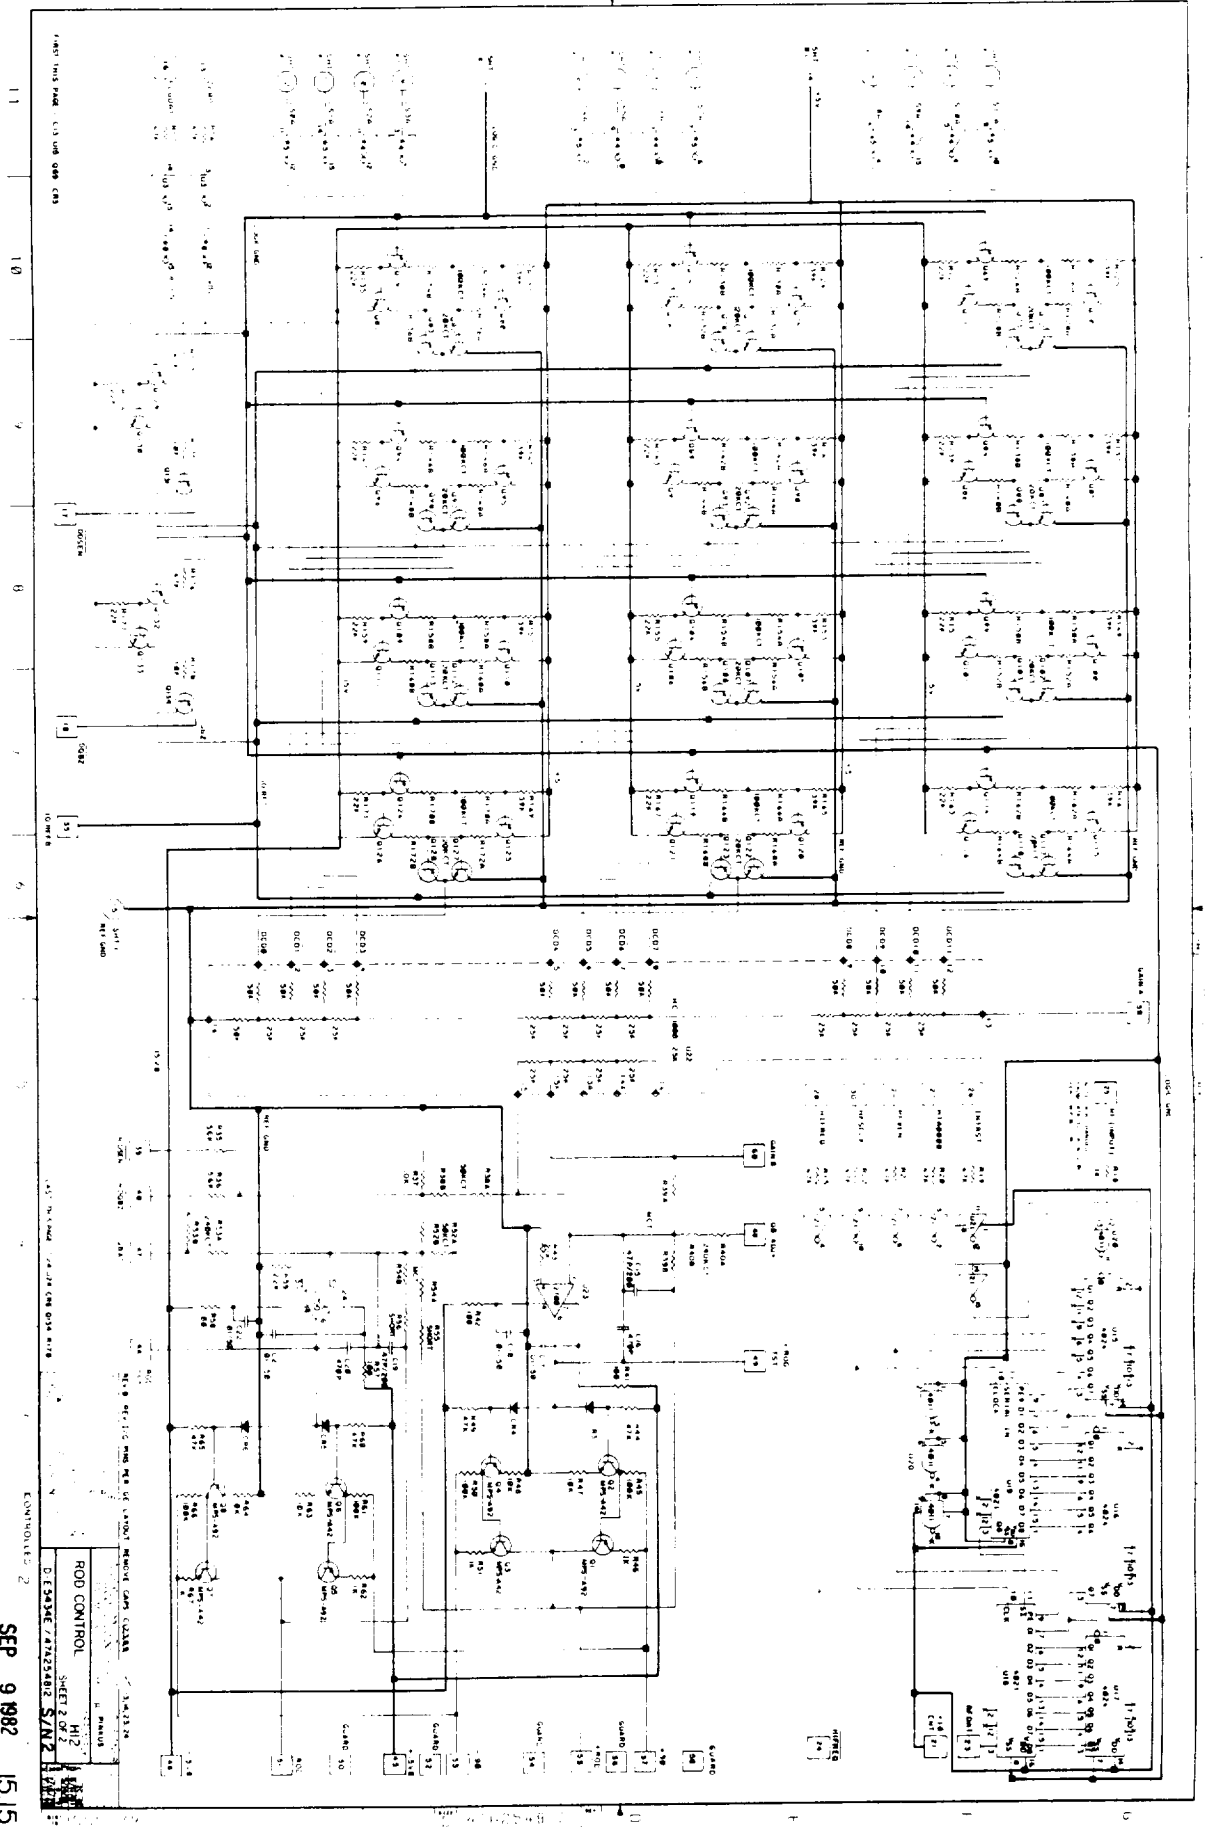

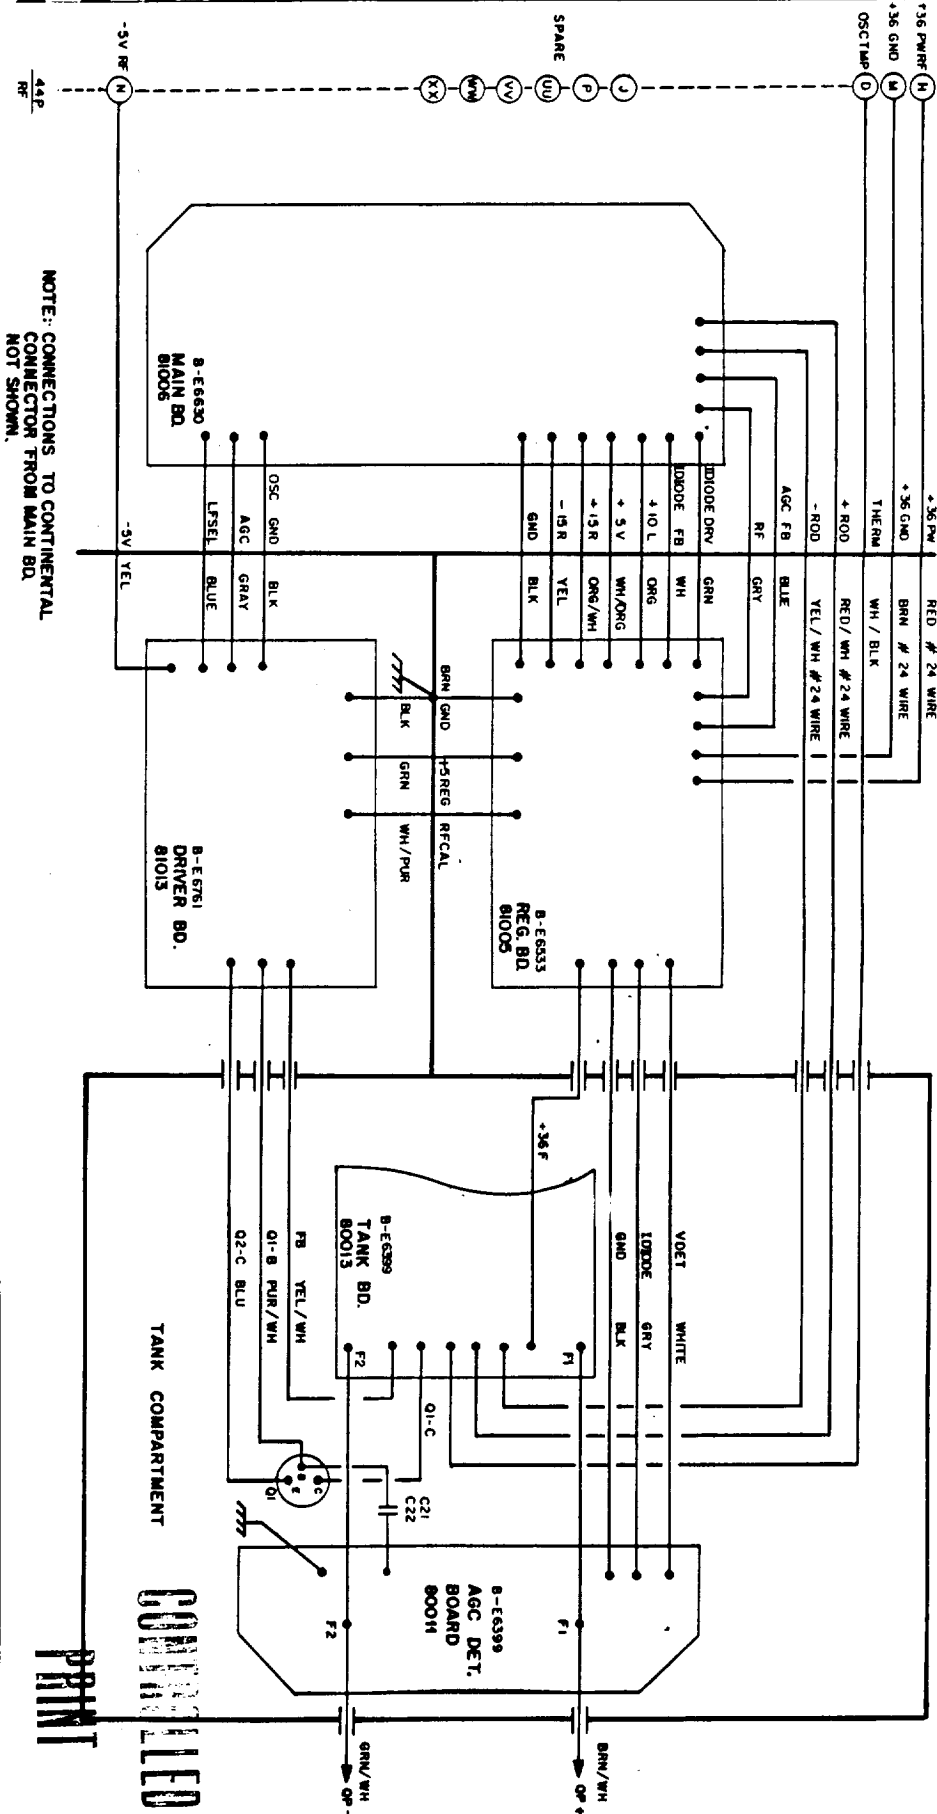

NOTE: CONNECTIONS TO CONTINENTAL CONNECTOR FROM MAIN BD. NOT SHOWN.

ENGINEER	B BLOCK		
SPACE PHYSICS RESEARCH LABORATORY COLLEGE OF ENGINEERING UNIVERSITY OF MICHIGAN ANN ARBOR, MICHIGAN		DRAFTSMAN	M/RN
		INTERCONNECT PLAN RF OSCILLATOR GALILEO RMS	6/30/81
B-E6625		CONTROLLED	
			5/5/82
			7/13/81
			7/2/81
		DATE	

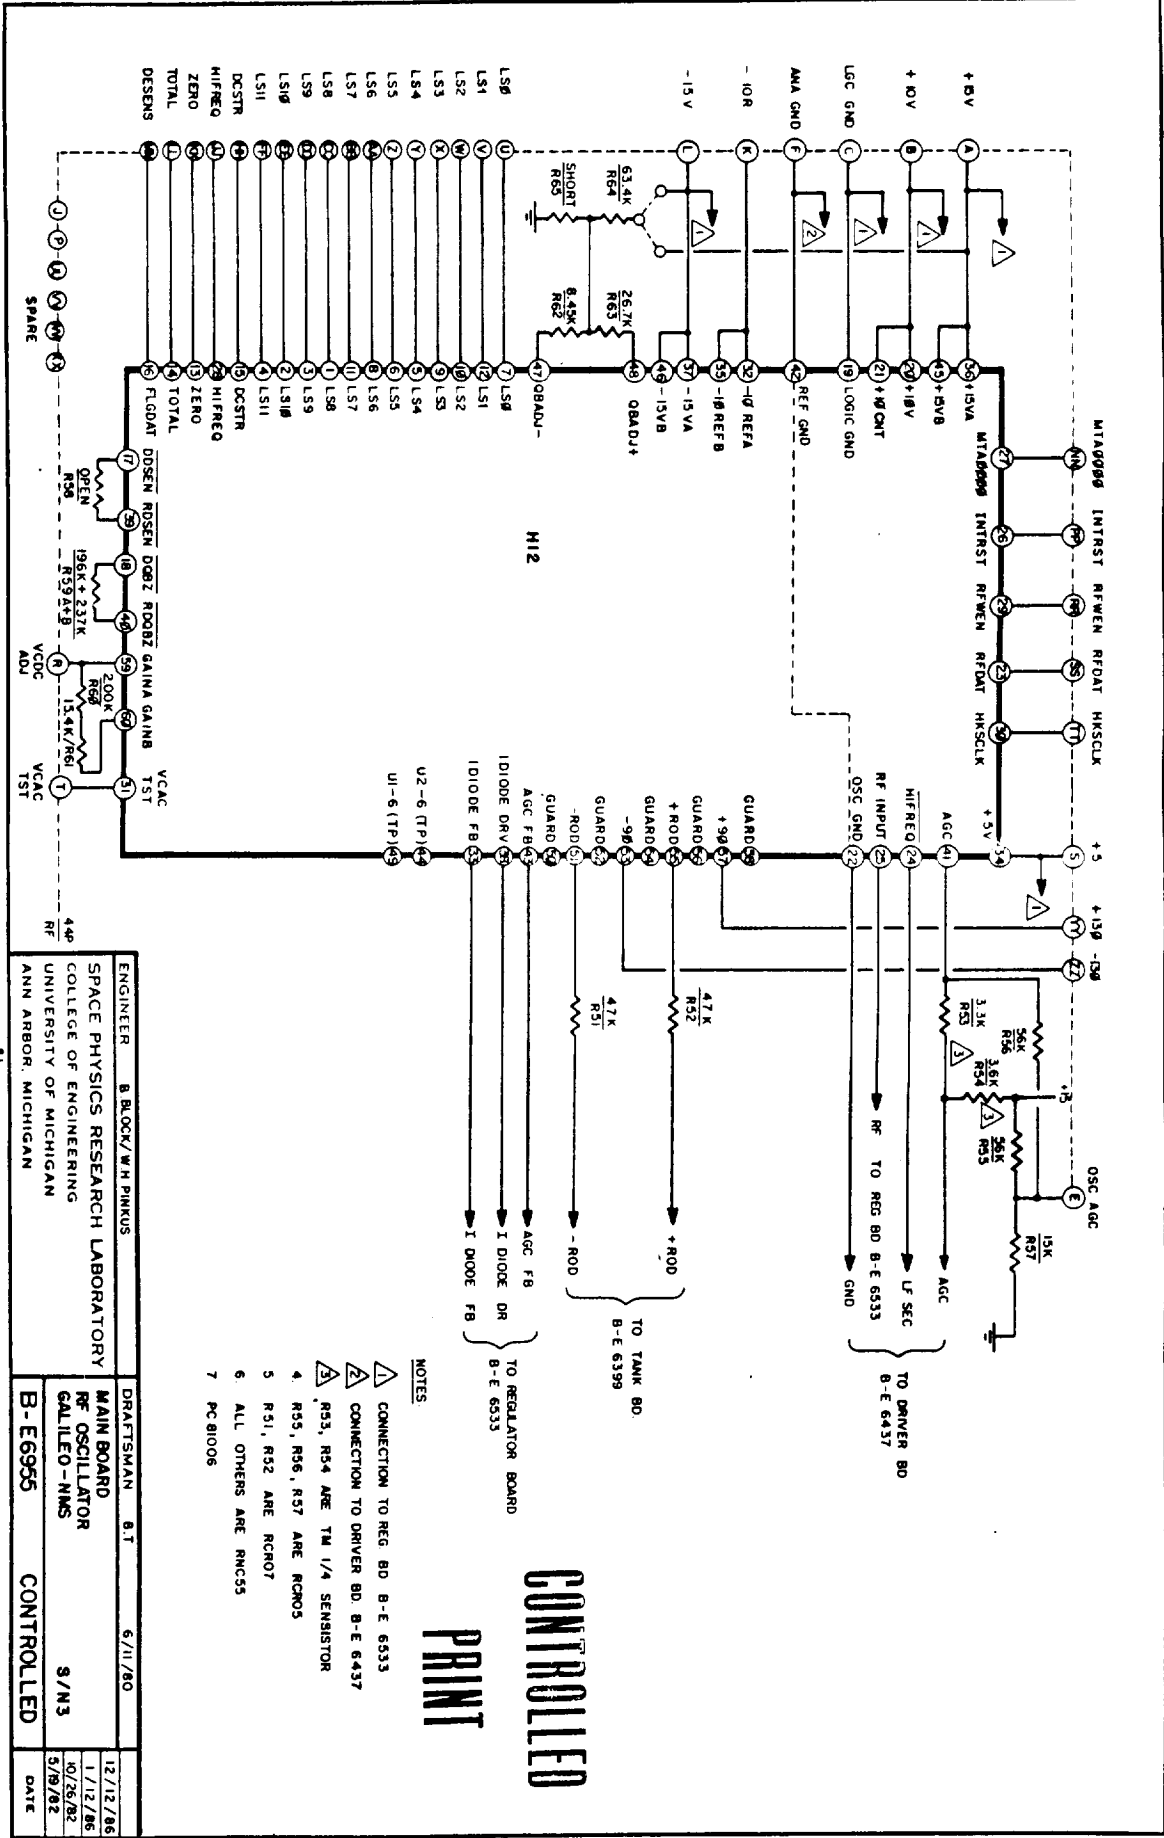


**CONTROLLED
PRINT**

NOTES:

- 1 CONNECTION TO REG. BD. B-E 6533
- 2 CONNECTION TO DRIVER BD. B-E 6437
- 7 PC 81006

ENGINEER	B. BLOCK/WH. PINKUS	DRAFTSMAN	B.T.	6/11/80
SPACE PHYSICS RESEARCH LABORATORY				
COLLEGE OF ENGINEERING				
UNIVERSITY OF MICHIGAN				
ANN ARBOR, MICHIGAN				
MAIN BOARD		DATE		
RF OSCILLATOR		12/12/86		
GALILEO-NMS		1/12/86		
B-E 6955		5/8/82		
CONTROLLED		DATE		

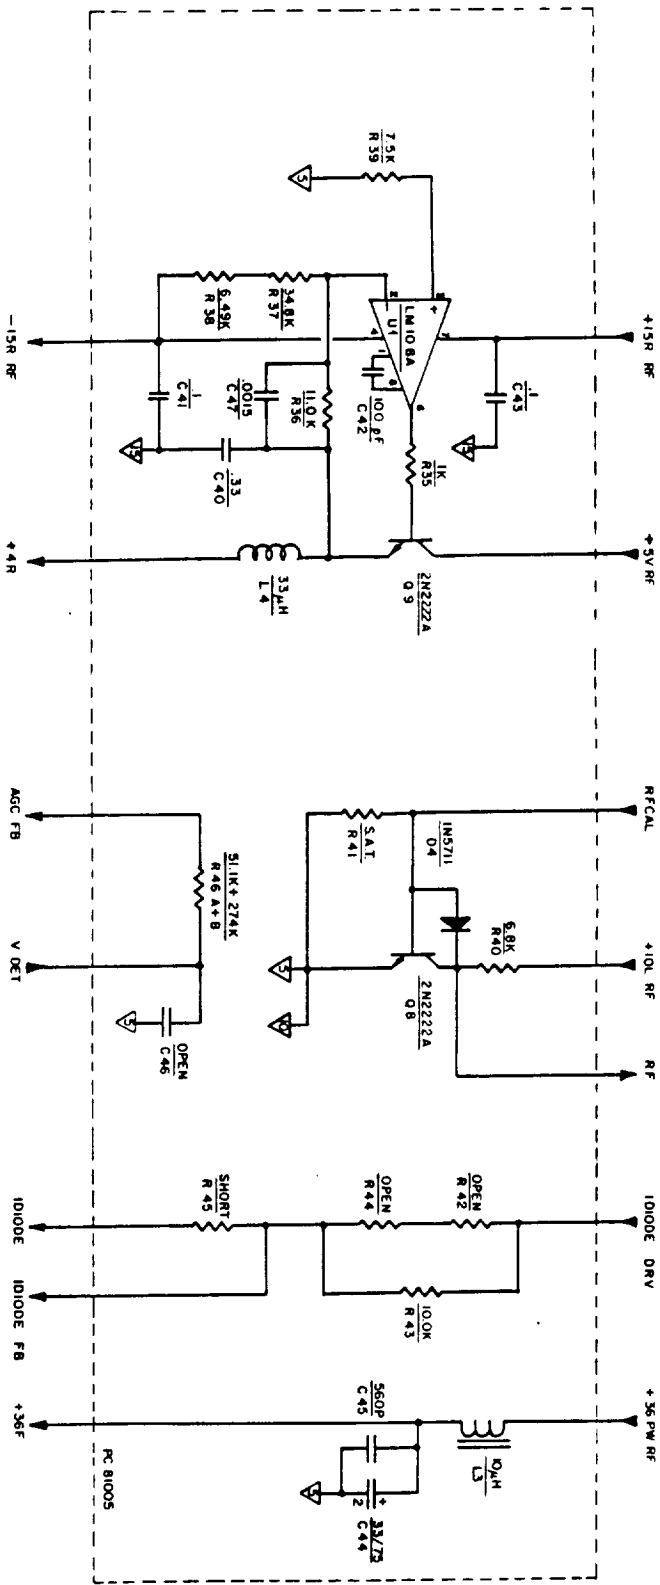


CONTROLLED
PRINT

ENGINEER	B BLOCK	DRAFTSMAN	08 J
SPACE PHYSICS RESEARCH LABORATORY		REGULATOR BOARD	
COLLEGE OF ENGINEERING		RF OSCILLATOR	
UNIVERSITY OF MICHIGAN		GALEO NMS	S/N 3
ANN ARBOR, MICHIGAN		B-E-6950	CONTROLLED
		DATE	

LAST USED R46 C40 D L3

12.15

COMPONENT
SIDE

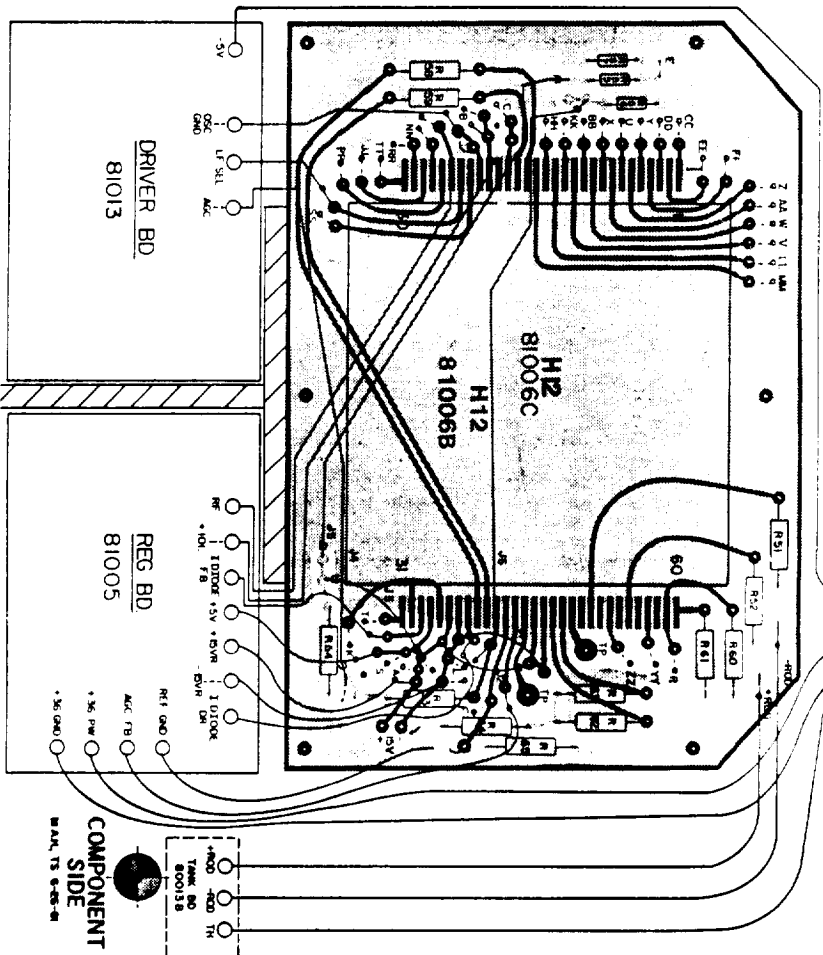


NOTE: Δ REMAINS CONNECTIONS TO
CONTINENTAL CONNECTOR FROM
MAIN BOARD NOT SHOWN.

CONTROLLED
PRINT

LAST USED R C O L

ENGINEER	B. BLOCK/M.A.H.
SPACE PHYSICS RESEARCH LABORATORY	
COLLEGE OF ENGINEERING	
UNIVERSITY OF MICHIGAN	
ANN ARBOR, MICHIGAN	
DRAFTSMAN	S. WIGGINS
DATE	5/19/82
COMPONENT LAYOUT COMPOSITE	
MAIN R.F. BOARD	
QMS	5/19/82
B - E6642A CONTROLLED	

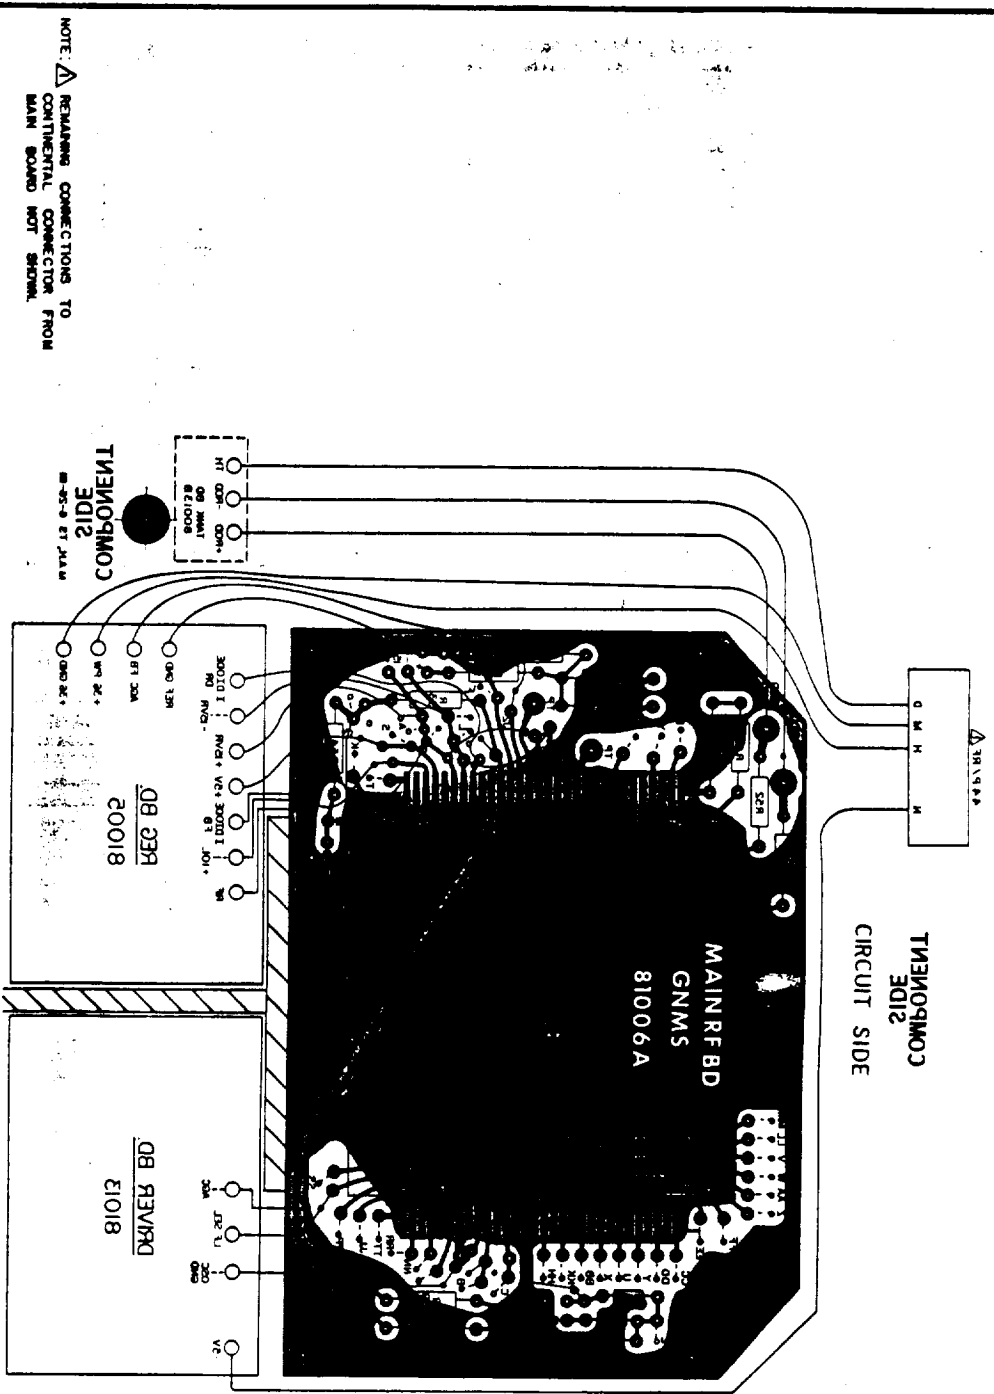


LAST USED R C D L

ENGINEER B. BLOCK/MAH	
SPACE PHYSICS RESEARCH LABORATORY	
COLLEGE OF ENGINEERING	
UNIVERSITY OF MICHIGAN	
ANN ARBOR, MICHIGAN	
UNCONTROLLED	
PRINT	
DRAFTSMAN G. WIGGINS	5/19/82
LAYOUT COMPOSITE REVERSE	
MAIN RF BOARD	
GNMS	
B-E6644A CONTROLLED	
DATE	5/19/82

COMPONENT SIDE COMPONENT SIDE


- ⚠ +4R AND RF CAL WIRES
DRESS TO REG BD**

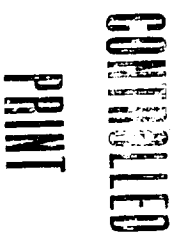

CONTROLLED	DATE
FLAYOUT BOARD 01013 P.1 OF 2	12/20/03 5/19/02

12.18A'

COMPONENT SIDE

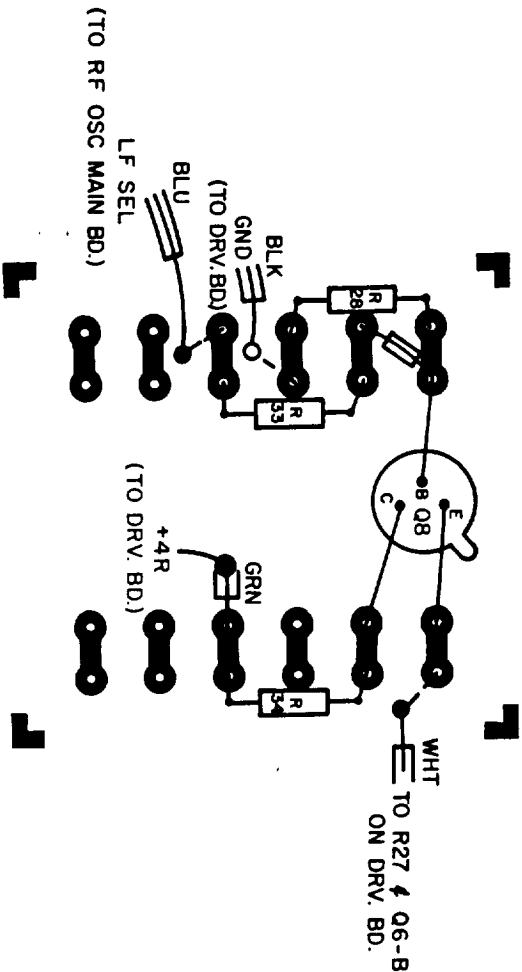

NOTES:

1. ALL AUX. BD. WIRES CONNECT TO DRV. BD. EXCEPT LINE
2. DRV. AUX. BD. .031" CONTROLLED
3. PC #820128 MODIFIED


PRINT

ENGINEER B BLOK/M.A.H.	DRAFTSMAN MK	2/9/84
SPACE PHYSICS RESEARCH LABORATORY	COMPONENT LAYOUT	
COLLEGE OF ENGINEERING	RF OSC. DRV. AUX. BD.	P. 2 OF 2
UNIVERSITY OF MICHIGAN	GNMS	12/20/83
ANN ARBOR, MICHIGAN	B-E7227 CONTROLLED	DATE

LAST USED R C D L

12.18B

COMPONENT SIDE

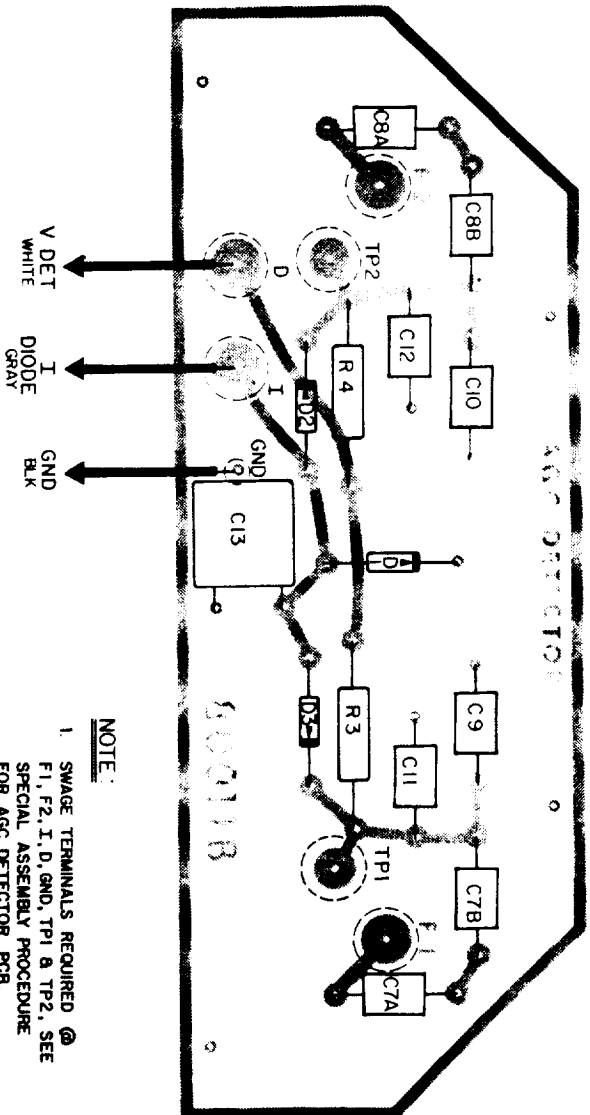


NOTE:

1. SWAGE TERMINALS REQUIRED @ F1, F2, I, D, GND, TP1 & TP2, SEE SPECIAL ASSEMBLY PROCEDURE FOR AGC DETECTOR PCB.


2. ○ INDICATES SWAGE TERMINALS.

AGC DETECTOR
R.F. OSCILLATOR
GALILEO N.M.S.
M.A.H., G.A.W. 7/12/81

ENGINEER, B. BLOCK, M.A.H.	DRAFTSMAN, M.N.	7/29/81
SPACE PHYSICS RESEARCH LABORATORY	COMPONENT LAYOUT COMPOSITE	
COLLEGE OF ENGINEERING	AGC DETECTOR BD 80011B	
UNIVERSITY OF MICHIGAN	GMS	5/9/82
ANN ARBOR, MICHIGAN	B-E6663 CONTROLLED	DATE

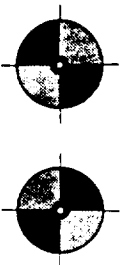

COMPONENT SIDE

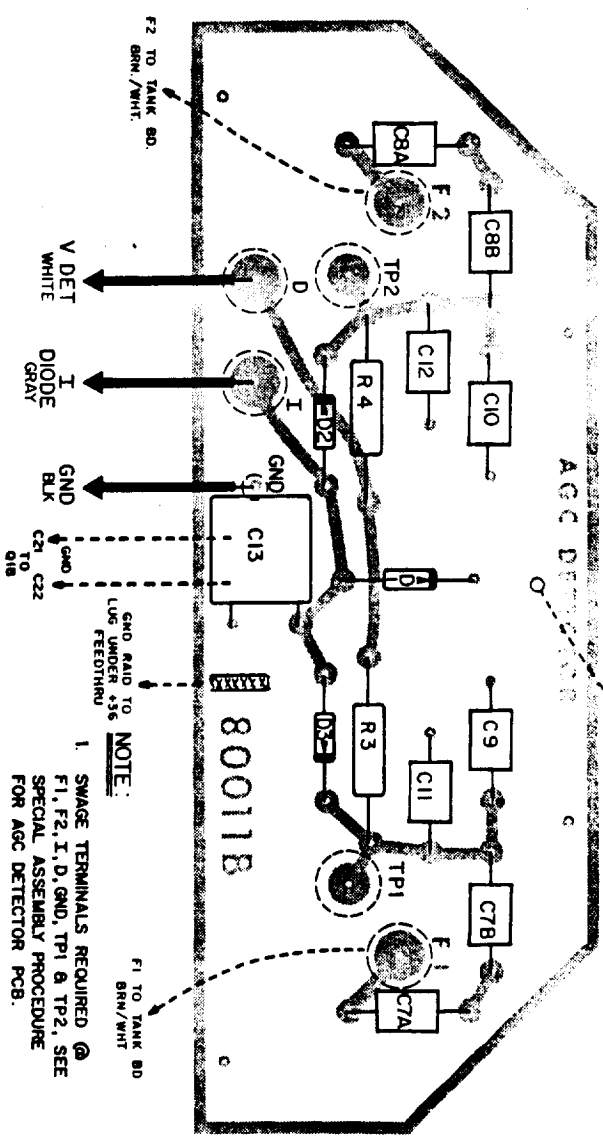

- NOTE:**
1. SWAGE TERMINALS REQUIRED @ F1, F2, I, D, GND, TP1 & TP2. SEE SPECIAL ASSEMBLY PROCEDURE FOR AGC DETECTOR PCB.
 2. ○ INDICATES SWAGE TERMINALS.

AGC DETECTOR
R.F. OSCILLATOR
GALLED N.M.S.
M.A.H., G.A.W. 7/12/81

2540-84 (1/16 DRILL) 2FLS
2021-84 (1/16 DRILL) 2FLS

CONTROLLED
PRINT

ENGINEER B. BLOCK, M.A.H.	DRAFTSMAN BH	7/29/78
SPACE PHYSICS RESEARCH LABORATORY	COMPONENT LAYOUT	
COLLEGE OF ENGINEERING	AGC DETECTOR BD 80011B	
UNIVERSITY OF MICHIGAN	GNMS	5/18/82
ANN ARBOR, MICHIGAN	B-E6664	CONTROLLED
	DATE	




**CONTROLLED
PRINT**

1221

COMPONENT 81005 SIDE

2008 T103910

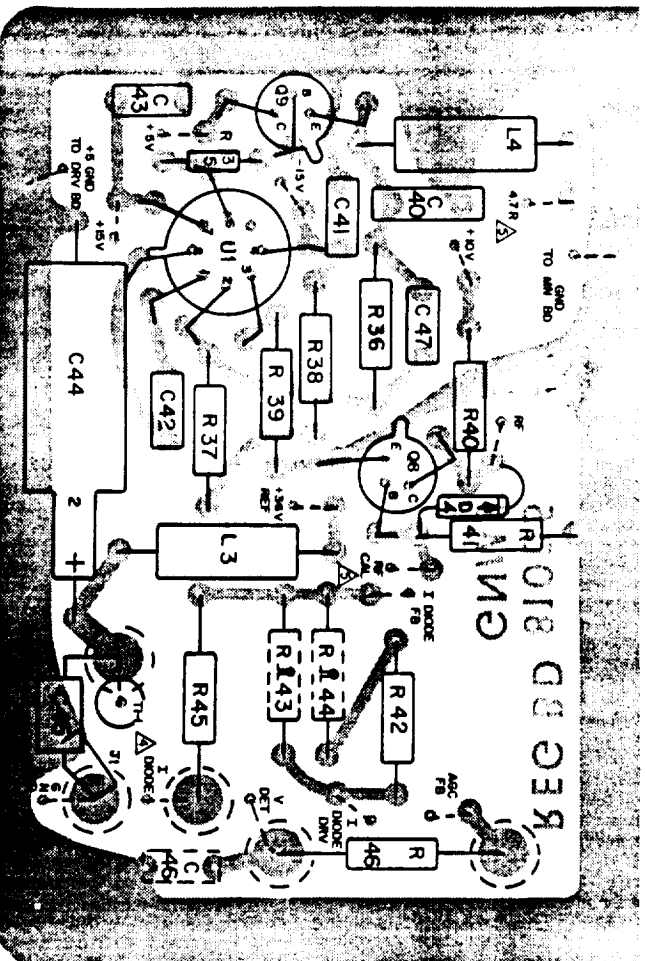

NOTE:

1. INDICATES SWAGE TERMINALS
#2540B-4 5 LOCATIONS.
2. FE2-33 THERMISTOR OPTION.
3. J18C31 OPTIONS.

△ FEED THRU CLEARANCE HOLE +356F TO TANK

△ RF CALS 47R WIRES ROUTE TO DRIVER BD.

ENGINEER B BLOCK M.A.H.

SPACE PHYSICS RESEARCH LABORATORY
COLLEGE OF ENGINEERING
UNIVERSITY OF MICHIGAN
ANN ARBOR, MICHIGAN

DRAFTSMAN TS 7/7/81

COMPONENT LAYOUT
REGULATOR BOARD 81005
GMMS

B-E 6649 CONTROLLED


DATE

PRINT


CONTROLLED

12.22

INDUCTOR L6

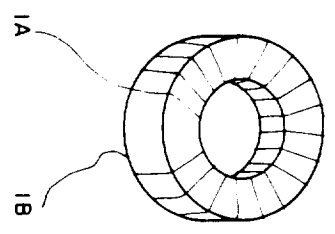


CORE: ARNOLD
FE - 0500 - 0601
TYPE: TOROID,
POWDERED IRON
 $\mu_0 = 8.5$

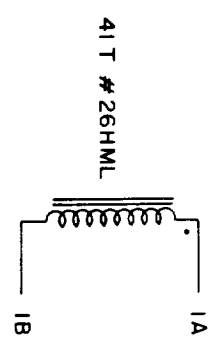


41 T #26HML
 $L_T = 7.8 \mu H$

TRANSFORMER T2

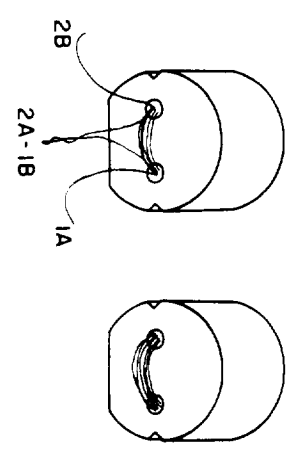


CORE: FAIR - RITE
2843000902
TYPE: 2 - HOLE BALUN,
FERRITE
 $\mu_0 = 950$

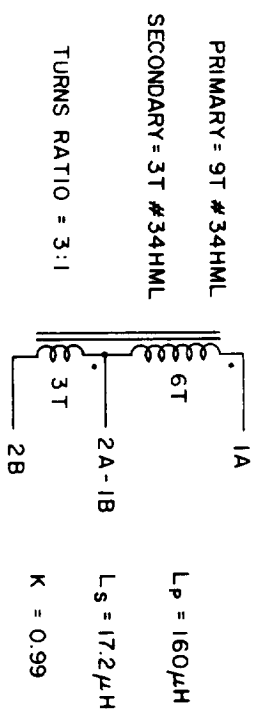

PRIMARY = 9T #34HML
SECONDARY = 3T #34HML
TURNS RATIO = 3:1
 $L_P = 160 \mu H$
 $L_S = 17.2 \mu H$
 $K = 0.99$

ENGINEER B BLOCK	DRAFTSMAN N D	
SPACE PHYSICS RESEARCH LABORATORY	L6, T2 DETAIL	
COLLEGE OF ENGINEERING	RF DRIVER	
UNIVERSITY OF MICHIGAN	GNMS RF OSC.	5/19/82
ANN ARBOR, MICHIGAN	B-E6856 CONTROLLED	DATE

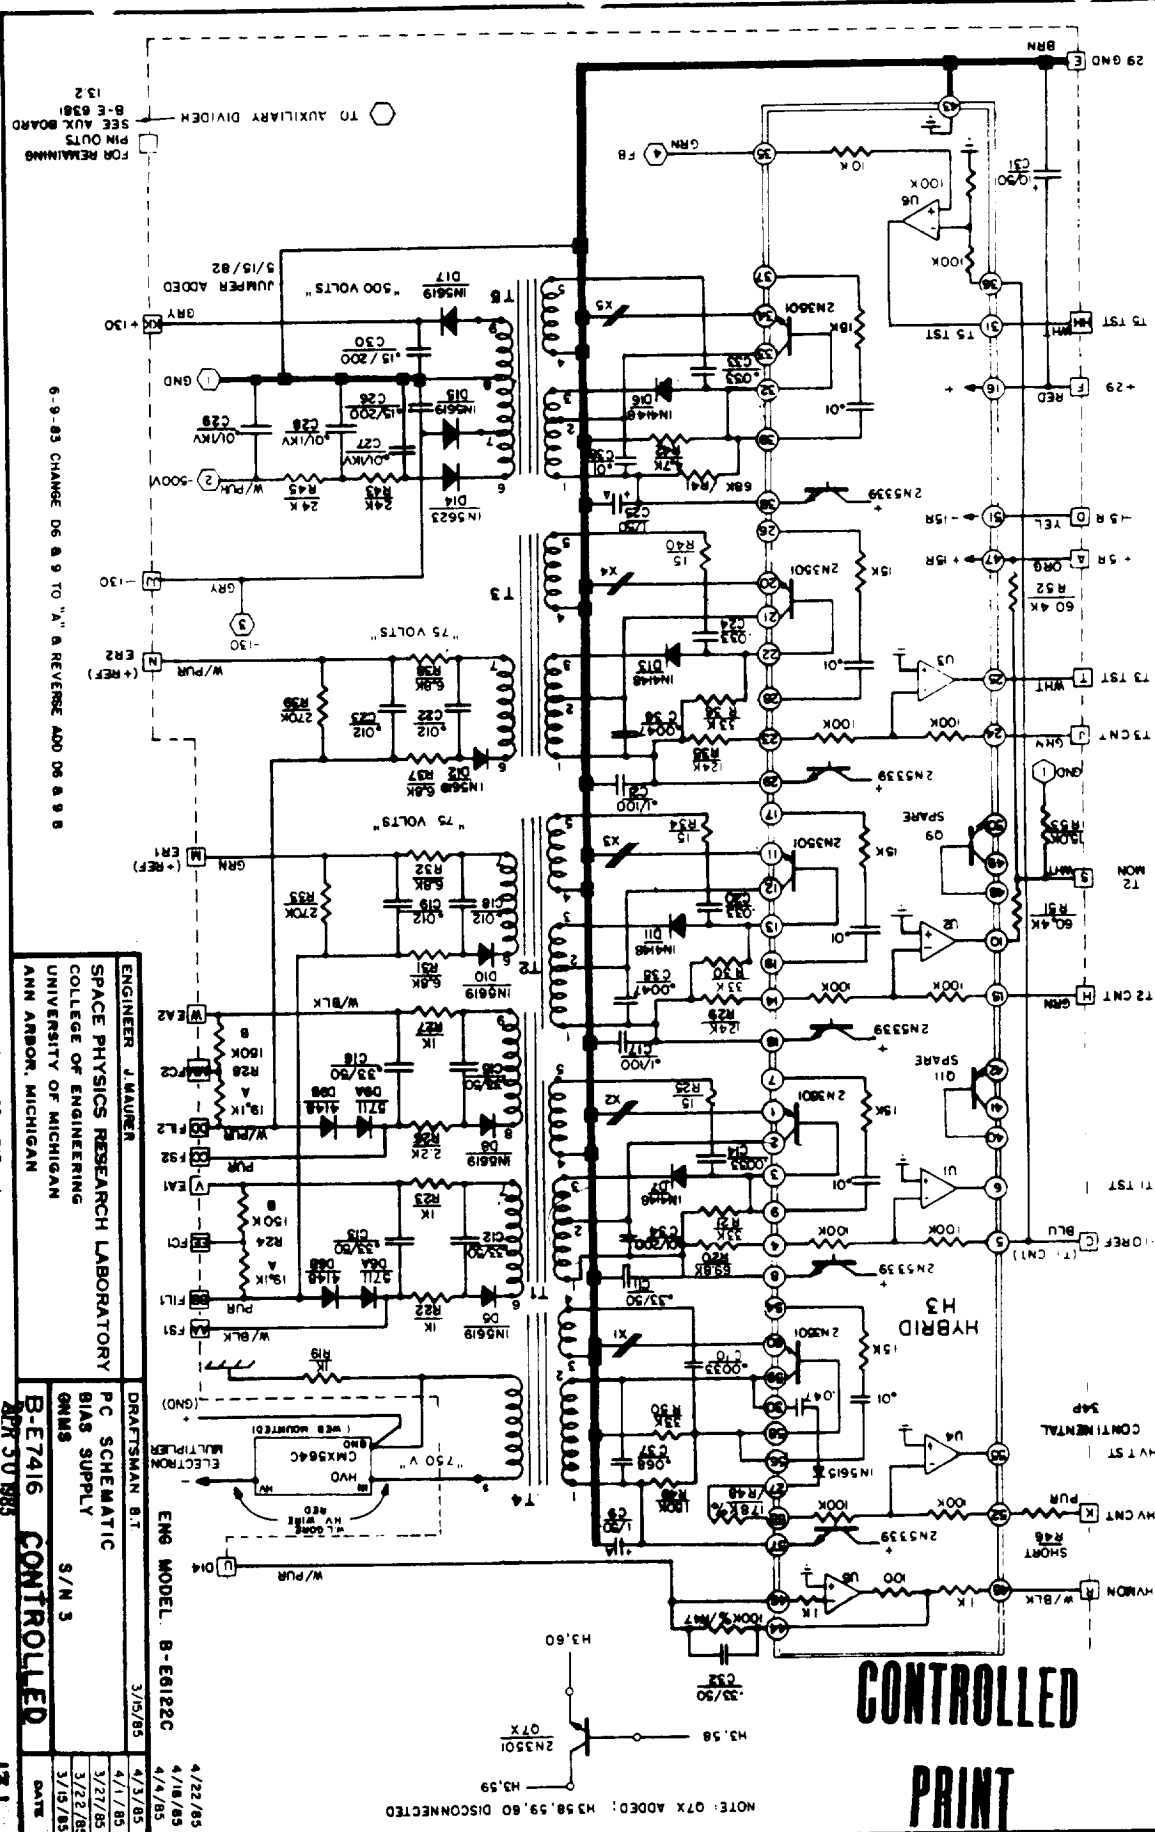

**CONTROLLED
PRINT**

NOTE: 07X ADDED; M358,59,60 DISCONNECTED

NOT USED R 4 4

LAST USED M094 C36 011

13.1

ENGINEER J. WADNER
SPACE PHYSICS RESEARCH LABORATORY
COLLEGE OF ENGINEERING
UNIVERSITY OF MICHIGAN
ANN ARBOR, MICHIGAN

PC SCHEMATIC	
BIAS SUPPLY	
GNMS	S/N 3
B-E7416	CONF

ENG MODEL. B-E61220

4/22/85
























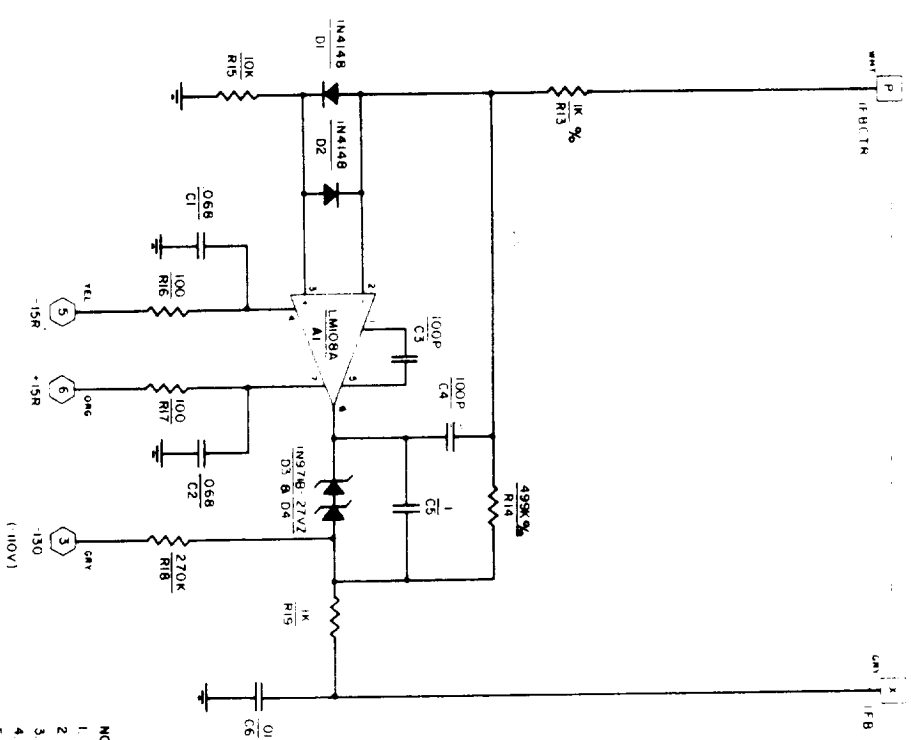


- NOTE:
1. ALL GROUNDS ARE SIGNAL GROUND
 2. "OLD" (1-5) NOT USED.
 3. R51-53 ALSO MOUNT ON AUX. BD
 4. C7 & R54 MOUNT ON MAIN BD
 5. (5) NOT SHOWN ON BIAS SCHEMATIC E6759

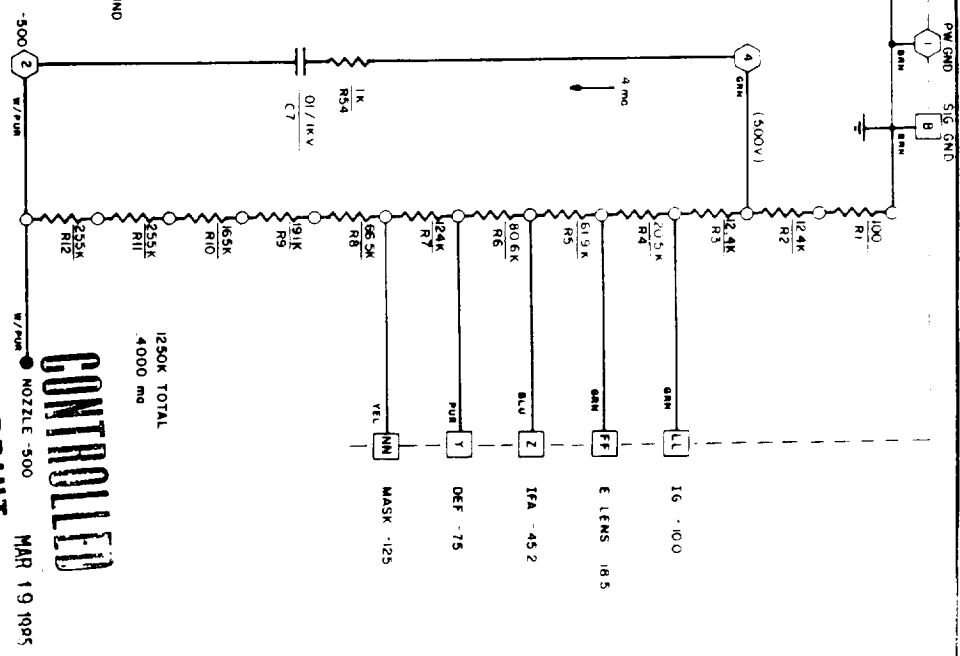

CONTROLLED
PRINT

MAR 19 1995

ENGINEER: J MAURER	DRAFTSMAN: EL	3/15/85
SPACE PHYSICS RESEARCH LABORATORY	AUXILIARY DIVIDER BOARD	
COLLEGE OF ENGINEERING	BIAS SUPPLY	
UNIVERSITY OF MICHIGAN	GNMS	S/N 3
ANN ARBOR, MICHIGAN	B-E7415	CONTROLLED
		DATE

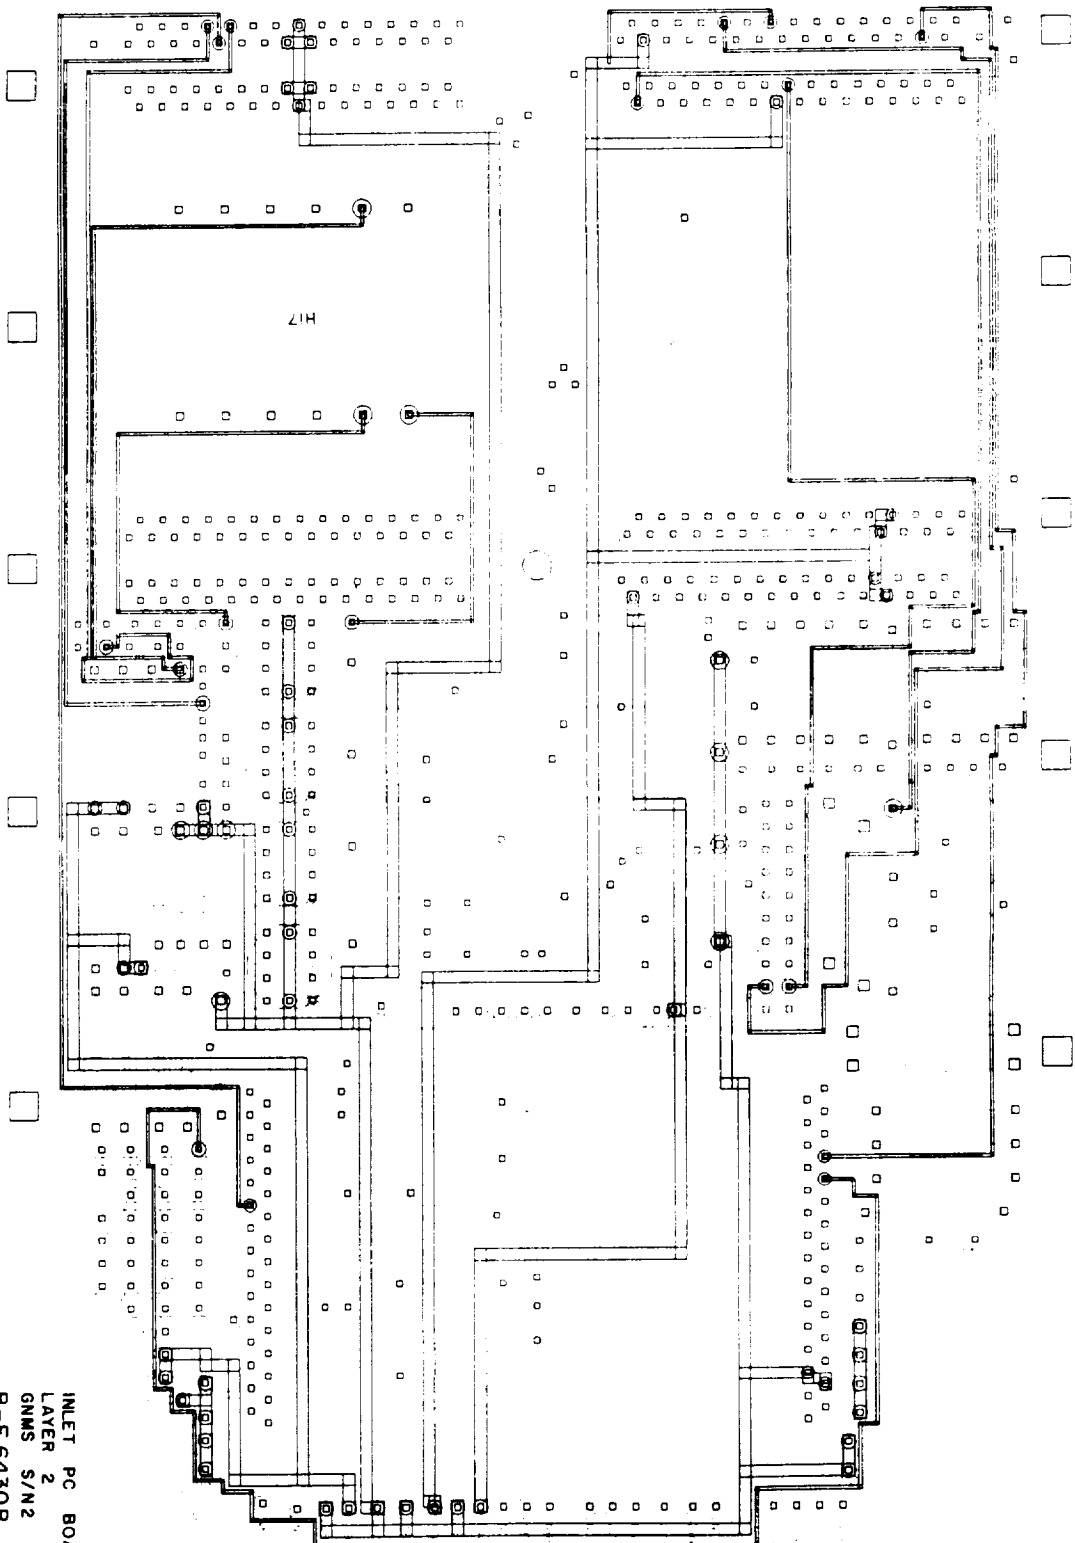

DA

CONTROL
PRINT


D229390PCREVB
IAPWBD,UMICH1
12-10-81

INLET PC BOARD
LAYER 2
GNMS S/N2
B-E6430B

10.22

MAR 24 1983

3/10/83

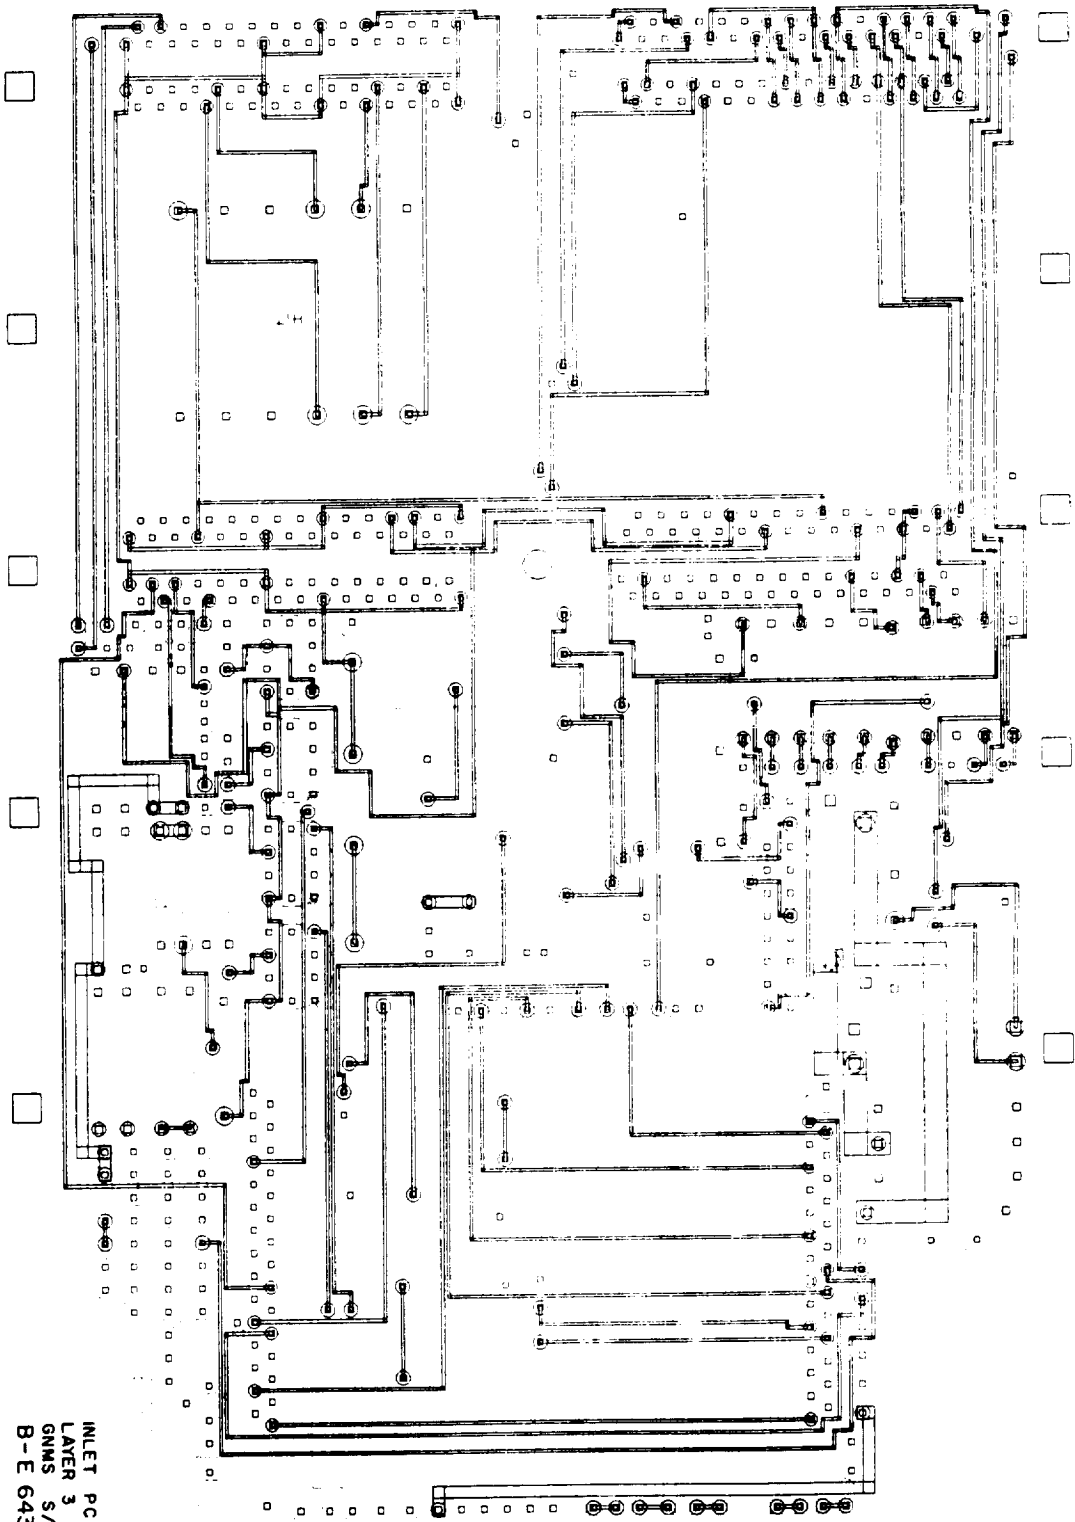

EA 


CONTROLLE
PRINT

D229390PCREVB
(APWBD, UMICH)
12-10-81

INLET PC BOARD
LAYER 3
GNMS S/N2
B-E 643IB
MAR 24 1983

10.23

3/10/83

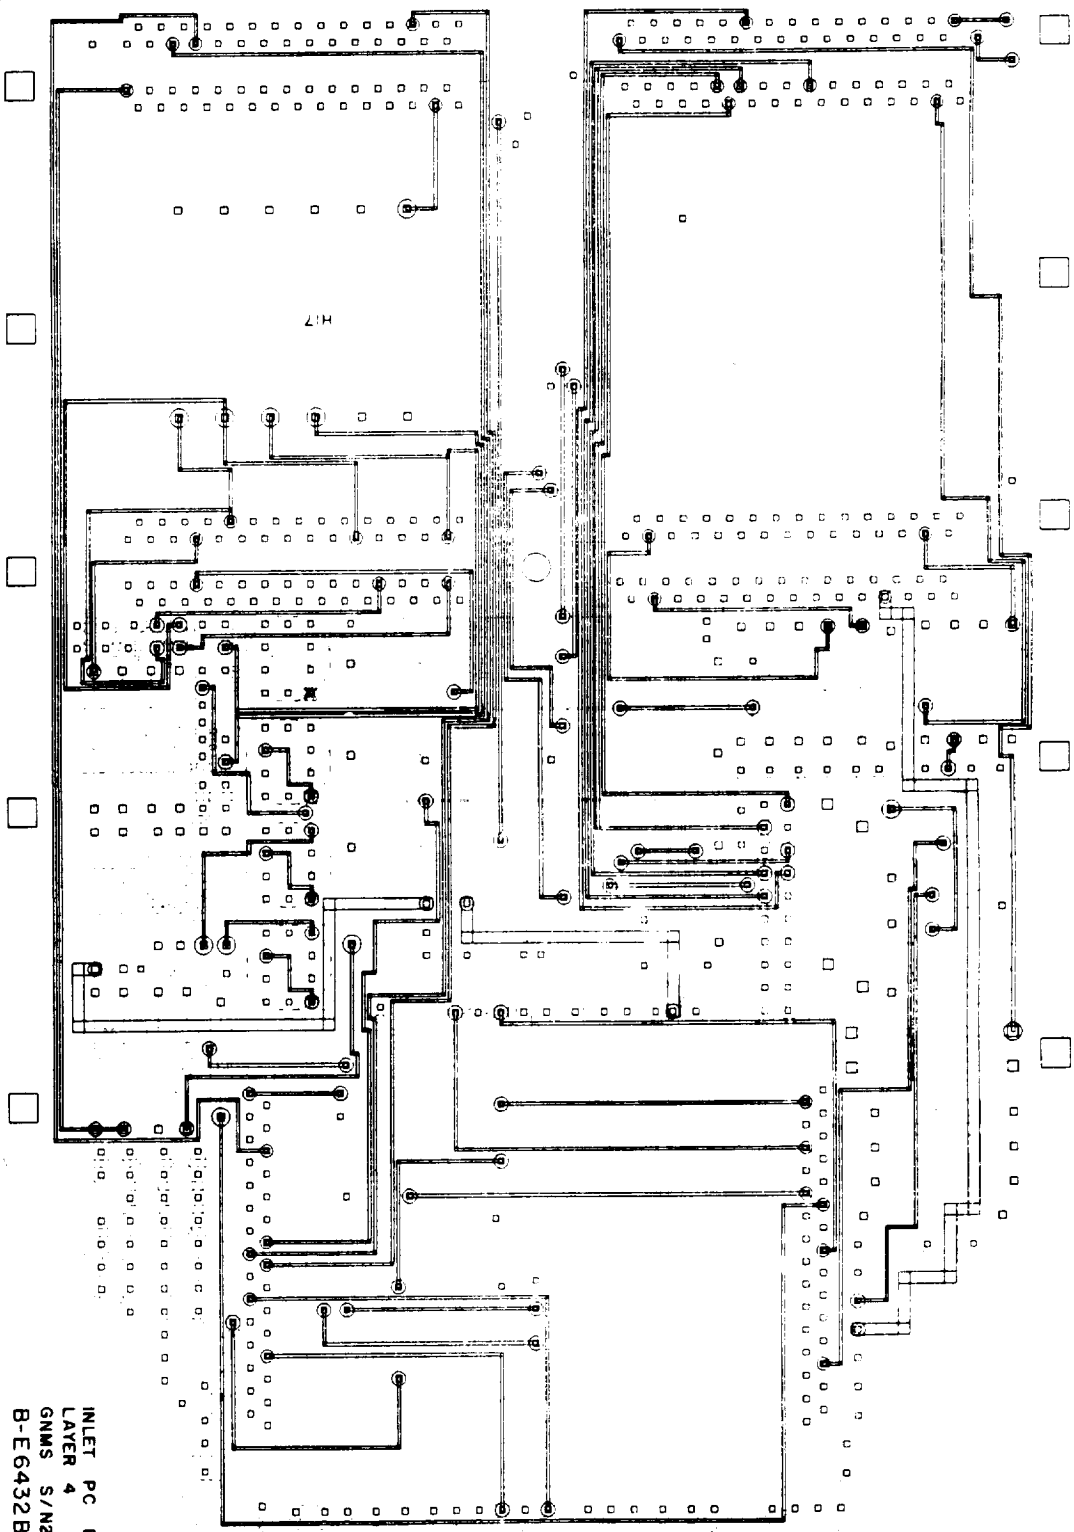


CONTROL
PRINT

FA

D229390PCREVB
(APWBD,UMICH)
12-10-81
INLET PC BOARD
LAYER 4
GNMS S/N2
B-E6432B
1024

MAR 24 1983 3/10/83

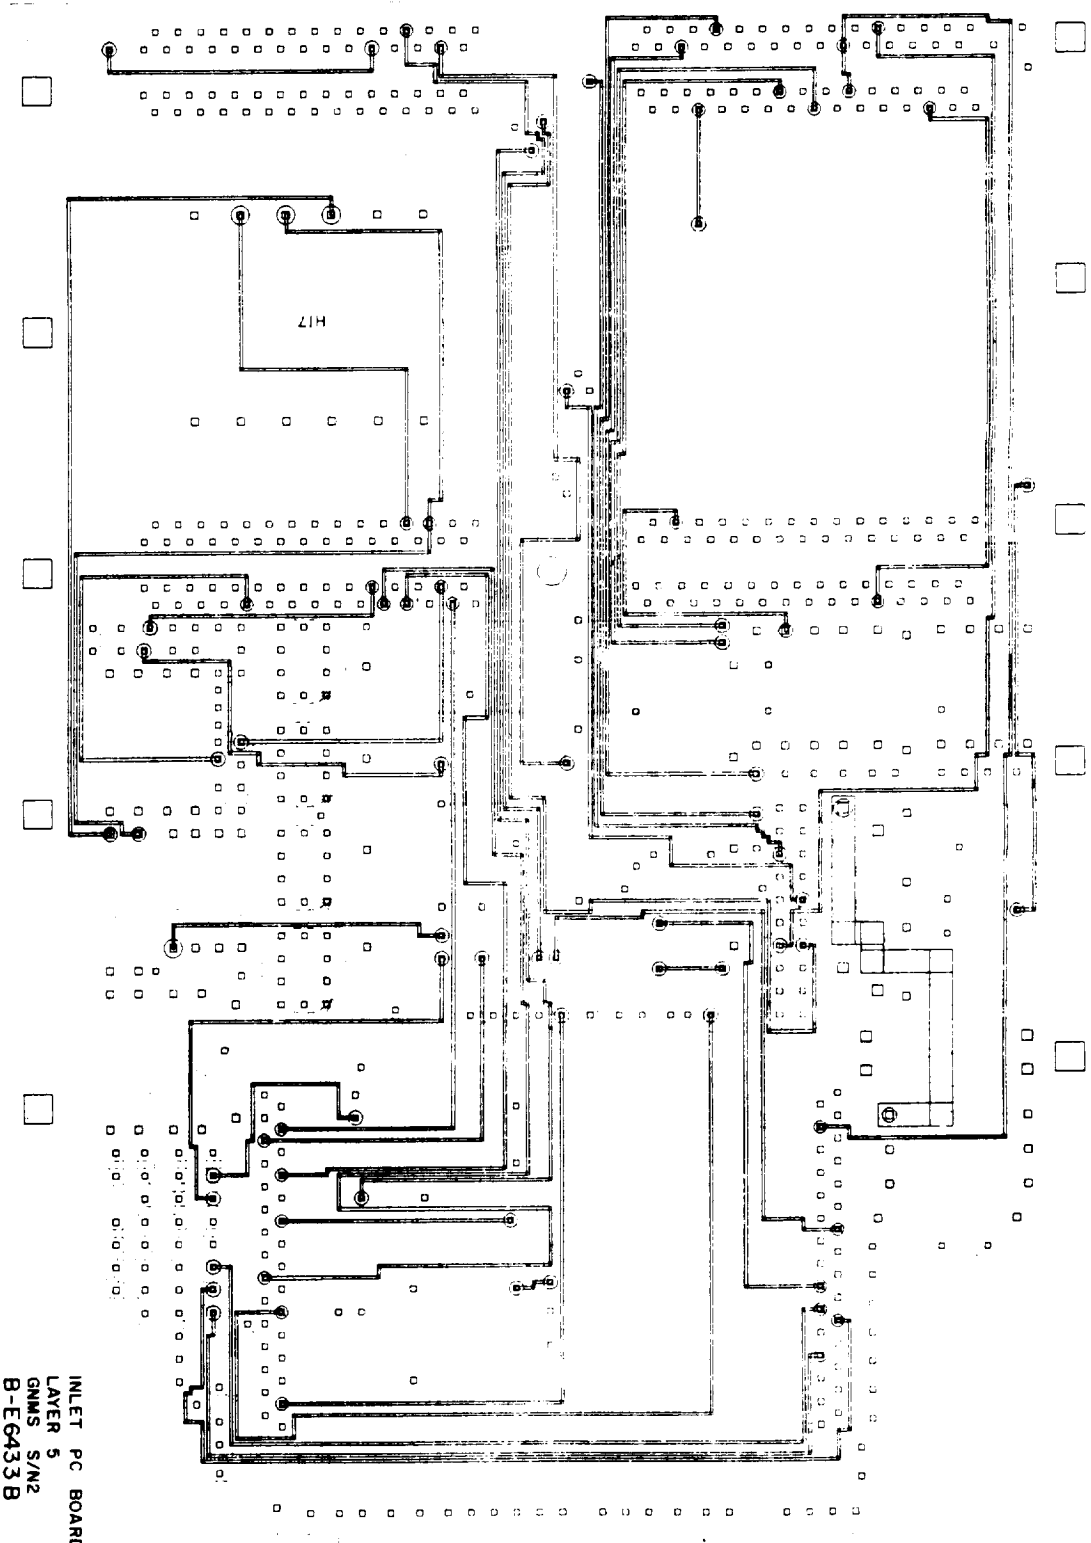

HB 

CONTROL
PRINT


D229390PCREVB
(APWBD, UMICH)
12-10-81

INLET PC BOARD
LAYER 5
GNMS S/N2
B-E6433B

MAR 24 1983

10.25

3/10/83

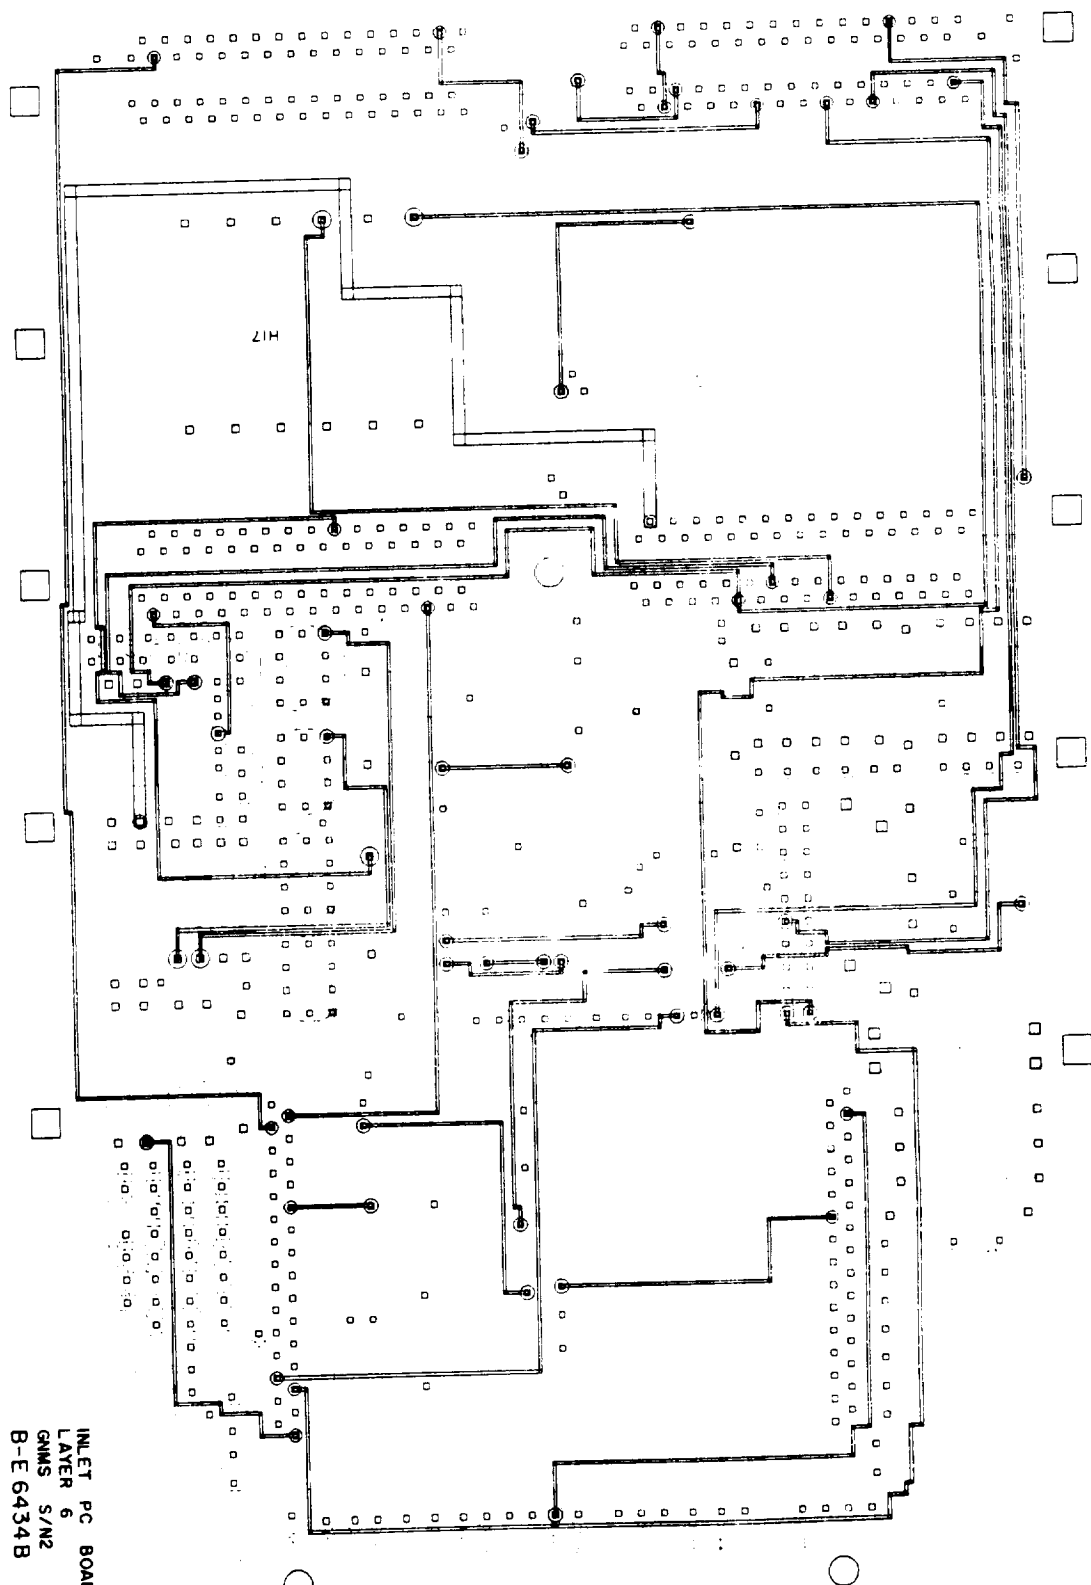

U4

CONTROLLEI
PRINT


D229390PCREVB
IAPVBD, UH1CH1
12-10-81

INLET PC BOARD
LAYER 6
GNMS S/N2
B-E 6434B

10.26

MAR 24 1983

3/10/83

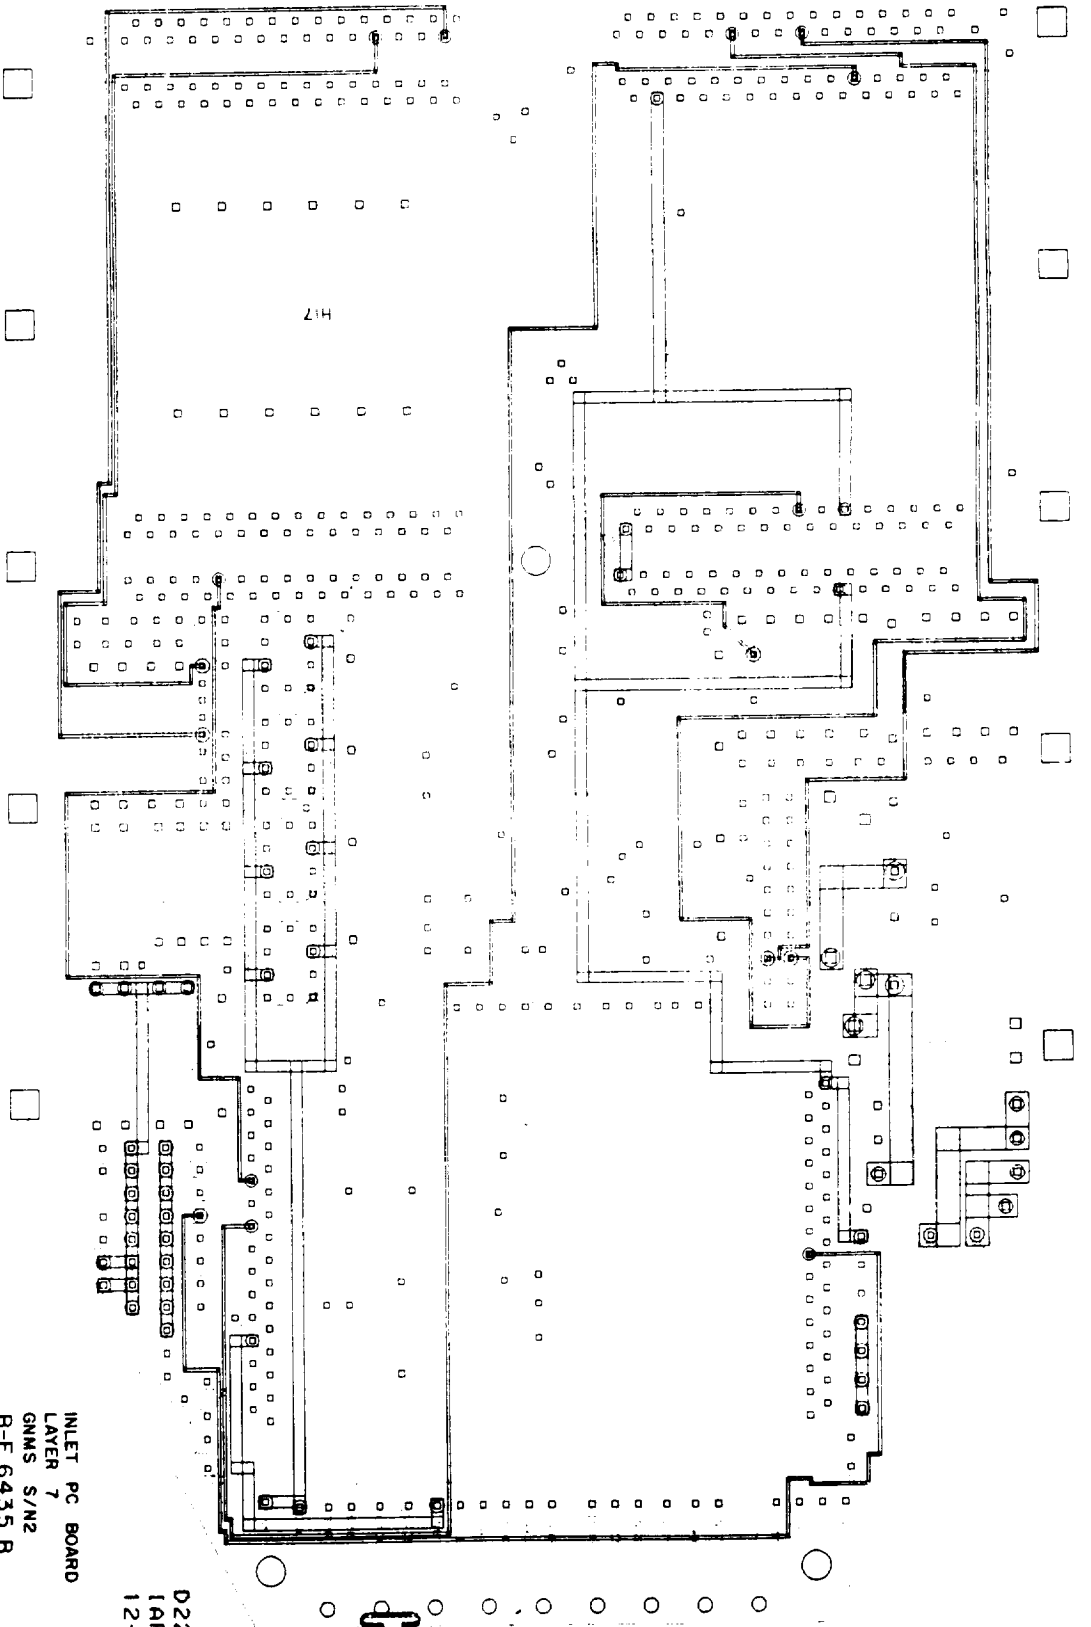

CONTROLLED
PRINT

KC

D229390PCREVB
IAPWBD, UMICH1
12-10-81

INLET PC BOARD
LAYER 7
GNMS S/N2
B-E 6435 B

10.27

MAR 24 1983

3/10/83

TURN THIS VIEW FROM THE COMPONENT TOPSIDE


PRINT

CONFIDENTIAL


INLET PC BOARD
PARTS PLACEMENT a BOTTOM
GMS S/N2
B-E 6436B

1028

D229390PCREVB
(APWBD, UNICH)
12-10-81

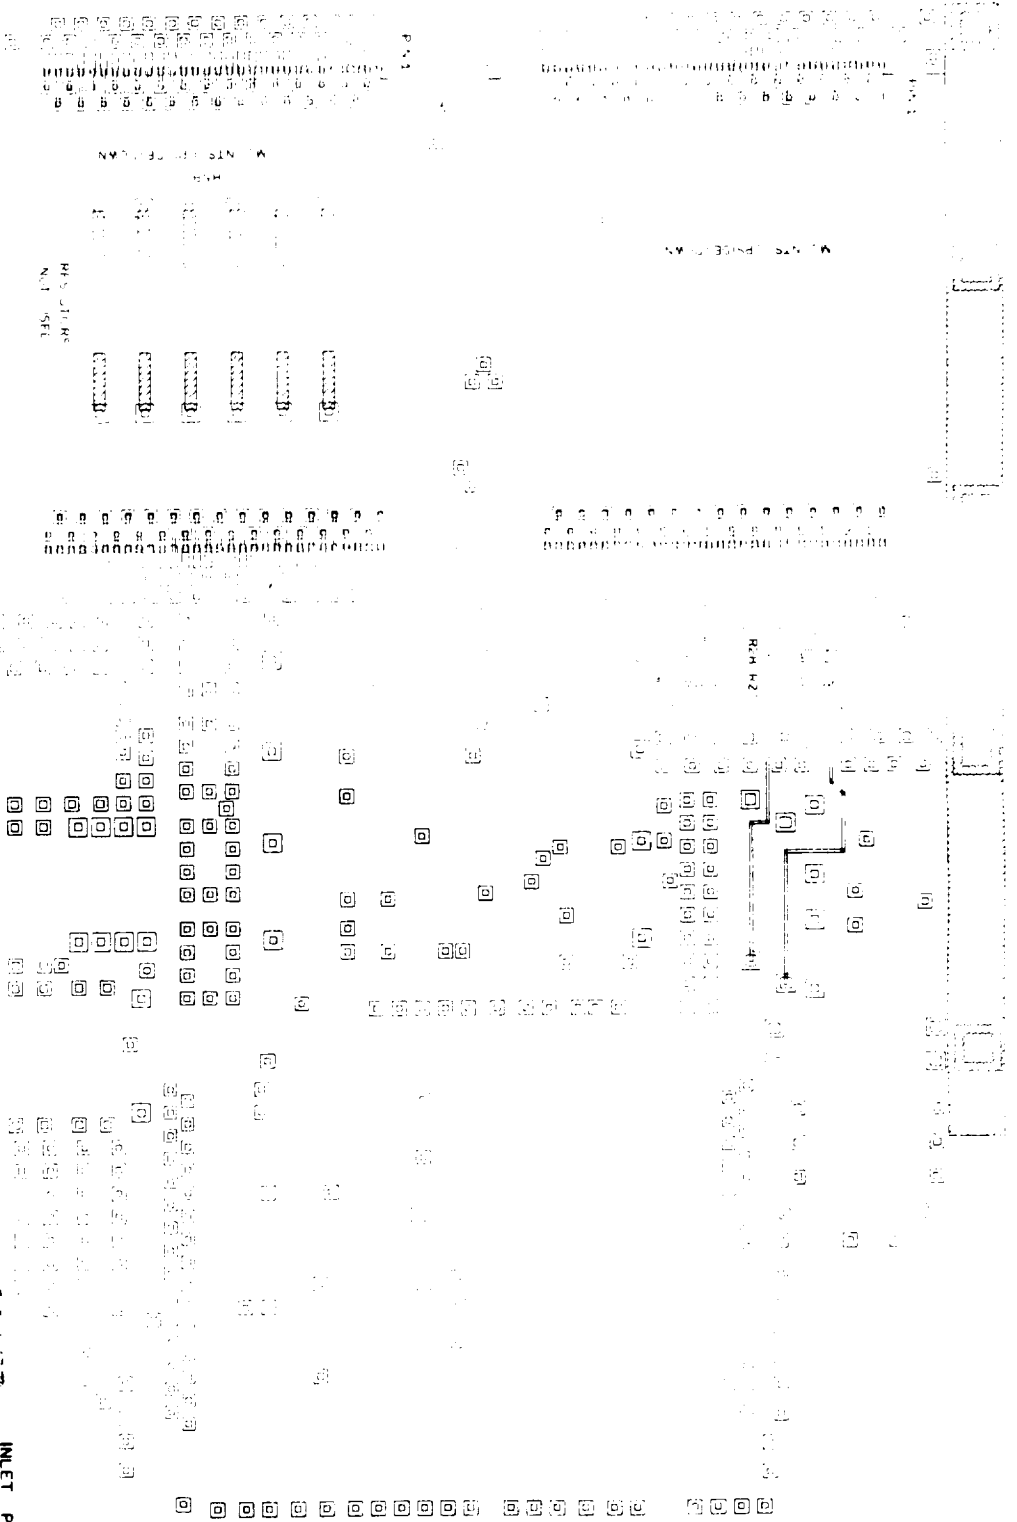

COMPONENT SIDE

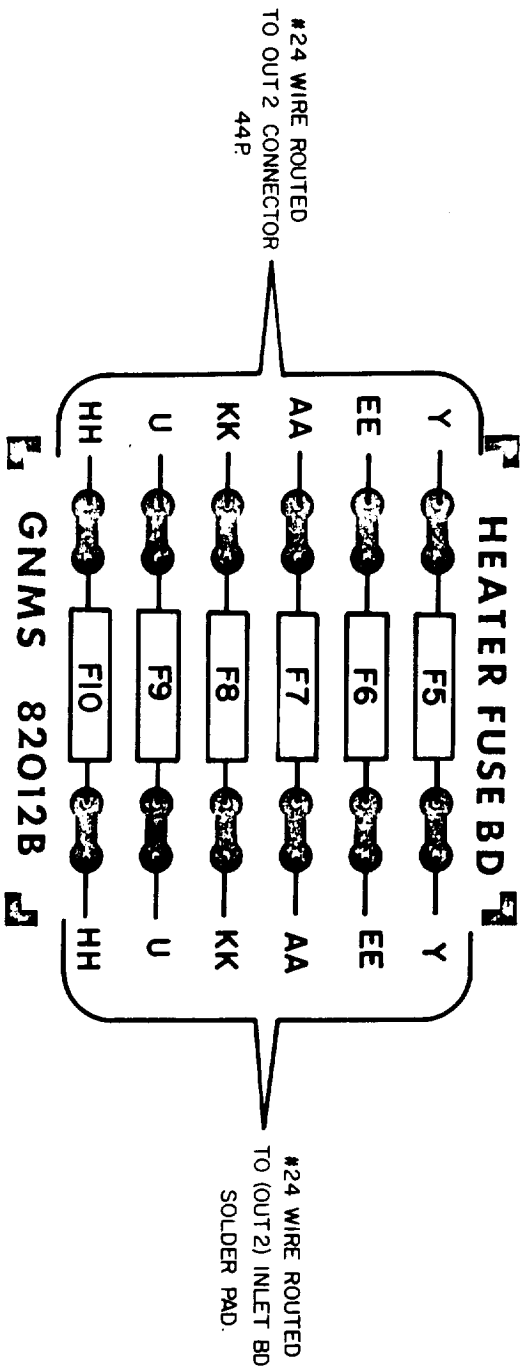

- NOTES:**
1. #82012B PCB .031" MATERIAL
 2. TRIM TO OUTSIDE OF LINES.

CONTROLLED


PRINT

ENGINEER BROCK, MAH.		DRAFTSMAN MK.		10/27/82	
SPACE PHYSICS RESEARCH LABORATORY		COMPONENT LAYOUT #82012B			
COLLEGE OF ENGINEERING		HEATER FUSE BD (INLET BD ADD ON)			
UNIVERSITY OF MICHIGAN		GNMS		S/N 2	
ANN ARBOR, MICHIGAN		B - E6958		3/10/83	
				DATE	

LAST USED R C D L

MAR 24 1983

10,29

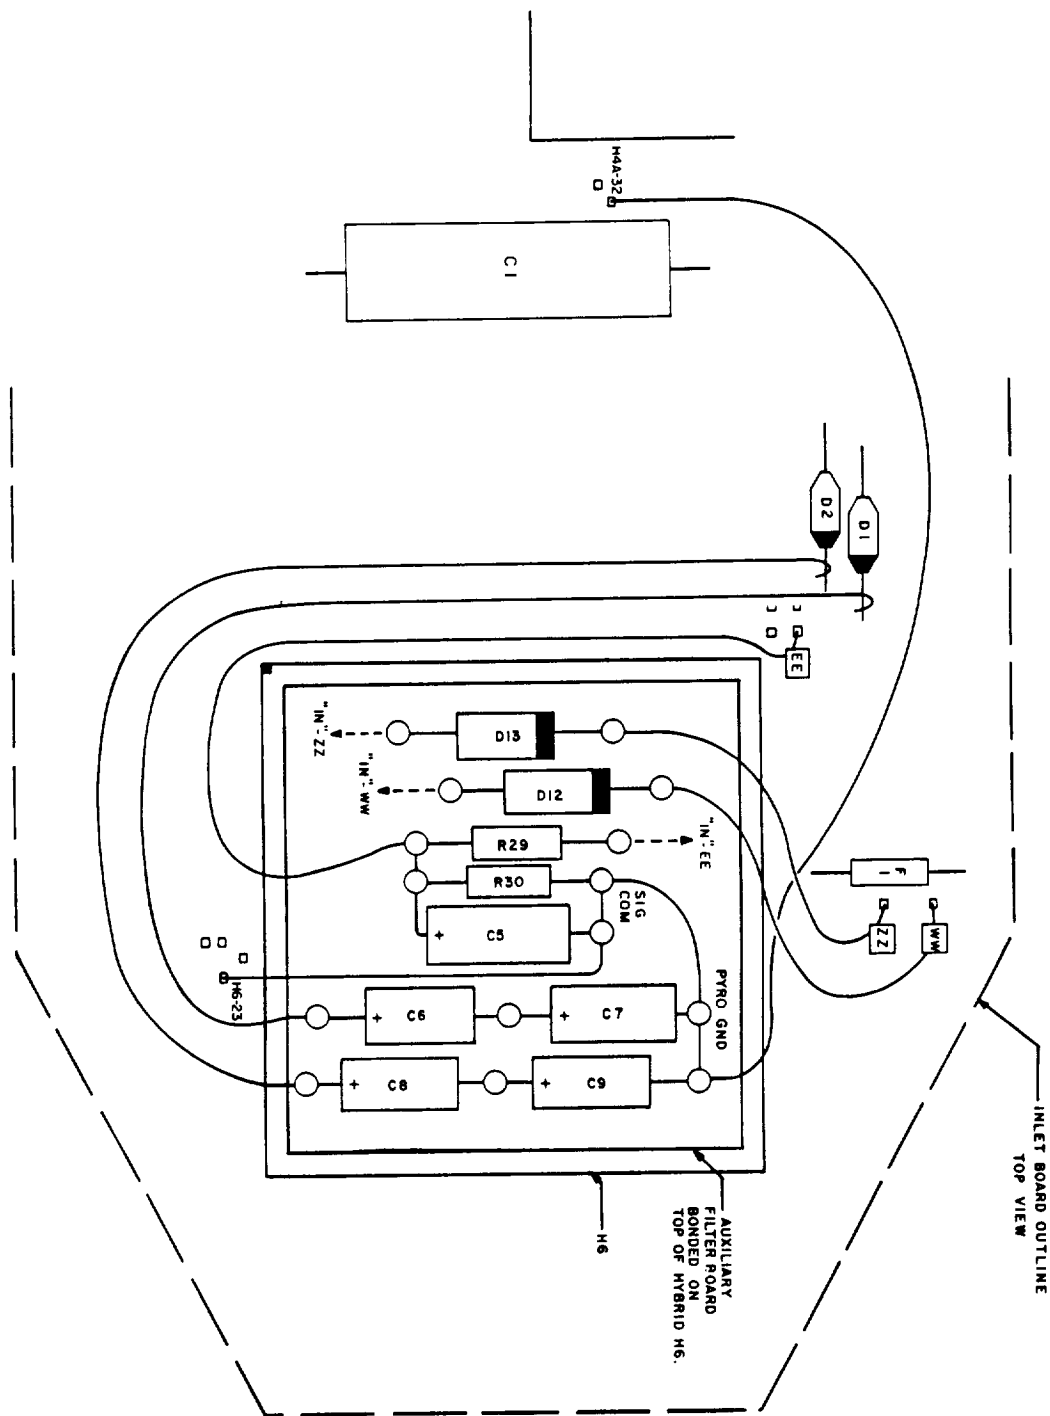

INLET BOARD OUTLINE
TOP VIEW


NOTES:

1. CONNECTOR WIRES EE, WW, ZZ NOW ROUTE TO H6 AUX. BOARD. OTHER WIRES RUN FROM THERE TO PREVIOUS MAIN BOARD LOCATIONS.
2. USE .010 TYLAR OR LAMINATE TO ISOLATE AUX. BOARD FROM H6 CASE. EPOXY DOWN AT FINAL ASSEMBLY.
3. WIRING SHOWN WAS ACCOMPLISHED ON S/N3 BY SPRL. S/N2 AUX WAS WIRED BY CSFC AND MAY DIFFER.

CONTROLLED
JAN 15 1987
PRINT


ENGINEER J CALDWELL	DRAFTSMAN REK.CCZ	2/26/86
SPACE PHYSICS RESEARCH LABORATORY	COMPONENT LAYOUT	
COLLEGE OF ENGINEERING	INLET AUXILIARY FILTER BOARD	
UNIVERSITY OF MICHIGAN	S/N 2	12/4/86
ANN ARBOR, MICHIGAN	B-E7758 CONTROLLED	2/27/86
		DATE

LAST USED R C D L

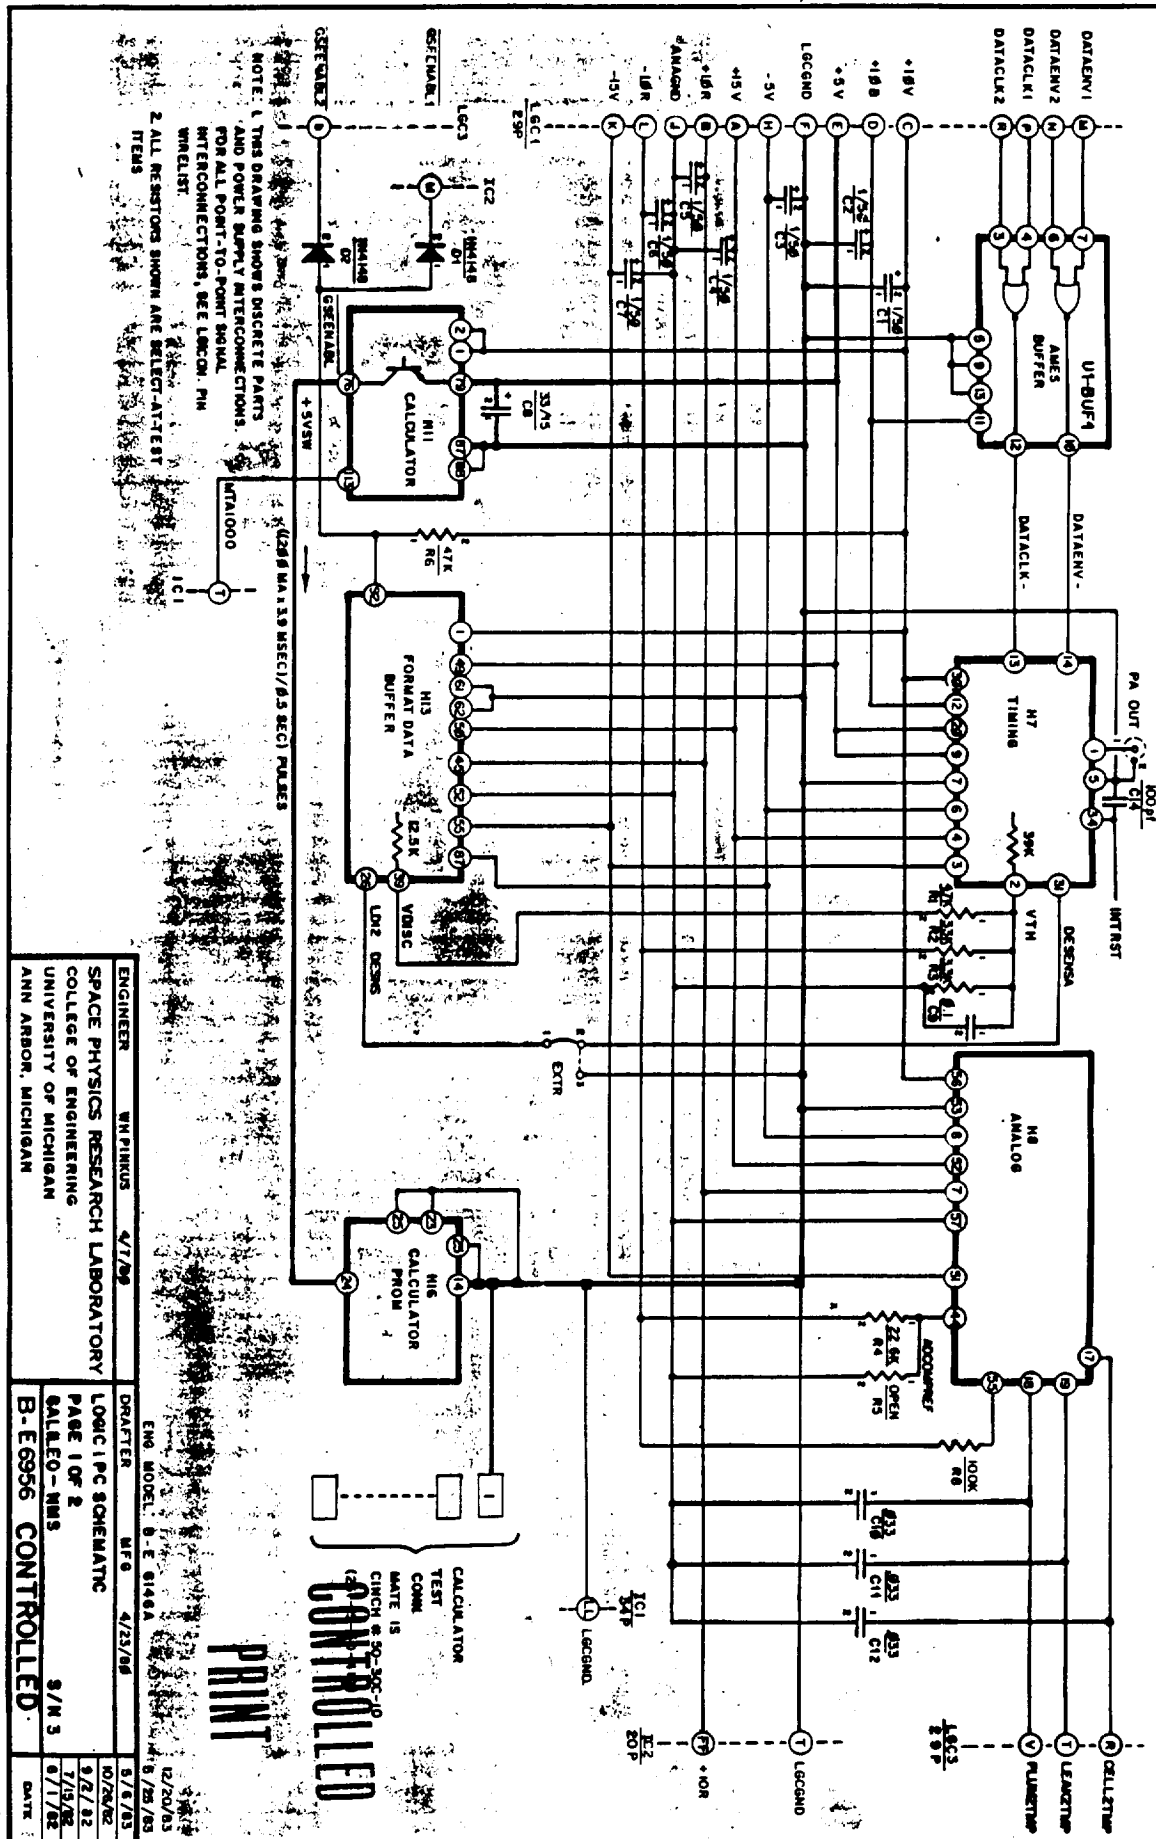

ENGINEER	WINPIKUS	4/7/82	DRAFTER	WFO	4/23/82
SPACE PHYSICS RESEARCH LABORATORY					
COLLEGE OF ENGINEERING					
UNIVERSITY OF MICHIGAN					
ANN ARBOR, MICHIGAN					
B-E6956 CONTROLLED			PAGE 1 OF 2		
S/N 3			DATE		
12/20/83			12/20/83		
8/1/82			8/1/82		

LAST USED R6 CM D2 1

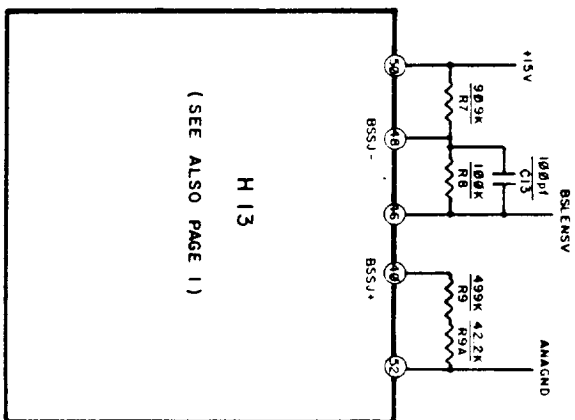

NOTES
1. R7 - 9A CONTROL GAIN OF THE
BSIENS VOLTAGE AMPLIFIER.


CONTROLLED

PRINT

ENGINEER: W H PINKUS	DRAFTSMAN: M D	ENG. MODEL: 8-E6828
SPACE PHYSICS RESEARCH LABORATORY	LOGIC I PC SCHEMATIC	
COLLEGE OF ENGINEERING	Pg 2 OF 2	
UNIVERSITY OF MICHIGAN	GALLED - NMS	S/M3
ANN ARBOR, MICHIGAN	B-E6947 CONTROLLED	DATE

LAST USED R 16 C 13 D L 02

11.1A

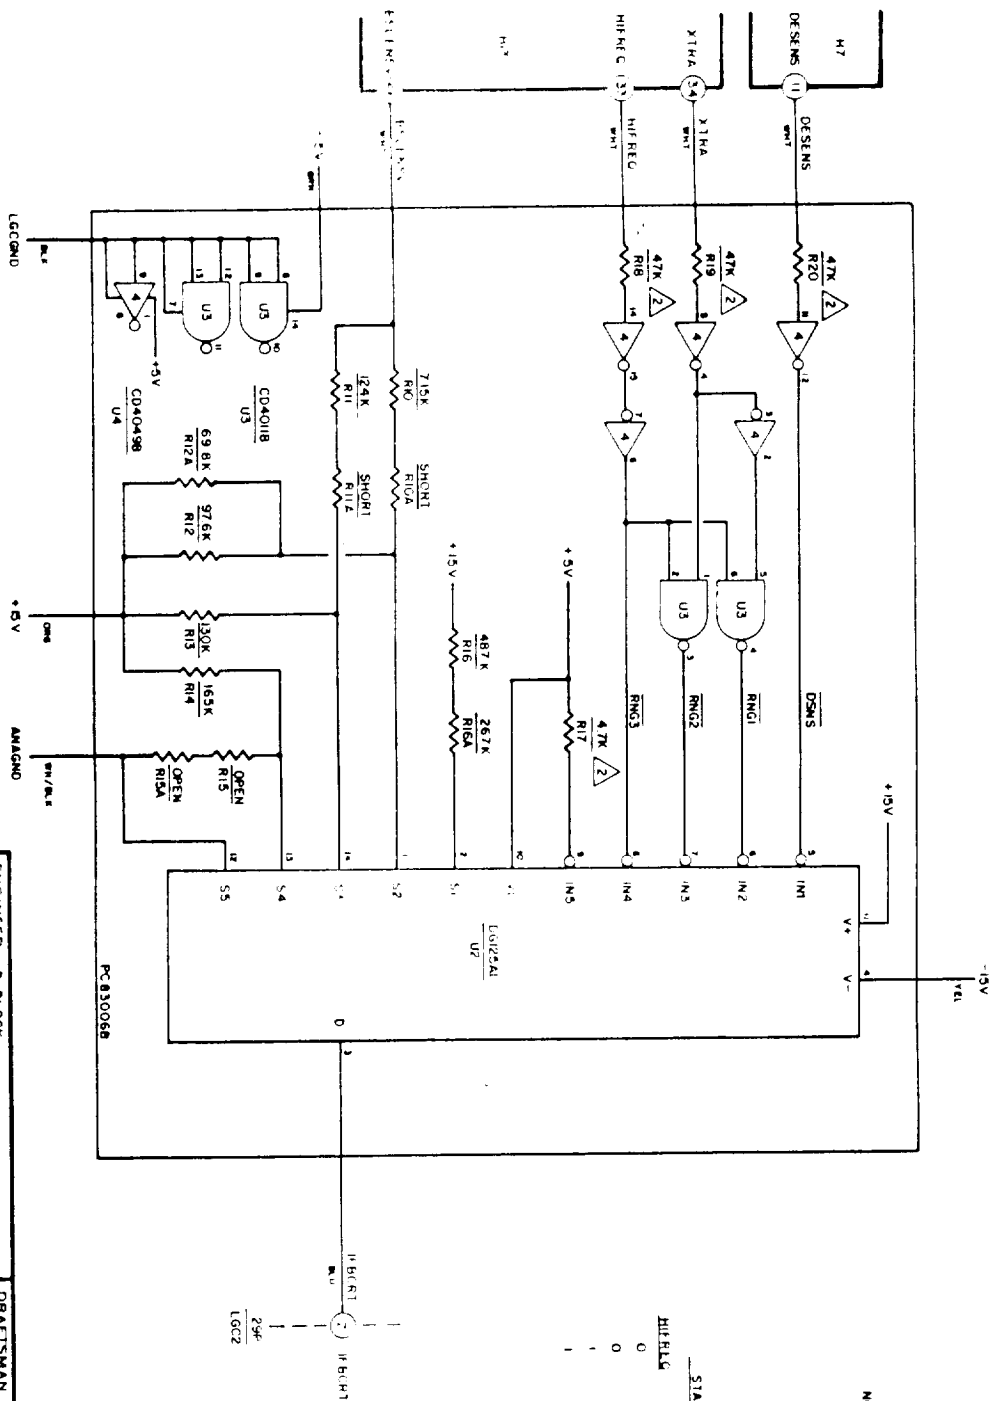

NOTES
 1 UNLESS NOTED, ALL R'S ARE RNCSS
 2 RCROS
 3 ALL RNCSS'S ARE SAT

STATE TABLE


HI/LO	X1/A	STATE
0	0	RANGE 3, M ≥ 21
0	1	NOT ALLOWED
1	0	RANGE 2, 4 ≤ M ≤ 20
1	1	RANGE 1, 0 ≤ M ≤ 3

PRINT

CONTROLLED

ENGINEER B BLOCK	DRAFTSMAN EL	6/21/83	1/24/85
SPACE PHYSICS RESEARCH LABORATORY	AUX BOARD 2	11/3/83	11/11/84
COLLEGE OF ENGINEERING	DELTA IF - LOGIC 1	8/28/83	11/3/83
UNIVERSITY OF MICHIGAN	QALIED NMS	8/28/83	8/28/83
ANN ARBOR, MICHIGAN	B-E7987 CONTROLLED	DATE	

LAST USED R20 C D L

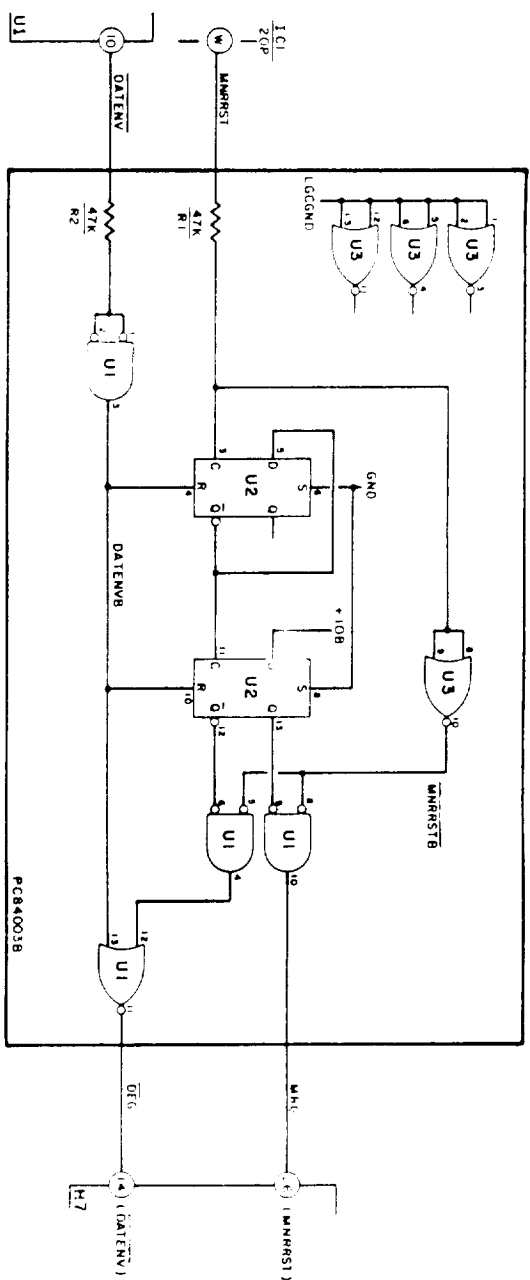


- NOTES:
1. ALL R'S RCND'S
 2. U1, U3 = CD4001B
 3. U2 = CD4013B
 4. VSS = P7, U1, U2, U3 = LOGGND
 5. VDD = P14, U1, U2, U3 = +5V

CONTROLLED
PRINT

ENGINEER B. BLOCK	DRAFTSMAN M. L.	2/15/84
SPACE PHYSICS RESEARCH LABORATORY	AUX BOARD 3	
COLLEGE OF ENGINEERING	LOGIC 1	
UNIVERSITY OF MICHIGAN	GNMS	8/13
ANN ARBOR, MICHIGAN	B-E7986	2/10/84
		DATE

LAST USED R2 C D L




 

LAST INFO C16 CMB 07 430 U1


[illegible]

15.18

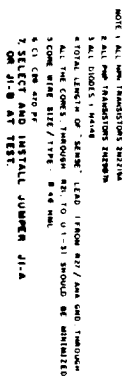


SEP 14 1964

CONTROLLED

 


0-66126A S/M 2

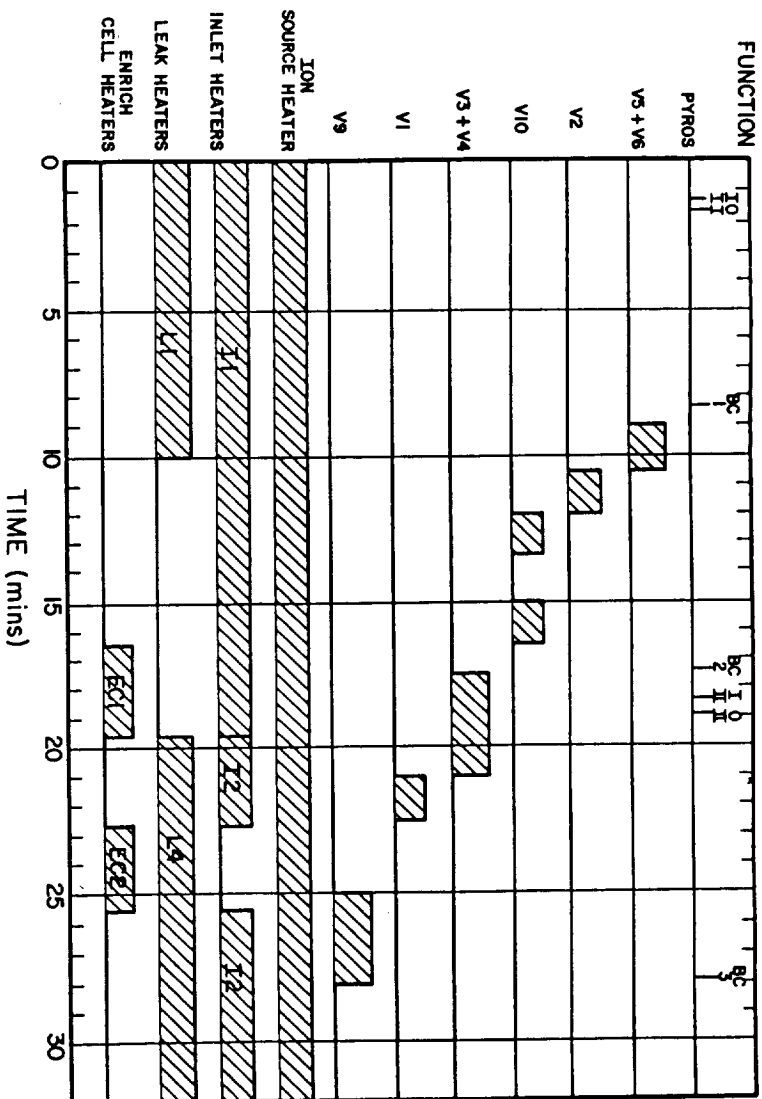

ENGINEER	J. MAHER	DRAFTSMAN	INLET CONTROL TIMING
SPACE PHYSICS RESEARCH LABORATORY		GALILEO-NMS	
COLLEGE OF ENGINEERING		B-E4914A	
UNIVERSITY OF MICHIGAN		DATE	
ANN ARBOR, MICHIGAN			

LAST USED R C D L

OCT 22 1982

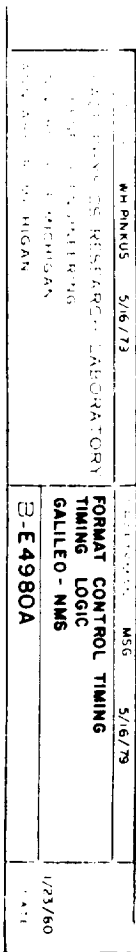

OCT 22 1982

17.2

SUBCOM COUNT

A3 (NAME)

1 2 3 4 5 6 7 8 9 10 11 12 13 14 15 16 17 18 19 20 21 22 23 24 25 26 27 28 29 30 31

SPWEN
TOWEN
COWEN
RWEN

SPWEN
TOWEN
COWEN
RWEN

4	6	7	8	9	10	11	12	13	14	15	16	17	18	19	20	21	22	23	24	25	26	27	28	29	30	31
SUBCOM FORMAT TIMING															MSJ											
TIMING LOGIC															5/16/79											
GALILEO - NMS															1/23/80											
E4982A																										

OCT 22 1982 17.4

2220

• P.V.V.

2004

3623



1	2	
---	---	---	---	---	---	---	---	---	----	----	-----	-----	






[illegible][illegible]





D
C
x
.

17.5'

17.5'


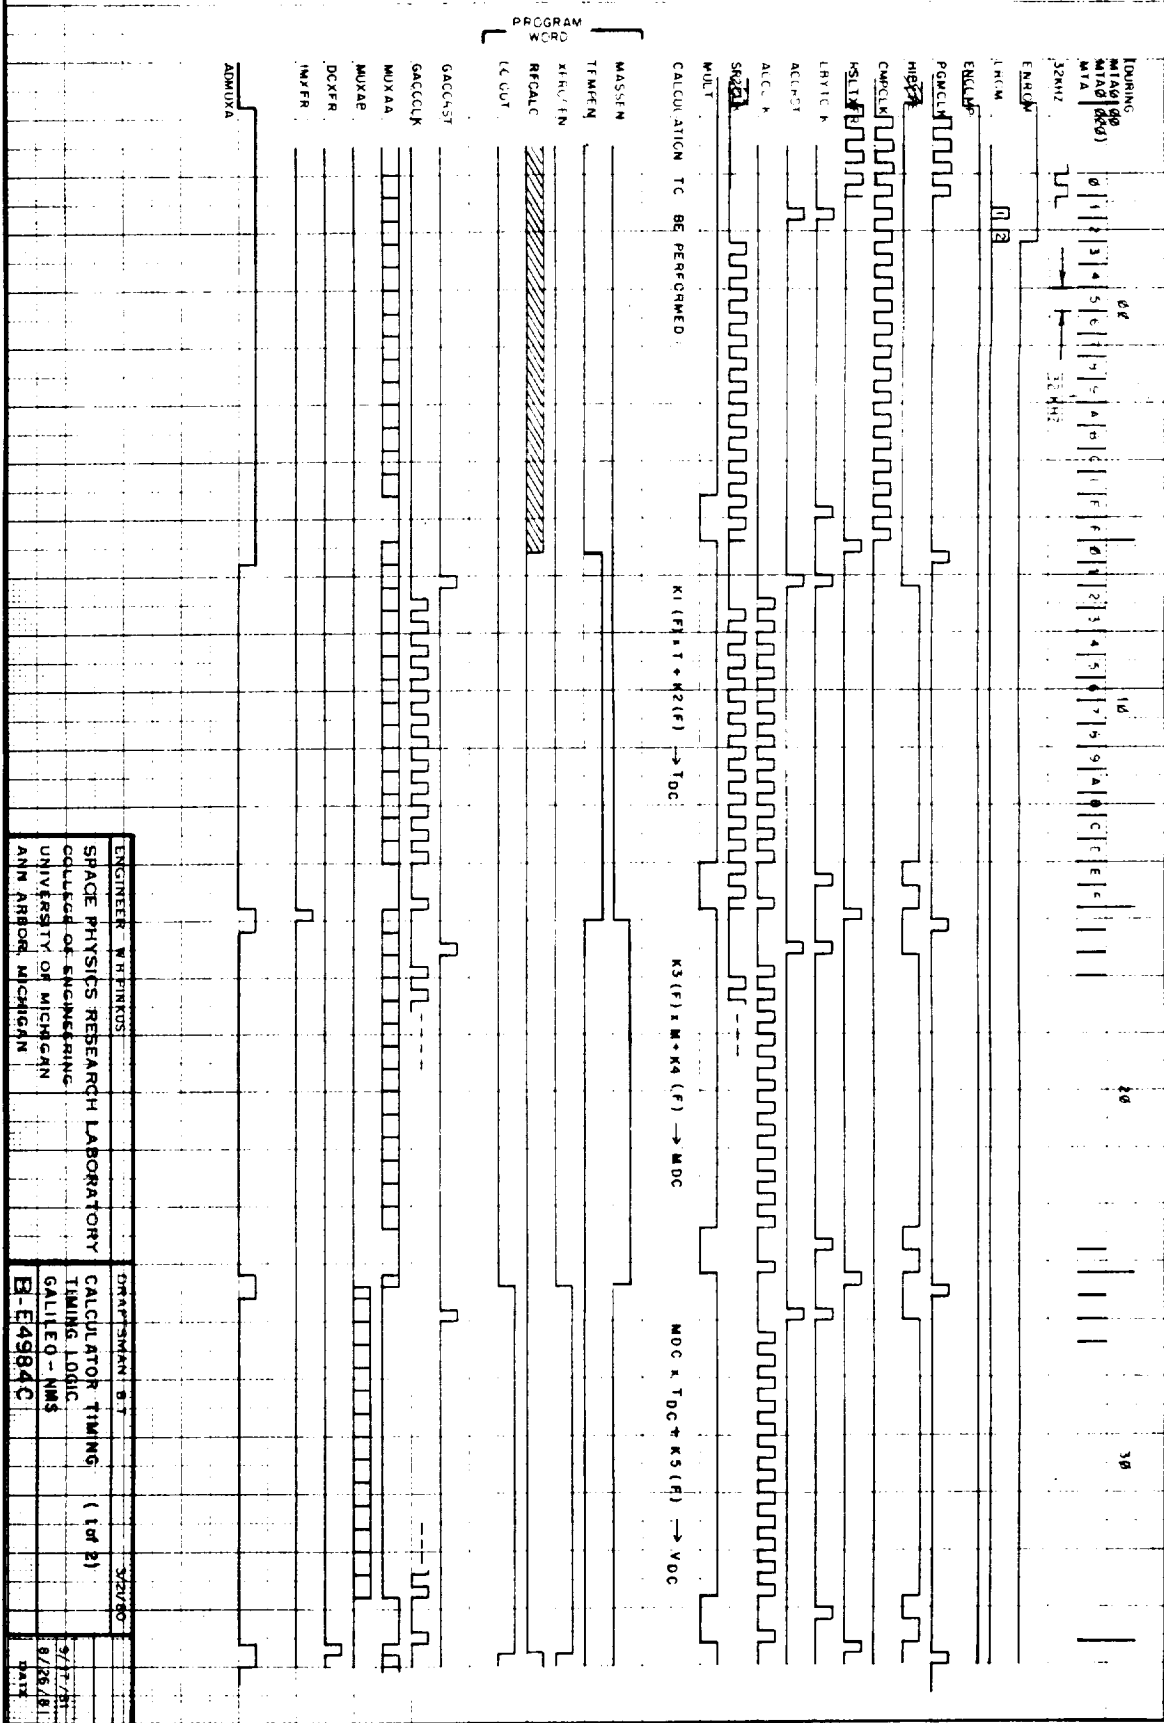


ENGINEER: W. H. HENKOS	DATE: 3/20/80
SPACE PHYSICS RESEARCH LABORATORY	
COLLEGE OF ENGINEERING	
UNIVERSITY OF MICHIGAN	
ANN ARBOR, MICHIGAN	
CALCULATOR TIMING (1st 2)	
E-E4984C	
DATE: 3/7/81	
DATE: 8/26/81	


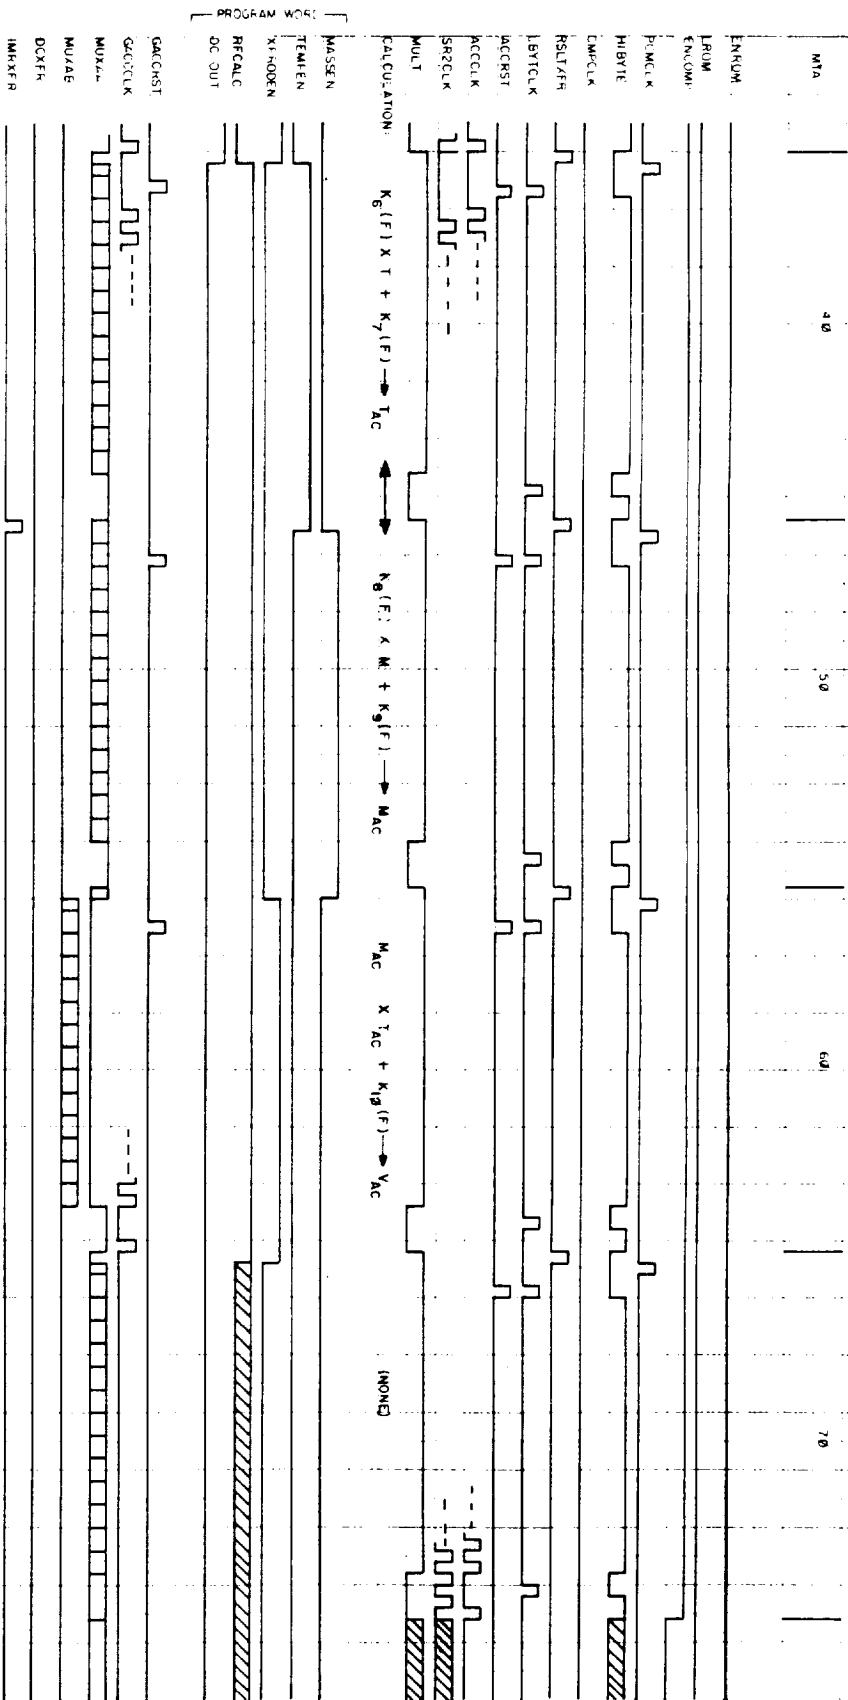


ENGINEER: W. H. P. W. S.	3/21/80	DATE: 12/24/80	MSG: 5/23/80	9/17/81
SPACE PHYSICS RESEARCH LABORATORY				8/26/81
COLLEGE OF ENGINEERING				3/23/80
UNIVERSITY OF MICHIGAN				
ANN ARBOR, MICHIGAN				
B-E4985B				

OCT 22 1982 17.7

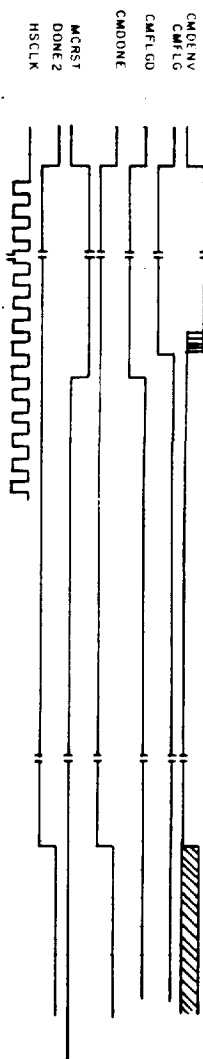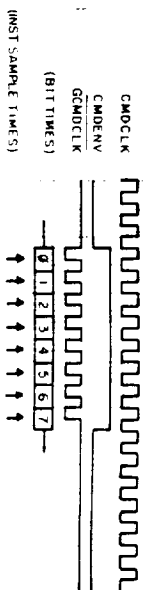

(MCB VALUE) 10 24 127 0 1 2 3 4 5 6 7 8 9

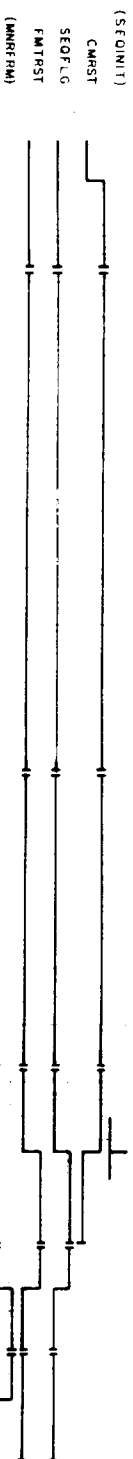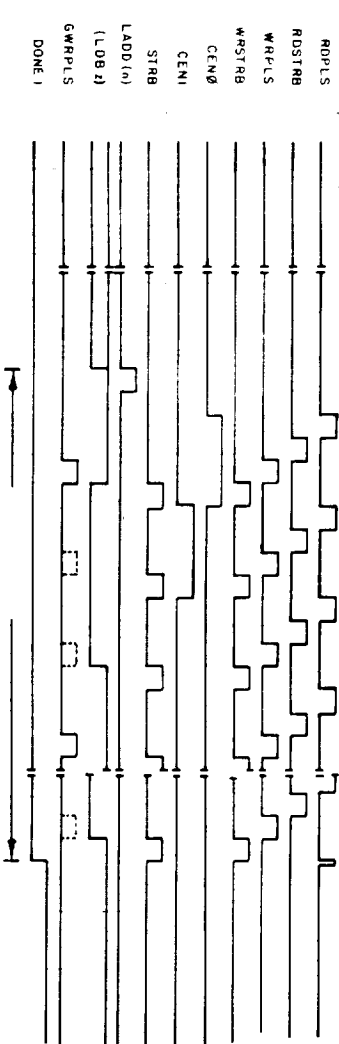


NOTE:
INDICATES STATE UNKNOWN BEFORE TRANSITION
INDICATES DON'T-CARE CONDITION

PREPARED BY FACE PHYSICS RESEARCH LABORATORY COLLEGE OF ENGINEERING UNIVERSITY OF MICHIGAN ANN ARBOR, MICHIGAN	DATE 5/25/79	DRAFTSPERSON COMMAND INPUT TIMING COMMAND LOGIC GALILEO-NMS B-E 5075A	DATE 1/24/80 MFG
---	-----------------	-----------------------------------------------------------------------------------	---------------------

410V SUPPLY


VC
TOR
TOR

NOT TO SAME SCALE

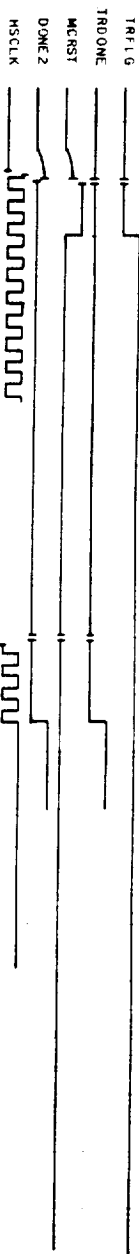

(MCB VALUE) 10


127 0 1 2 3 4 5 6 7 8 9 10

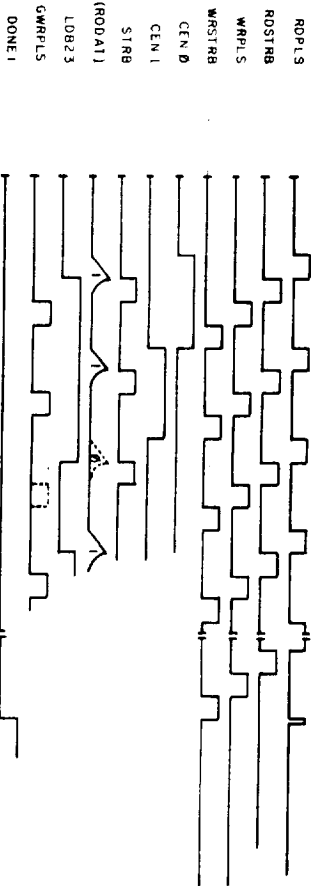


2 SEC 0.1 MSEC

NOTE: COMMAND INPUTS IGNORED BEFORE THIS TIME.

(SEQUINT)
TRST
SEQFLG
FMTRST
(MNRFRM)
MNRST

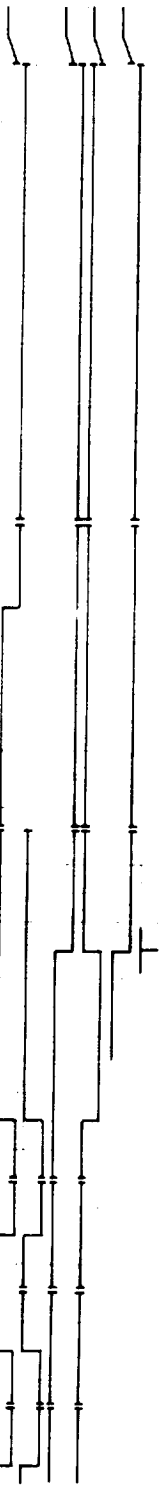


---	--------------------------------------------------------------------------------------------------

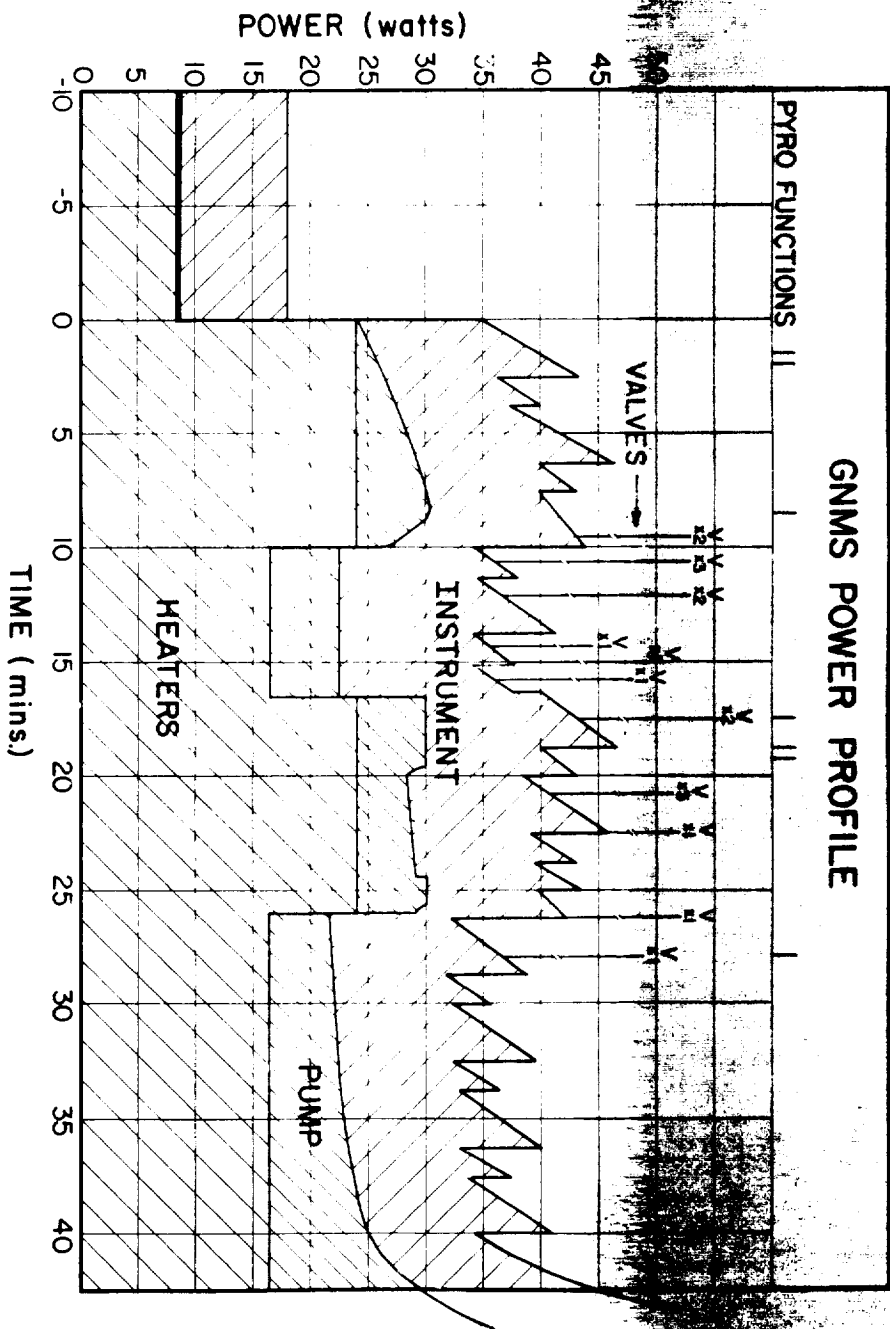




ENGINEER J. CARLIN	DRAFTSMAN C. DAVIS	2-16-79
SPACE PHYSICS RESEARCH LABORATORY	POWER PROFILE	
COLLEGE OF ENGINEERING	GNMS	
UNIVERSITY OF MICHIGAN		
ANN ARBOR MICHIGAN	B-E5094	
		DATE

OCT 22 1982 17.10

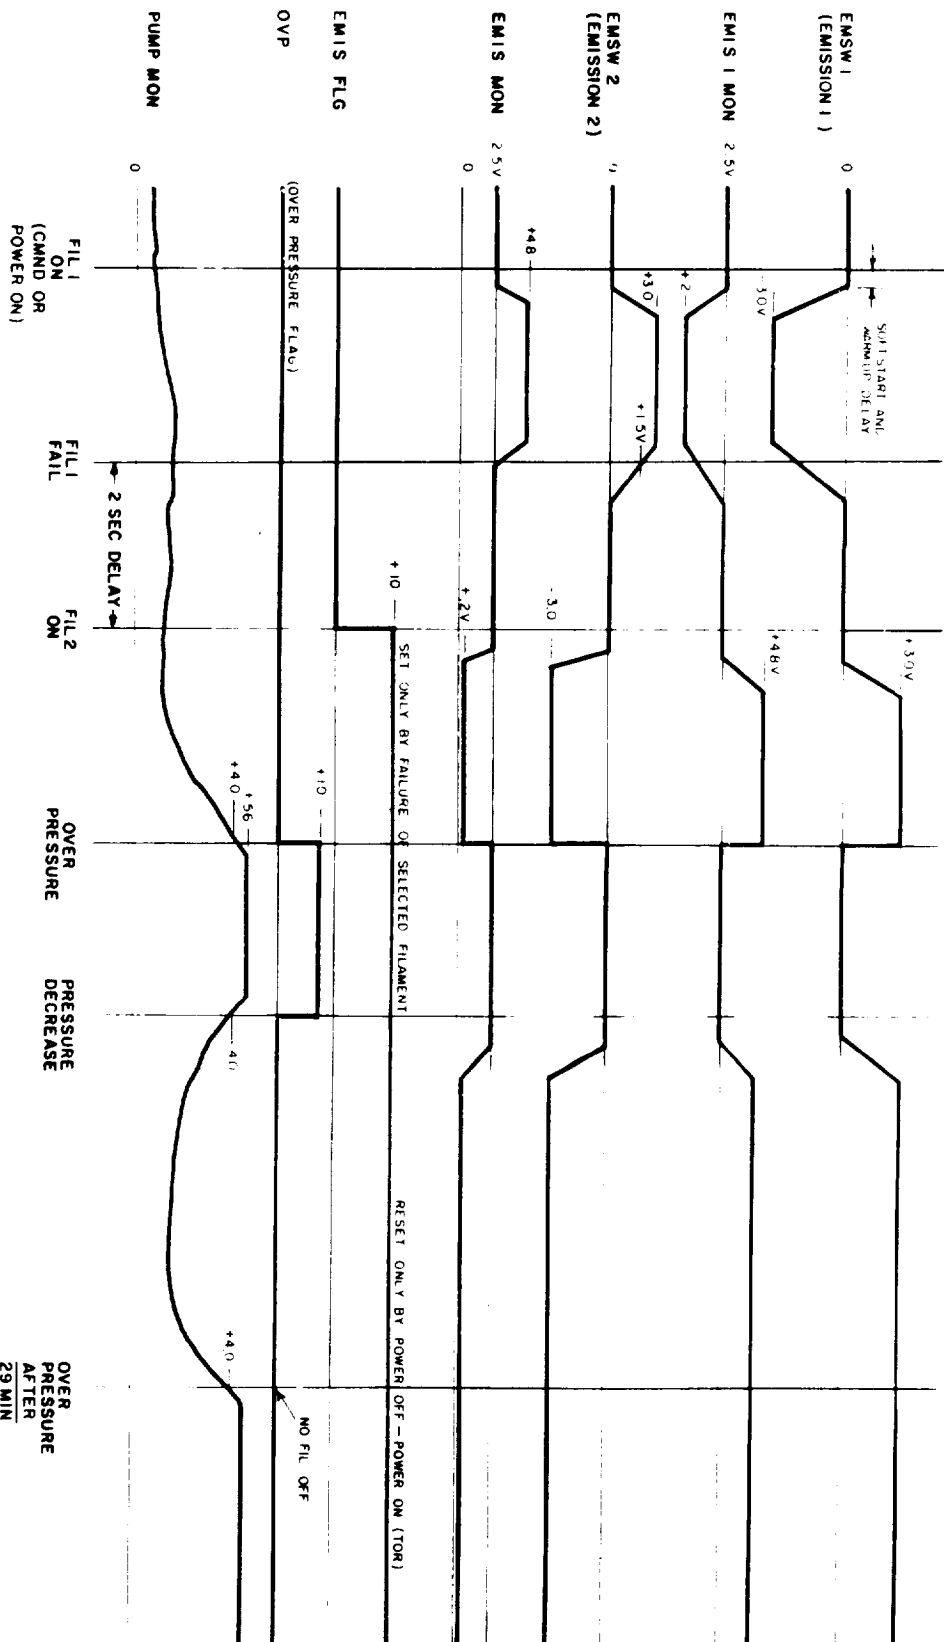


ENGINEER J MAURER	DRAFTSMAN TS 4.6.79	
SPACE PHYSICS RESEARCH LABORATORY	FILAMENT CONTROL TIMING	H2
COLLEGE OF ENGINEERING	GNMS	1/30/81
UNIVERSITY OF MICHIGAN		4-10-79
ANN ARBOR MICHIGAN	B-E 5201	DATE

OCT 22 1982
17.11

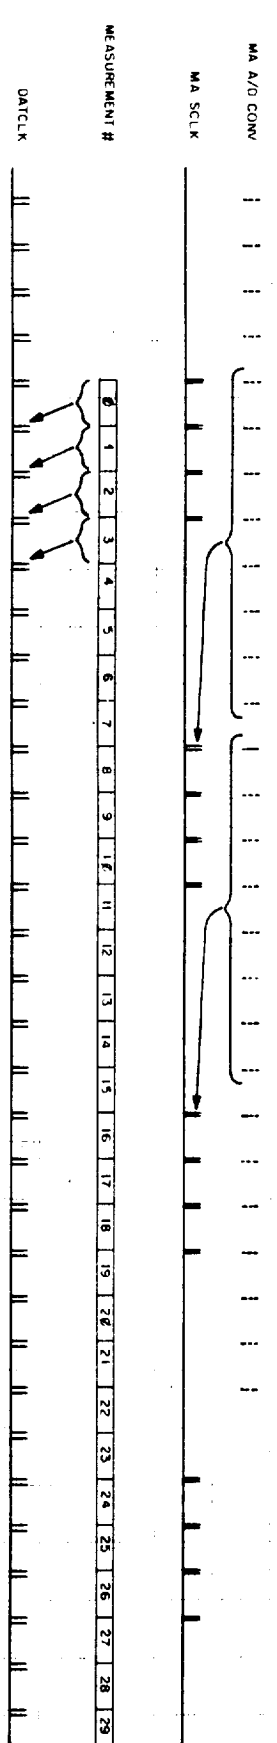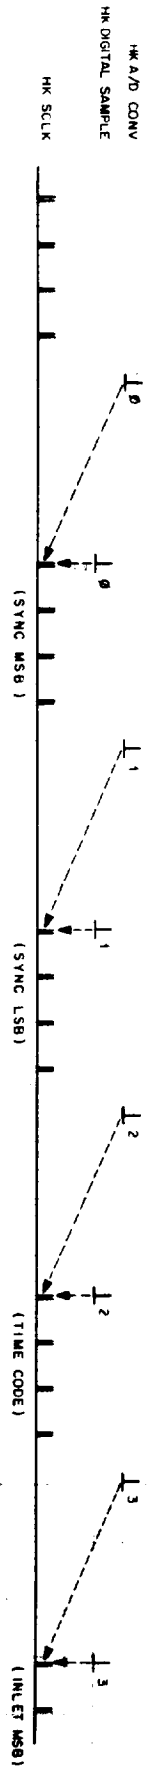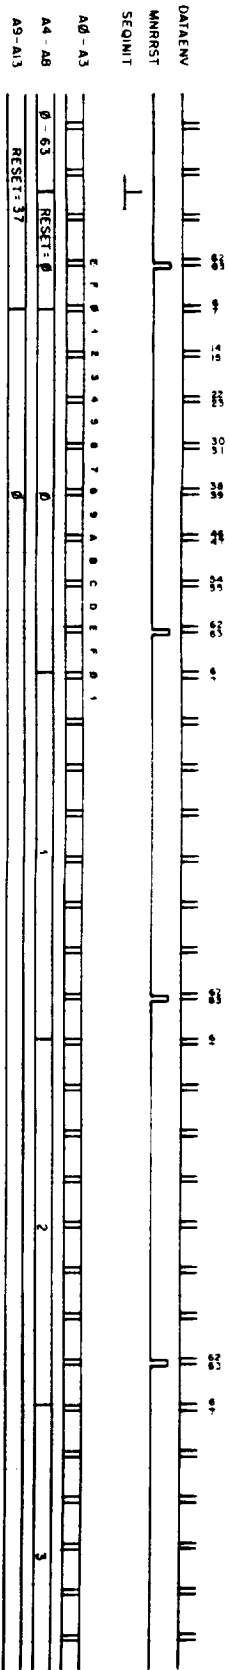



W. H. PINKUS	10/27/80
TELEMETRY DATA FORMAT ASSEMBLY	
TIMING RELATIONSHIPS	
GALILEO - NMS	
B-E6319	

TM MINOR FRAME SYNC
 NMS "POWER-ON"
 NMS "SER INIT"
 NMS "COMMAND LOAD"
 SEQ INIT FLAG ENABLE
 SEQ INIT FLAG
 MINOR FRAME
 FORMAT COUNTER RESET
 MAJOR FRAME
 FORMAT COUNTER RESET
 MAJOR FRAME #

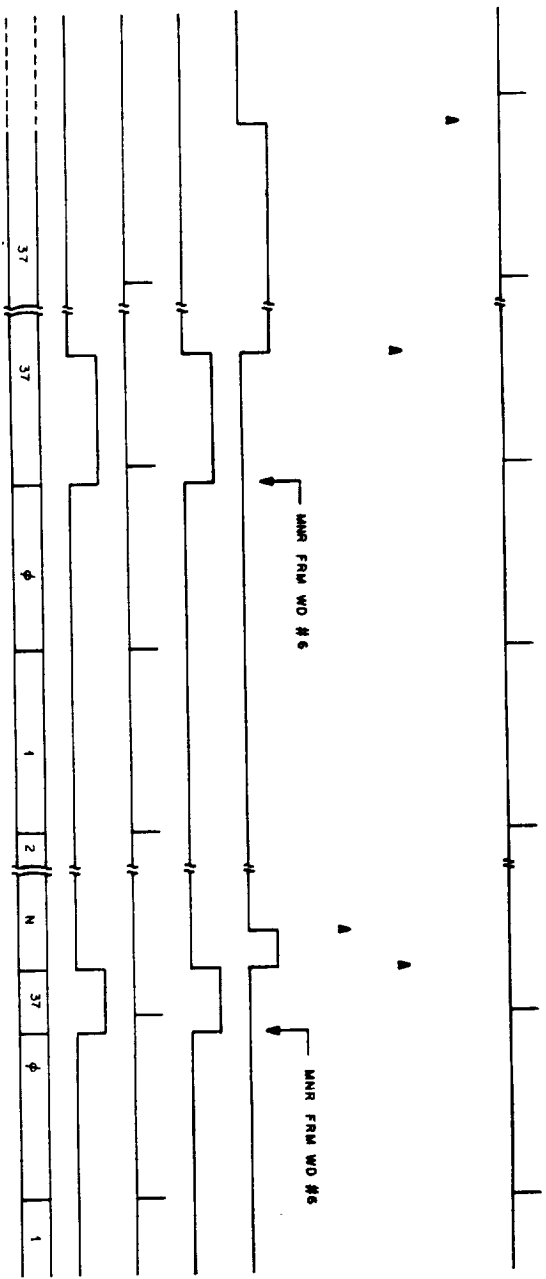

W H PINKUS	9/24/80	B T	10/21/80
PROGRAM COUNTER TIMELINE			
GALILEO - NMS			
B-E5043A			
10/24/80			

OCT 22 1982 17.14

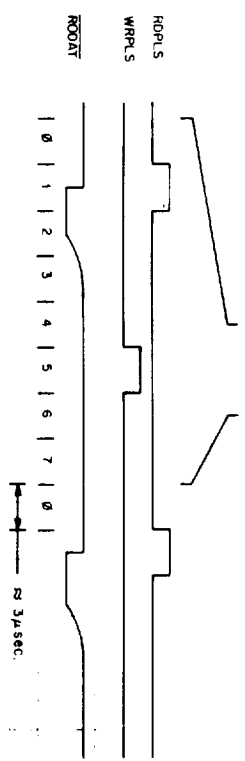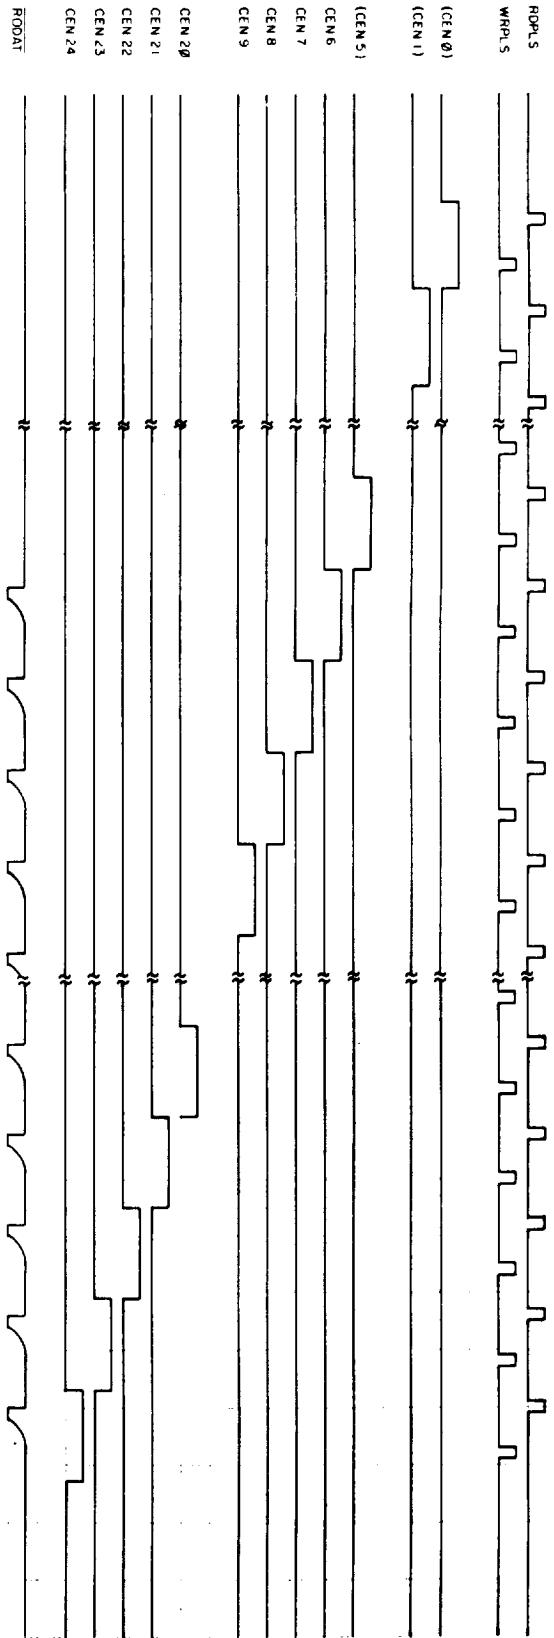

W H PINKUS	DATE: 12/4/80	TIME: 17.15
SPACE PHYSICS RESEARCH LABORATORY	HIS CORE MEMORY	
UNIVERSITY OF CALIFORNIA	TIMING DIAGRAM	
SPACE PHYSICS RESEARCH LABORATORY	GALILEO-NMS	
UNIVERSITY OF CALIFORNIA	B-E6388	

$$\text{FPA}(\text{TH})N$$

3	2	1	0	(9)	8	7	6	5	4	3	2	1	0
---	---	---	---	-----	---	---	---	---	---	---	---	---	---

[illegible]

Y = RECONSTRUCTION OF THE ORIGINAL ACCUMULATED SUM

ENGINEER W H PINNUS	DRAFTSMAN GRB	5/15/78	
SPACE PHYSICS RESEARCH LABORATORY COLLEGE OF ENGINEERING UNIVERSITY OF MICHIGAN ATIN ARBOR MICHIGAN	FLOATING - POINT CONVERSION TABLE DATA PROCESSING LOGIC GALILEO - NMS	B - E 4513	6-16-82 9-20-78 DATE

FILE:GCOMH.TXT S0 2 E4989 P0 17.2 1-15-79 JH

GMP5 COMMUTATOR ASSIGNMENTS

1. FMR MON +2V CURRENT
2. ANAPHAS V CONTROL
3. MULTANA MULTIFLEX ANALOG OUTPUT
4. EMIS 1 2.5V OFF, +5 GAIN, 0 TARGET
5. EMIS 2 2.5V OFF, +5 GAIN, 0 TARGET
6. REP MON 1 uA/V 5VOLT FULL SCALE
7. ACC MON 1 uA/V
8. HV MON 0 TO 5 VOLTS
9. FIL 1 FIL 1 CURRENT (PRI)
10. FIL 2 FIL 2 CURRENT (PRI)
11. T1 BIAS FB OF 30V OUT
12. T2 BIAS FB OF 70V OUT
13. T3 BIAS FB OF 70V OUT
14. T4 BIAS FB OF -350V OUT
15. OSC AGC RF OSC AGC VOLTAGE
16. PUMP 1 ION PUMP CURRENT (PRESSURE)
17. OSC TMP OSC TRANSFORMER TEMPERATURE
18. ELEC TMP TYPICAL ELECTRONICS TEMPERATURE
19. CELL 1 TMP
20. CELL 2 TMP
21. CELL 3 TMP
22. LEAK 1 TMP
23. LEAK 2 TMP
24. SHELL PRS
25. H2 PRS
26. HE PRS
27. TERM PRS
28. RF FREQ
29. CHND STAT
30. PGM STEP
31. VALVE STAT
32. HEATER

THERMISTOR PRESSURE GAGE
RF COUNT FROM OSC

SEQUENCE STEP
VALVE STATUS
HEATER STATUS

ENGINEER	J MAUER	1/15/79	DRAFTSMAN AS	1/16/79	
SPACE PHYSICS RESEARCH LABORATORY					
COLLEGE OF ENGINEERING					
UNIVERSITY OF MICHIGAN					
ANN ARBOR, MICHIGAN					
B-E 4989			COMMUTATOR ASSIGNMENTS		
			GALILEO NMS		
			DATE		

LAST USED R C D L

OCT 22 1982


[illegible]

FILE:MECH.FMT DISFIGURS-1
MECHANICAL DWG INDEX 1/8/82

DWG	NAME
C-037-001	PRELIMINARY INLET PC BRD
C-037-002	PRELIMINARY LOGIC PC BRD
C-037-003	CLEARANCE CHECKER
C-037-004	WEB#1 CENTER TUBE
C-037-005	WEB #2 CENTER TUBE
C-037-006	WEB #3 CENTER TUBE
C-037-007	WEB #4 CENTER TUBE
D-037-008	MOCK-UP FIXTURE
C-037-009	RING SUPPORT
B-037-010	SUPPORT BLOCK
C-037-011	CENTER TUBE MODIFICATIONS
A-037-012	PC BOARD SPACERS
A-037-013	PLUG BRACKET SPACERS
B-037-014	PC BOARD PULSE AMP ASYB
A-037-015	SPACER - PA ASYB
A-037-016	PULSE AMP ASYB
C-037-017	T1 MAIN TRANS. POTTING MOLD
C-037-018	FABRICATION FIXTURE
C-037-019	PROFILT GAUGE/MAIN HANDESS
C-037-020	
C-037-021	
C-037-022	
C-037-023	
C-037-024	
B-037-025	


DWG NO.	NAME
D-037-100	ELECTRONIC HOUSING LAYOUT
C-037-101	LOGIC PC BOARD #1
C-037-102	LOGIC PC BOARD #2
C-037-103	RF PC BOARD
C-037-104	POWER SUPPLY PC BOARD
C-037-105	INLET PC BOARD
C-037-106	FILAMENT PC BOARD
C-037-107	BIAS PC BOARD
C-037-108	PLUG BRACKET
C-037-109	RF SHIELD
B-037-110	34 PIN PLUG BRACKET
C-037-111	FILTER MOUNTING BRACKET
A-037-112	BERYLLIUM HEAT SINK
D-037-113	R.F. ASSEMBLY
D-037-114	R.F. HOUSING
C-037-115	R.F. COVER
B-037-116	GROUNET FEEDTHRU #3
B-037-117	GROUNET FEEDTHRU #1 & #2
R-037-118	FEEDTHRU PLATE
A-037-119	SPACER - TANK P.C. BD
A-037-120	TRANSFORMER SLEEVE
B-037-121	RETAINER BOARD
R-037-122	MOUNTING SOSS
B-037-123	20 PIN PLUG BRACKET
B-037-124	SINGLE SOLID TURRET TERMINAL
A-037-125	TRANSFORMER TIE DOWN FIL SUP.
A-037-126	TRANSFORMER TIE DOWN DRIVER BD.
B-037-127	TRANSISTOR HEAT SINK-PUMP SUPPLY
B-037-128	CHOKE TIE DOWN L-2/LOW VOLT
B-037-129	CHOKE L-1 & L-3 TIE DOWN/LVTS
B-037-130	CHOKE L-4, L-5 & L-6 TIE DOWN
B-037-131	T2-TRANSFORMER TRAP
A-037-132	INSULATOR WASHER
B-037-133	TRANSISTOR HEAT SINK

ENGINEER	DRAFTSMAN
SPACE PHYSICS RESEARCH LABORATORY	
COLLEGE OF ENGINEERING	
UNIVERSITY OF MICHIGAN	
ANN ARBOR, MICHIGAN	
MECHANICAL INDEX	GNMS
B-E6315	
DATE	

LAST USED R C D L

OCT 22 1982

18.6

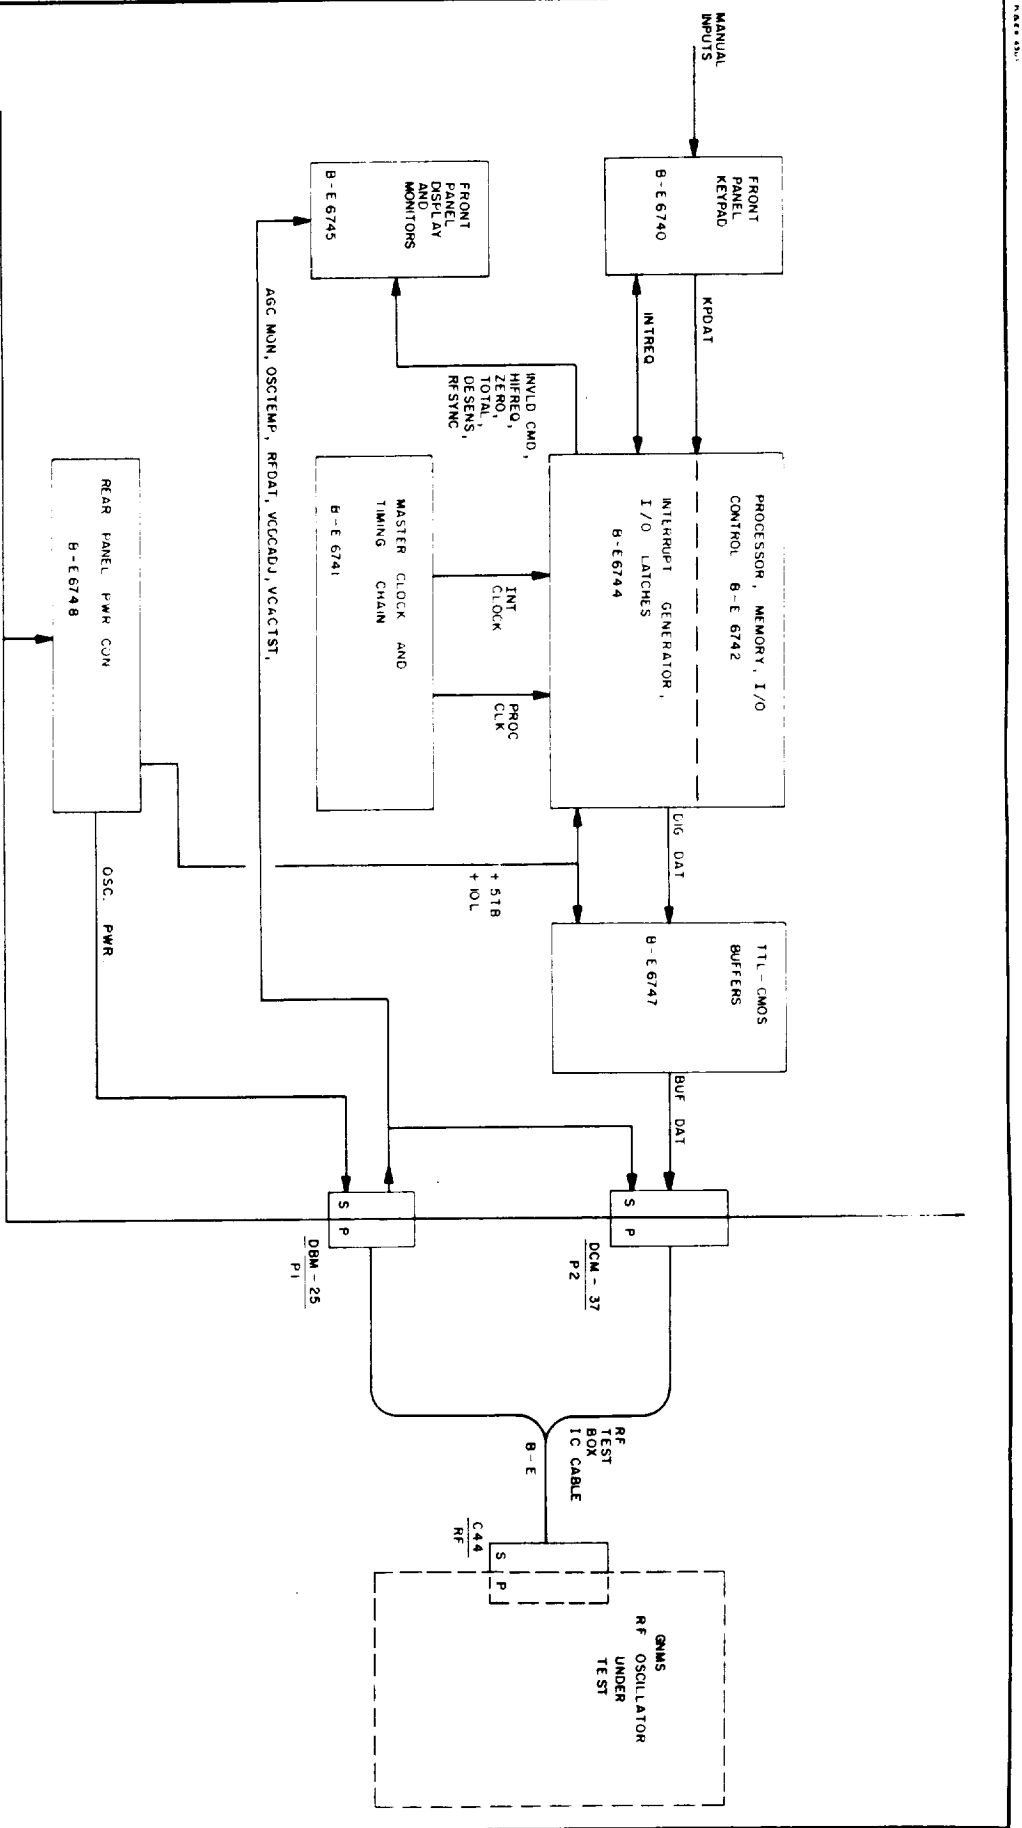


ENGINEER BLOCK		DRAFTSMAN G. WIGGINS	11/17/81
SPACE PHYSICS RESEARCH LABORATORY		BLOCK DIAGRAM	
COLLEGE OF ENGINEERING		R.F. OSC. TEST BOX	
UNIVERSITY OF MICHIGAN		GALILEO	
ANN ARBOR MICHIGAN		B-E 6739	
		DATE	

OCT 22 1982 19.1

LAST USED R C D L

GRAYHILL 88B - C2 - 082
4 X 4 KEYPAD

FRONT PANEL MOUNT

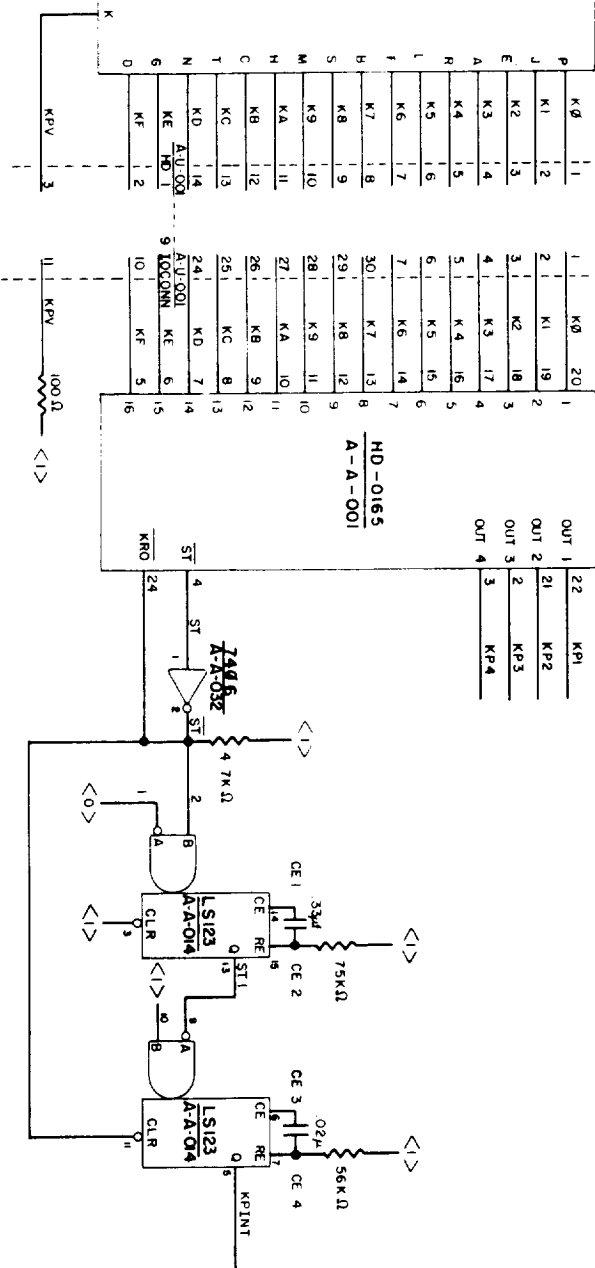

A - U - 009
HD

A-U-009
IOCONN

ENGINEER B BLOCK

SPACE PHYSICS RESEARCH LABORATORY
COLLEGE OF ENGINEERING
UNIVERSITY OF MICHIGAN
ANN ARBOR, MICHIGAN



DRAFTSMAN G WIGGINS
FRONT PANEL KEYPAD
R.F. OSC. TEST BOX
GALILEO
B-E 6740

DATE _____

LAST USED R	C	D	L
1			
2			
OCT 22 1982








19.2

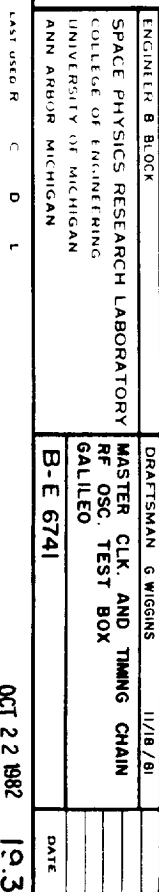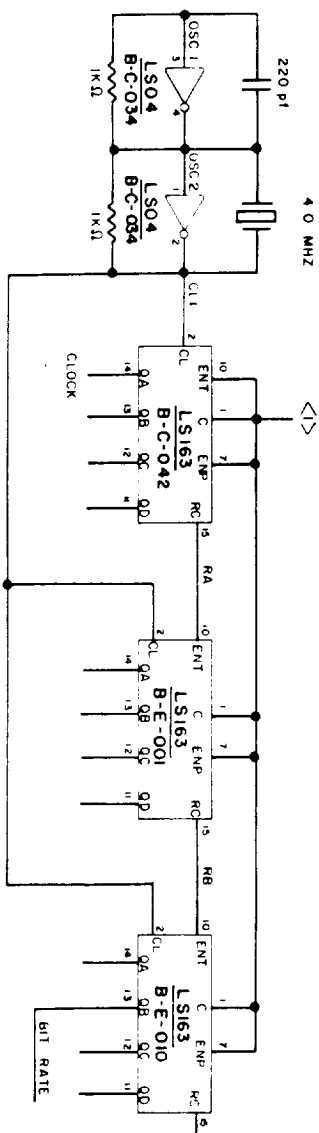

OCT 22 1982 19.3




19.4

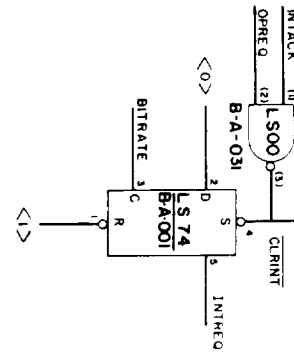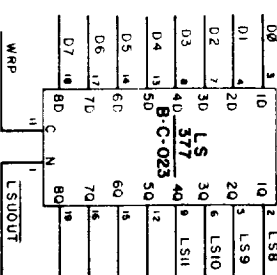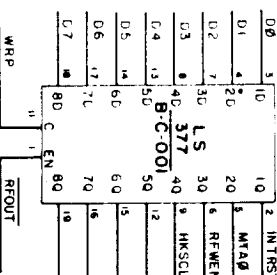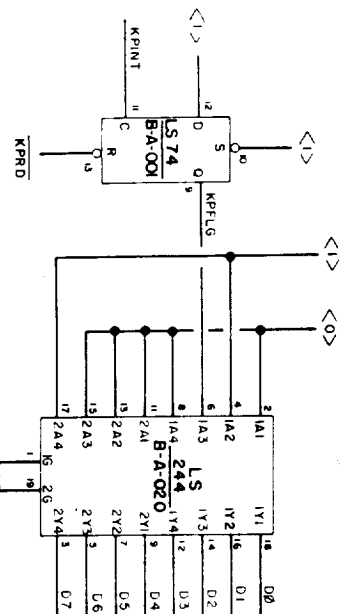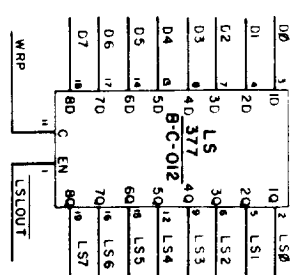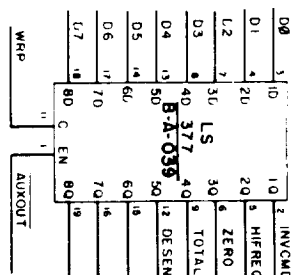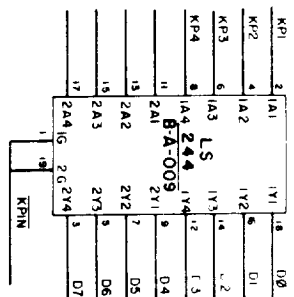



ENGINEER B BLOCK	DRAFTSMAN G WIGGINS	11/9/81
SPACE PHYSICS RESEARCH LABORATORY	INTERUPT GEN. I/O	
COLLEGE OF ENGINEERING	R.F. OSC. TEST BOX	
UNIVERSITY OF MICHIGAN	GALILEO	
ANN ARBOR MICHIGAN	B-E 6744	
		DATE

OCT 22 1982 19.5

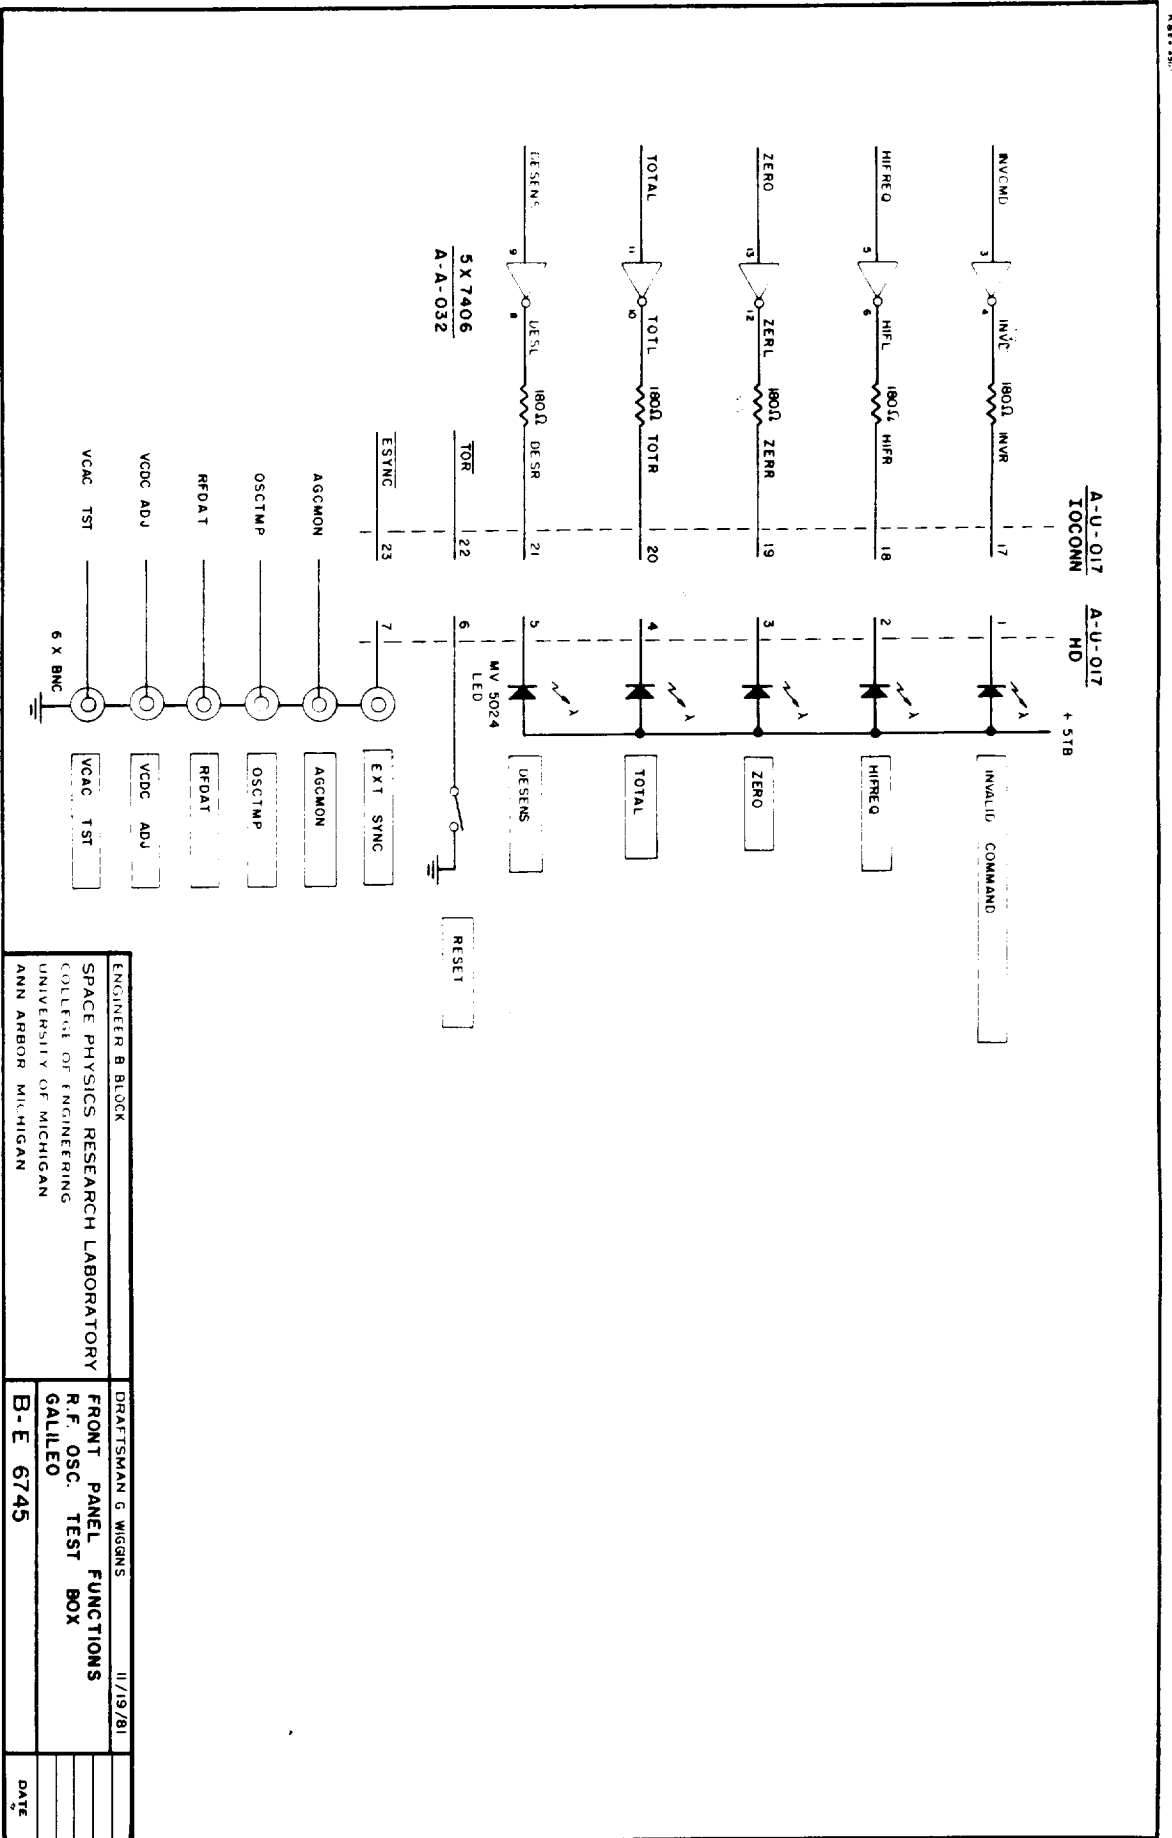

ENGINEER B BLOCK		DRAFTSMAN G WIGGINS		11/19/81	
SPACE PHYSICS RESEARCH LABORATORY		FRONT PANEL FUNCTIONS			
COLLEGE OF ENGINEERING		R.F. OSC. TEST BOX			
UNIVERSITY OF MICHIGAN		GALILEO			
ANN ARBOR MICHIGAN		B-E 6745			
				DATE	

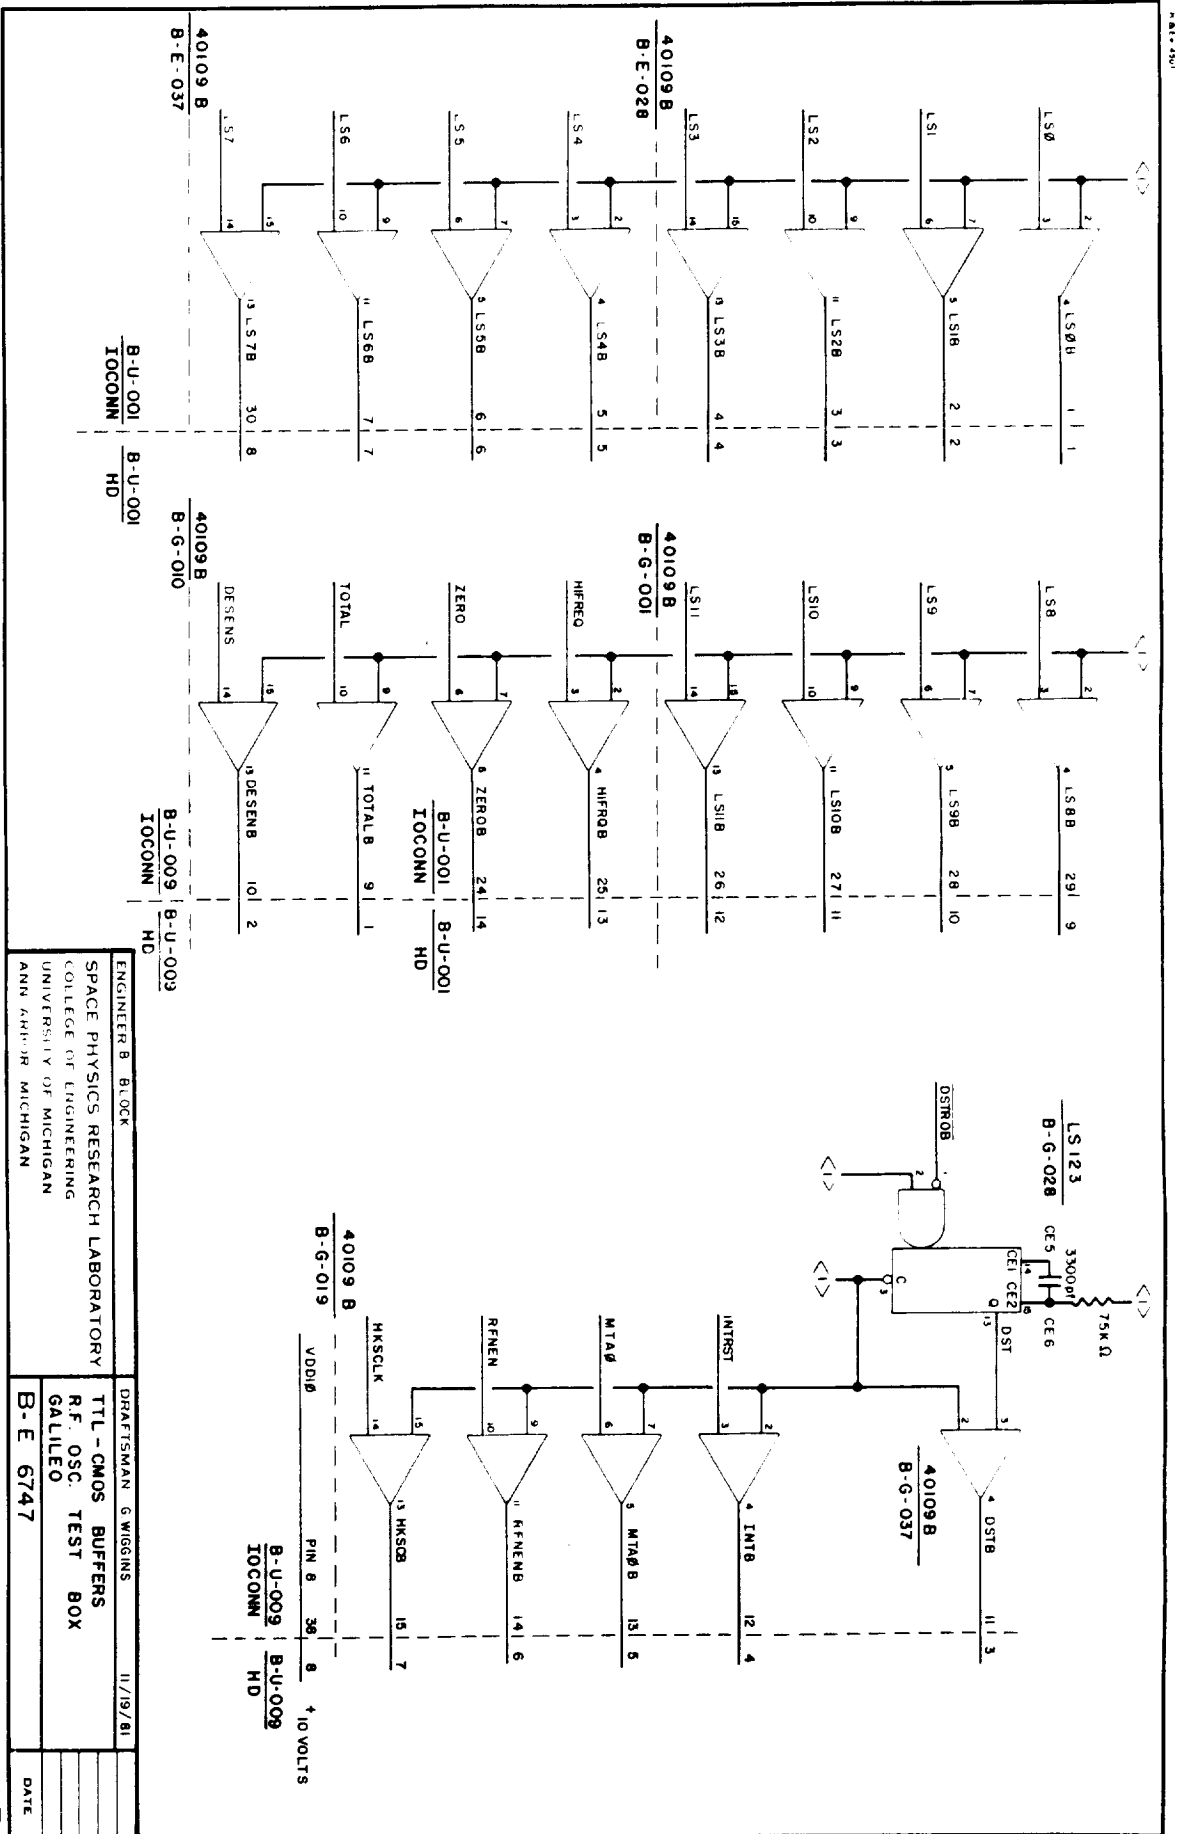

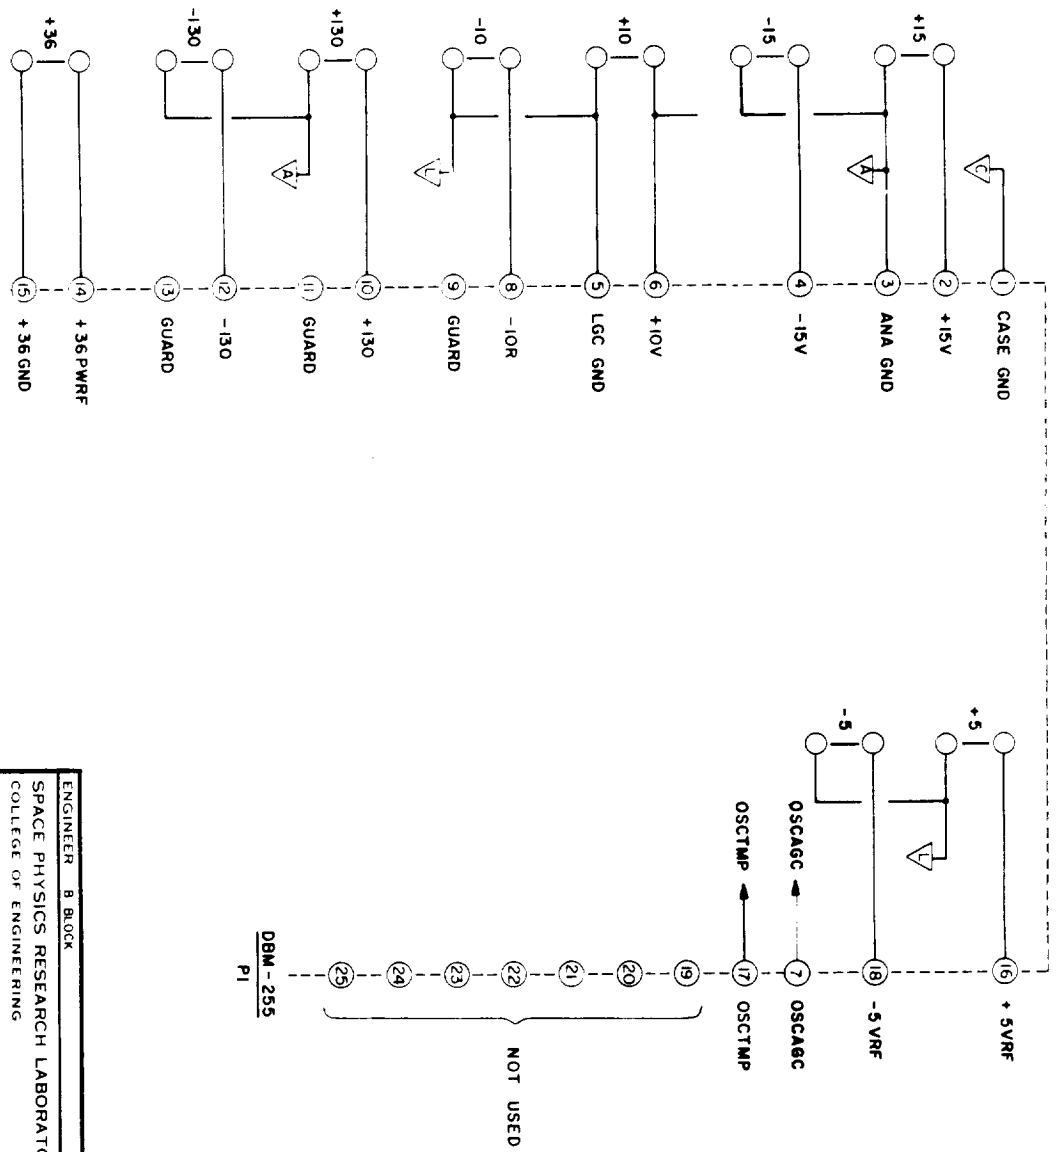

ENGINEER B BLOCK	DRAFTSMAN N D	
SPACE PHYSICS RESEARCH LABORATORY	REAR PANEL WIRING	
COLLEGE OF ENGINEERING	RF OSC TEST BOX	
UNIVERSITY OF MICHIGAN	GNMS RF OSC	
ANN ARBOR, MICHIGAN	B-E6748	
		DATE
		11/13/81


LAST USED R C D L

OCT 22 1982


19.8

SIGNAL NAME	TEST BOX P1 (DEM-25P)	RF OSCILLATOR RF (44S)
CASE	1	N/C
+15V	2	A
ARMAGND	3	F
-15V	4	L
LOCCHD	5	C
+10V	6	B
OSCACC	7	F
-10R	8	K
GUARD	9	N/C
+130	10	YY
GUARD	11	N/C
-130	12	ZZ
N/C	13	N/C
+36PURF	14	H
+36GND	15	M
+5	16	S
OSCTHP	17	D
-5VRF	18	N
N/C	19	N/C
N/C	20	N/C
N/C	21	N/C
N/C	22	N/C
N/C	23	N/C
N/C	24	N/C
N/C	25	N/C




SIGNAL NAME	TEST BOX P2 (DCN-37P)	RF OSCILLATOR RF (44S)
LS0	1	U
LS1	2	V
LS2	3	W
LS3	4	X
LS4	5	Y
LS5	6	Z
LS6	7	AA
LS7	8	BB
LS8	9	CC
LS9	10	DD
LS10	11	EE
LS11	12	FF
N/C	13	N/C
DCSTR	14	HH
WIFREQ	15	JJ
ZERO	16	KK
TOTAL	17	LL
DEFENS	18	MM
N/C	19	N/C
HTA0000	20	NN
INTRST	21	PP
RFVEN	22	RR
RPDAT	23	SS
HKSCCLK	24	TT
N/C	25	N/C
VCDC ADJ	26	R
VCAC TST	27	T

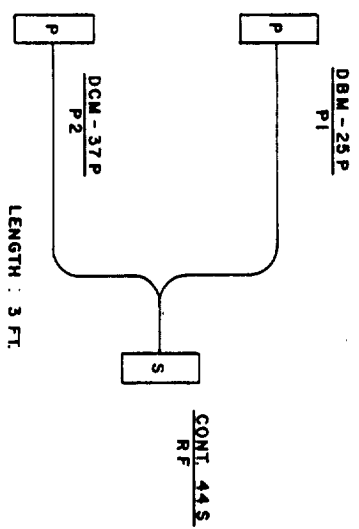

ENGINEER B. BLOCK	DRAFTSMAN D.B.J.	
SPACE PHYSICS RESEARCH LABORATORY	RF IC CABLE	
COLLEGE OF ENGINEERING	RF OSC. TEST BOX	
UNIVERSITY OF MICHIGAN	GALILEO NMS	
ANN ARBOR, MICHIGAN	B-E 6760	
		I/B/82
		DATE

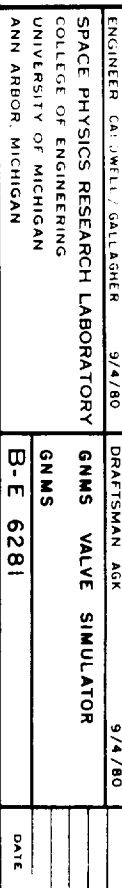


OCT 22 1982 19.10

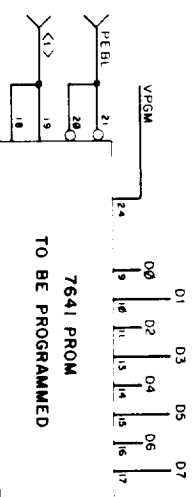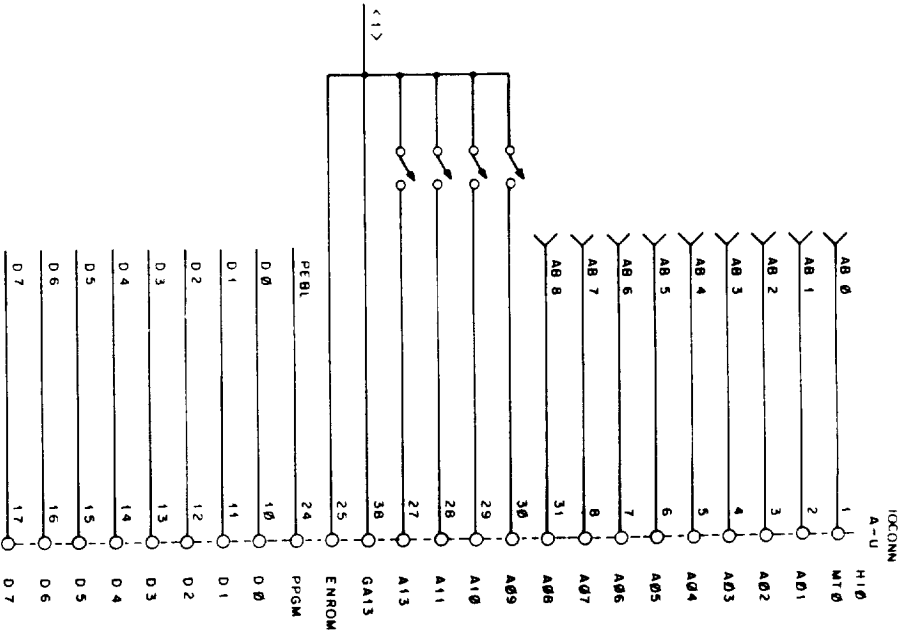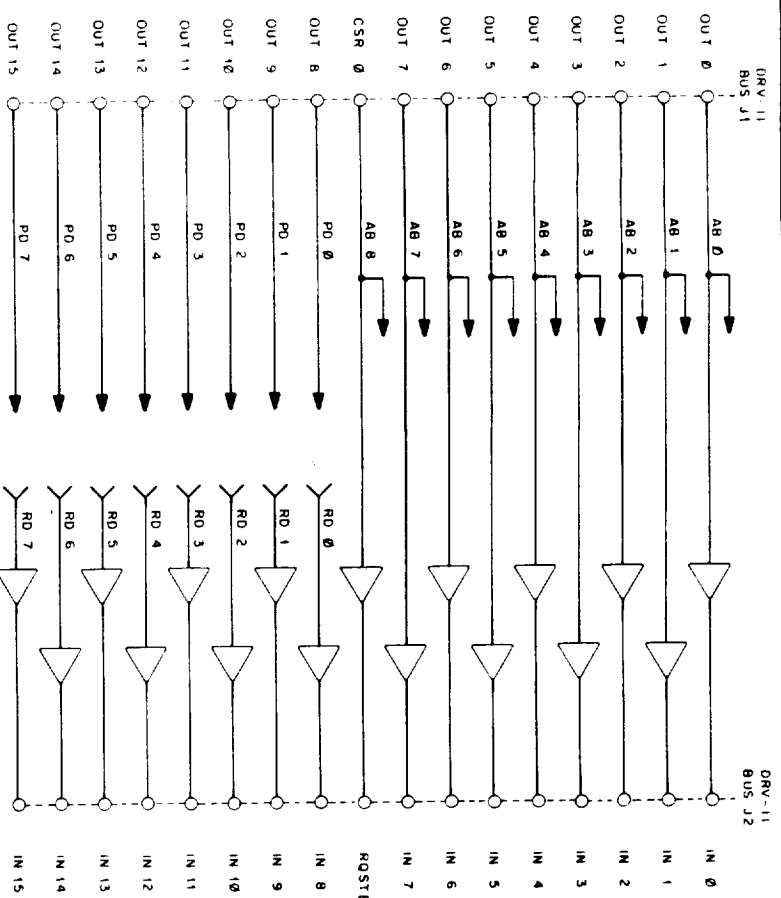

ENGINEER B POTTER	DRAFTSMAN B T	5/10/80
SPACE PHYSICS RESEARCH LABORATORY		
COLLEGE OF ENGINEERING		
UNIVERSITY OF MICHIGAN		
ANN ARBOR, MICHIGAN		
INTERFACES SEMI-MANUAL PROGRAMMER FOR 7641 PROM GALLEO NMS		DATE
B-E6282		

OCT 22 1982 19.11

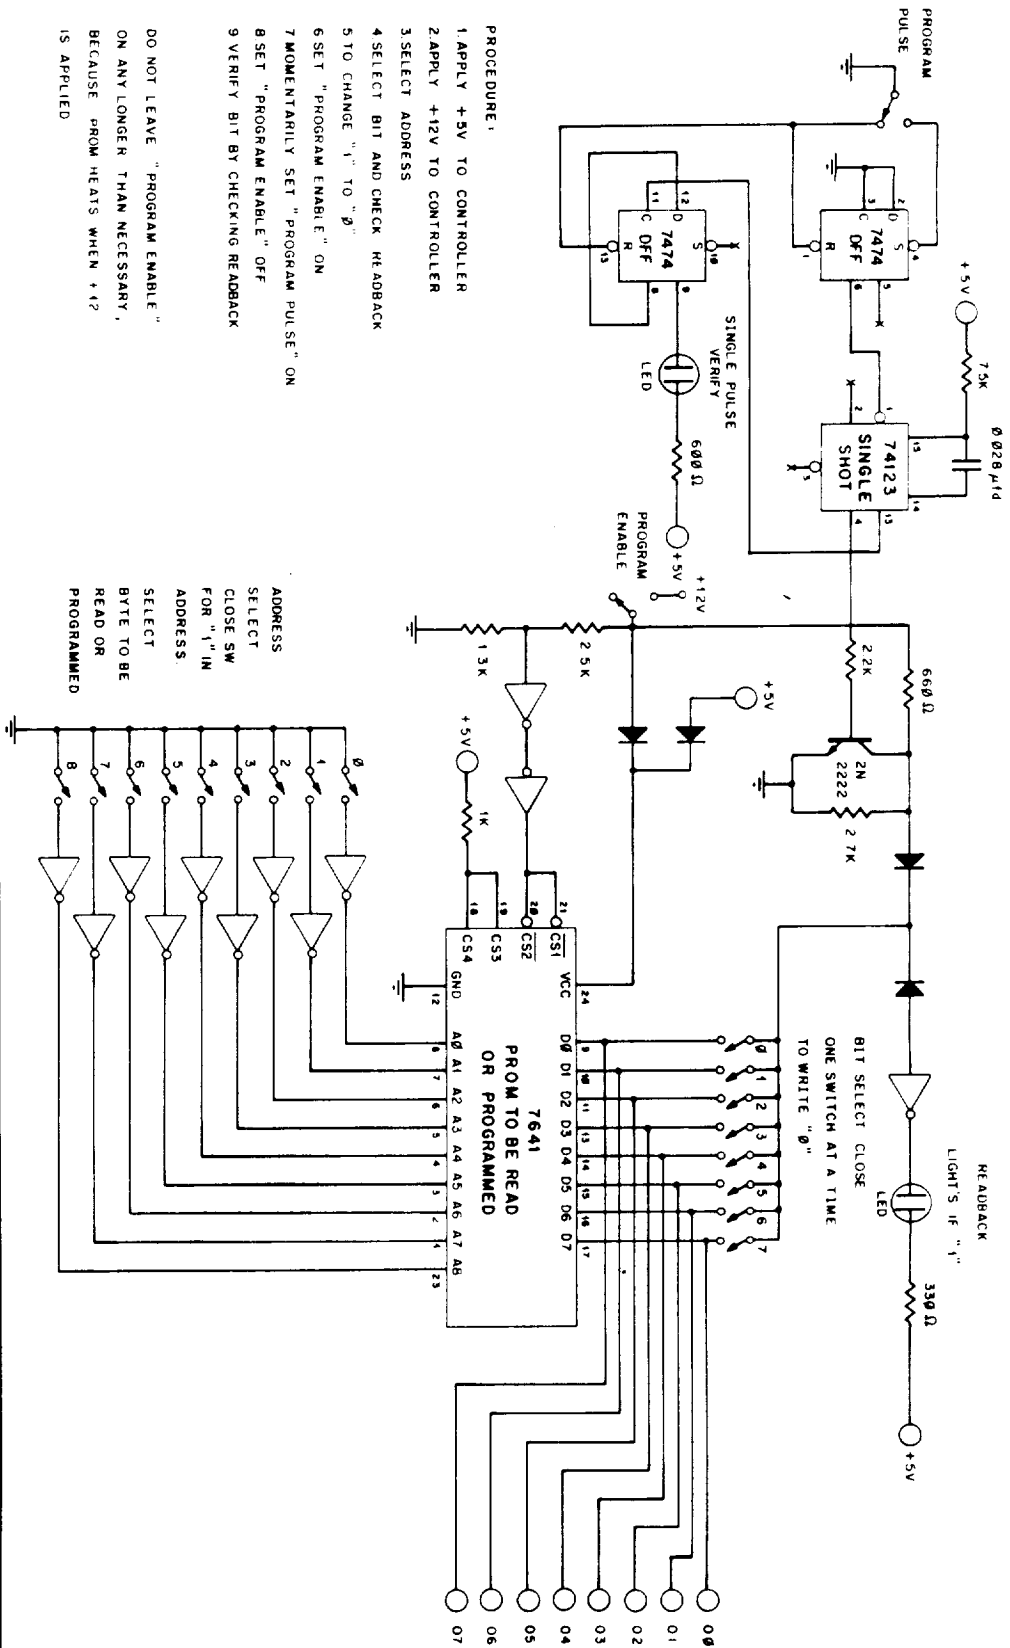

- PROCEDURE:
1. APPLY +5V TO CONTROLLER
 2. APPLY +12V TO CONTROLLER
 3. SELECT ADDRESS
 4. SELECT BIT AND CHECK HEADBACK
 5. TO CHANGE "1" TO "0"
 6. SET "PROGRAM ENABLE" ON
 7. MOMENTARILY SET "PROGRAM PULSE" ON
 8. SET "PROGRAM ENABLE" OFF
 9. VERIFY BIT BY CHECKING HEADBACK

DO NOT LEAVE "PROGRAM ENABLE" ON ANY LONGER THAN NECESSARY, BECAUSE PROM HEATS WHEN +12V IS APPLIED

ENGINEER W.H. POTTER 8/6/80

SPACE PHYSICS RESEARCH LABORATORY

COLLEGE OF ENGINEERING

UNIVERSITY OF MICHIGAN

ANN ARBOR, MICHIGAN

DRAFTSMAN BT

MANUAL PROGRAMMER FOR

TYPE 7641 PROM


GALLEO - NMS

B-E6272

DATE

OCT 22 1982 19.12


PGM START
FROM COMP

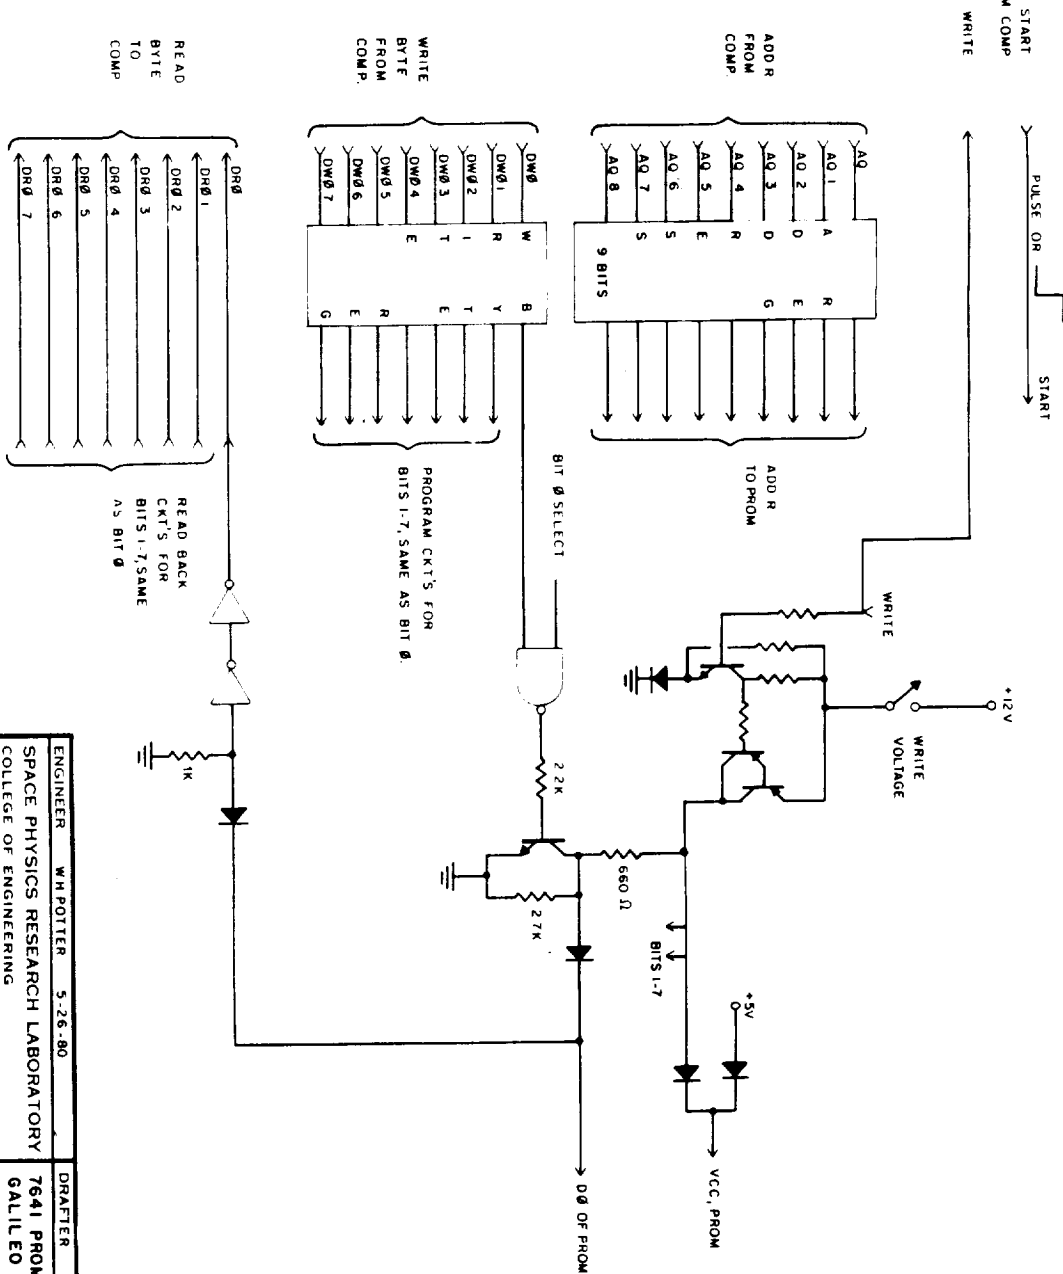

ENGINEER	W H POTTER	5-26-80	DRAFTER	W F G	8-5-80
SPACE PHYSICS RESEARCH LABORATORY			7641 FROM PROGRAMMER		
COLLEGE OF ENGINEERING			GALLIEO NMS		
UNIVERSITY OF MICHIGAN					
ANN ARBOR, MICHIGAN			B-E 6273		
			DATE		

CAST USED R	C	D	1
1	1	1	1
2	1	1	1
OCT 22 1982 19.14

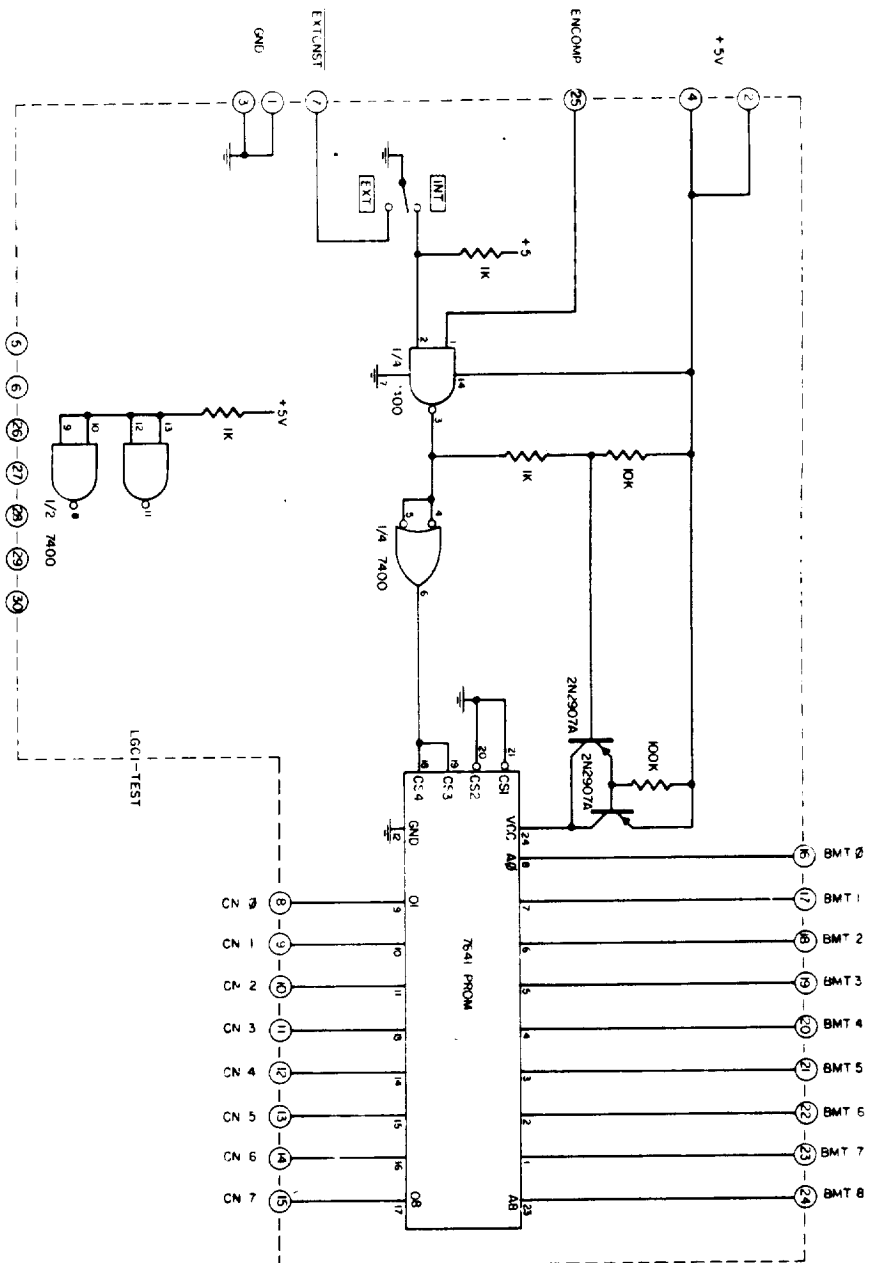


ENGINEER W. PINKUS
SPACE PHYSICS RESEARCH LABORATORY
COLLEGE OF ENGINEERING
UNIVERSITY OF MICHIGAN
ANN ARBOR, MICHIGAN

DRAFTSMAN D. R.
CALCULATOR PROM HIS
TEST JIG
GALILEO NMS
B-66490
DATE


LAST USED R C D L

OCT 22 1982

19.16

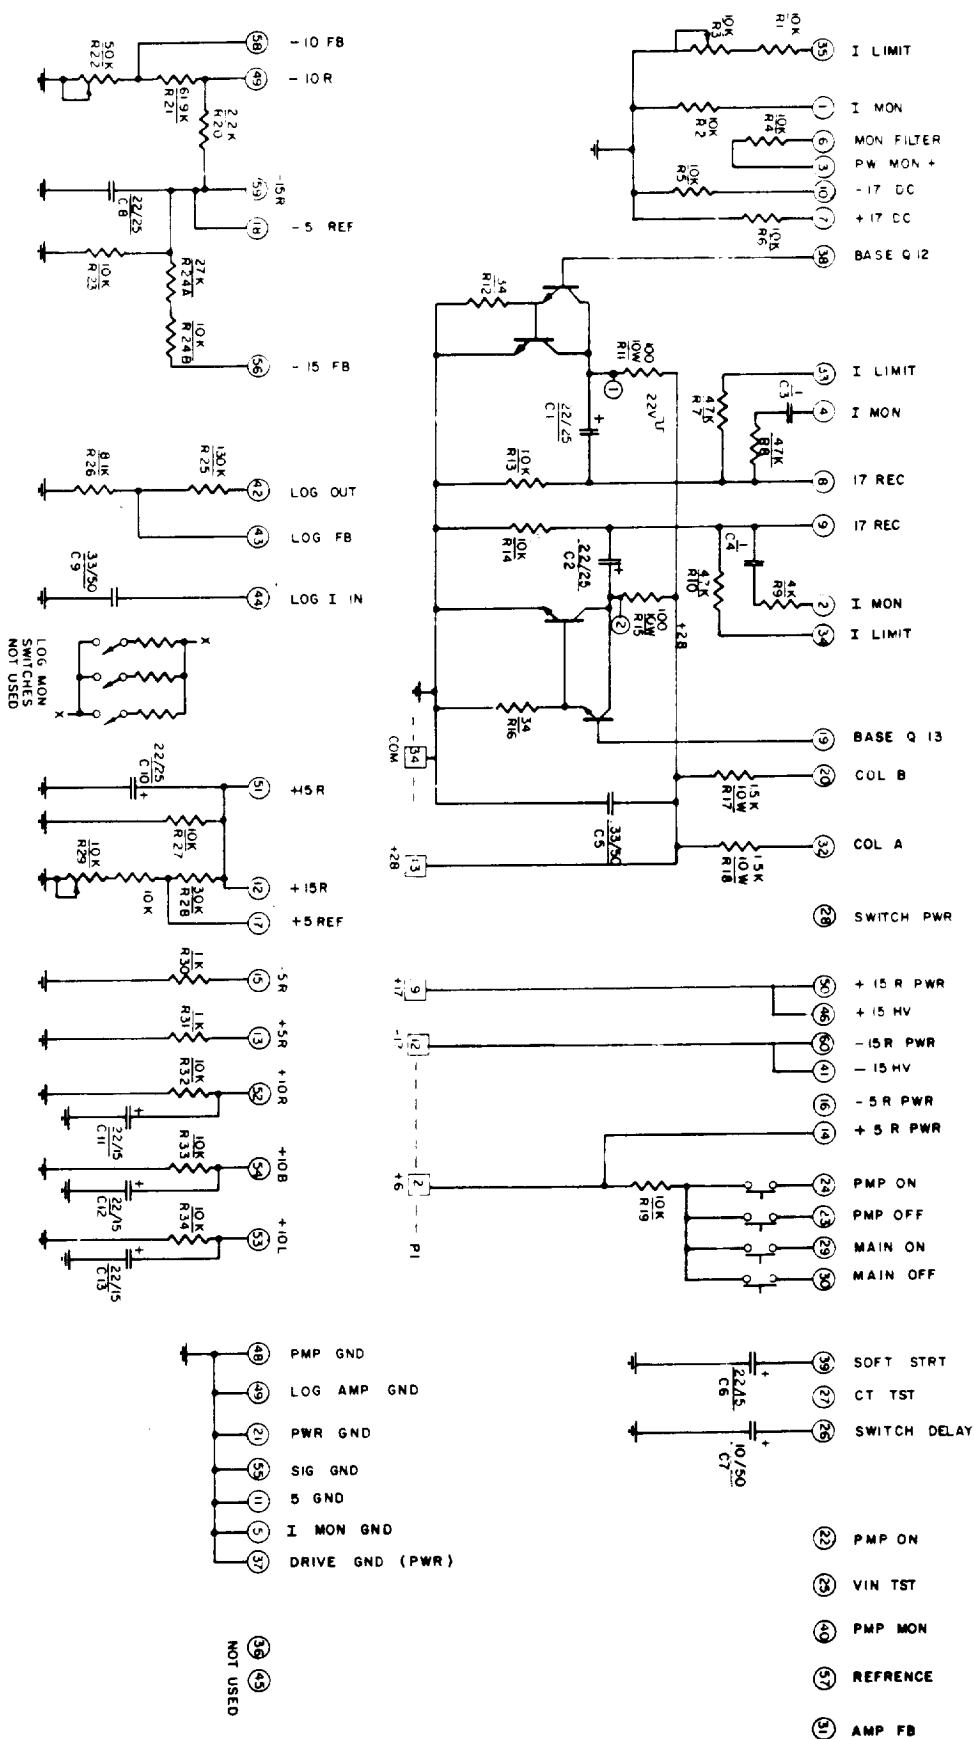


ENGINEER J. MAIER
 SPACE PHYSICS RESEARCH LABORATORY
 COLLEGE OF ENGINEERING
 UNIVERSITY OF MICHIGAN
 ANN ARBOR MICHIGAN
 DRAFTSMAN D. JONES/G. WIGGINS
 REVISED TEST BOX
 HYBRID HI
 GNMS
 B-E 6755
 DATE
 OCT 22 1982
 19.17

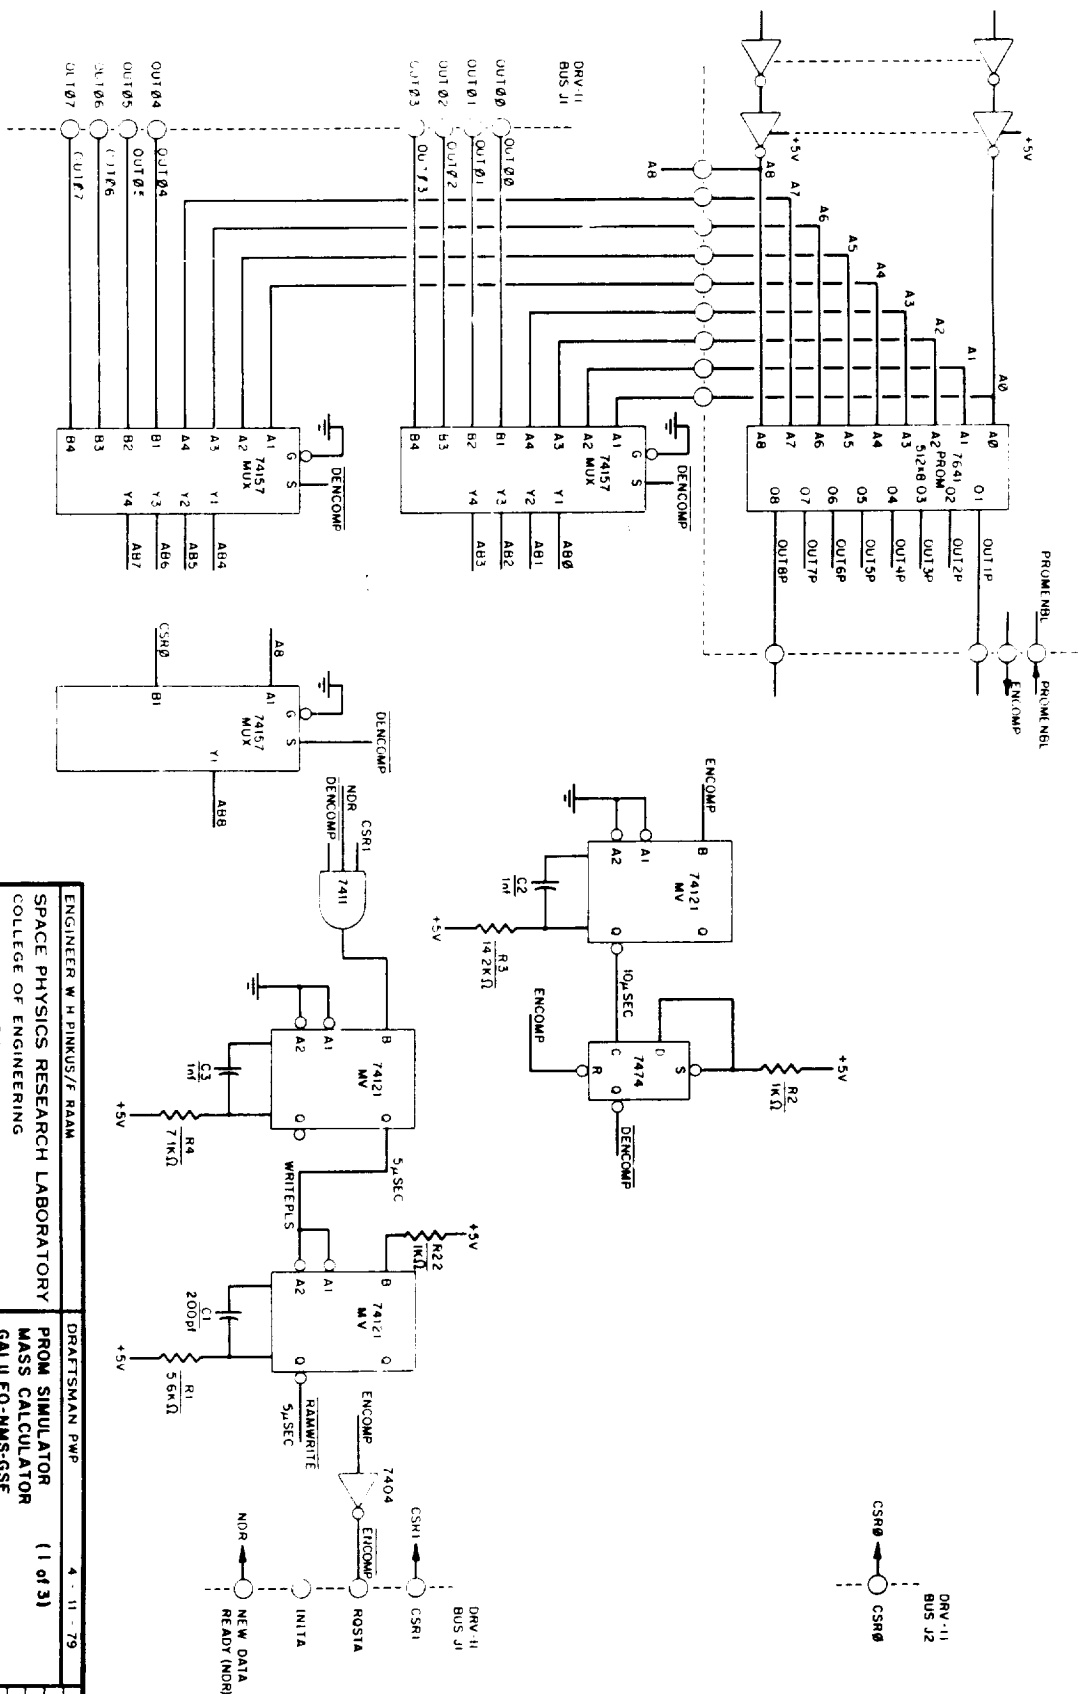


ENGINEER W. H. PINKUS/E. RAAM	DRAFTSMAN PMP	4 - 11 - 79
SPACE PHYSICS RESEARCH LABORATORY	PROM SIMULATOR	(1 of 3)
COLLEGE OF ENGINEERING	MASS CALCULATOR	
UNIVERSITY OF MICHIGAN	GALILEO-NMS-GSE	
ANN ARBOR, MICHIGAN	B-E5210	
		DATE

OCT 22 1982 19:16

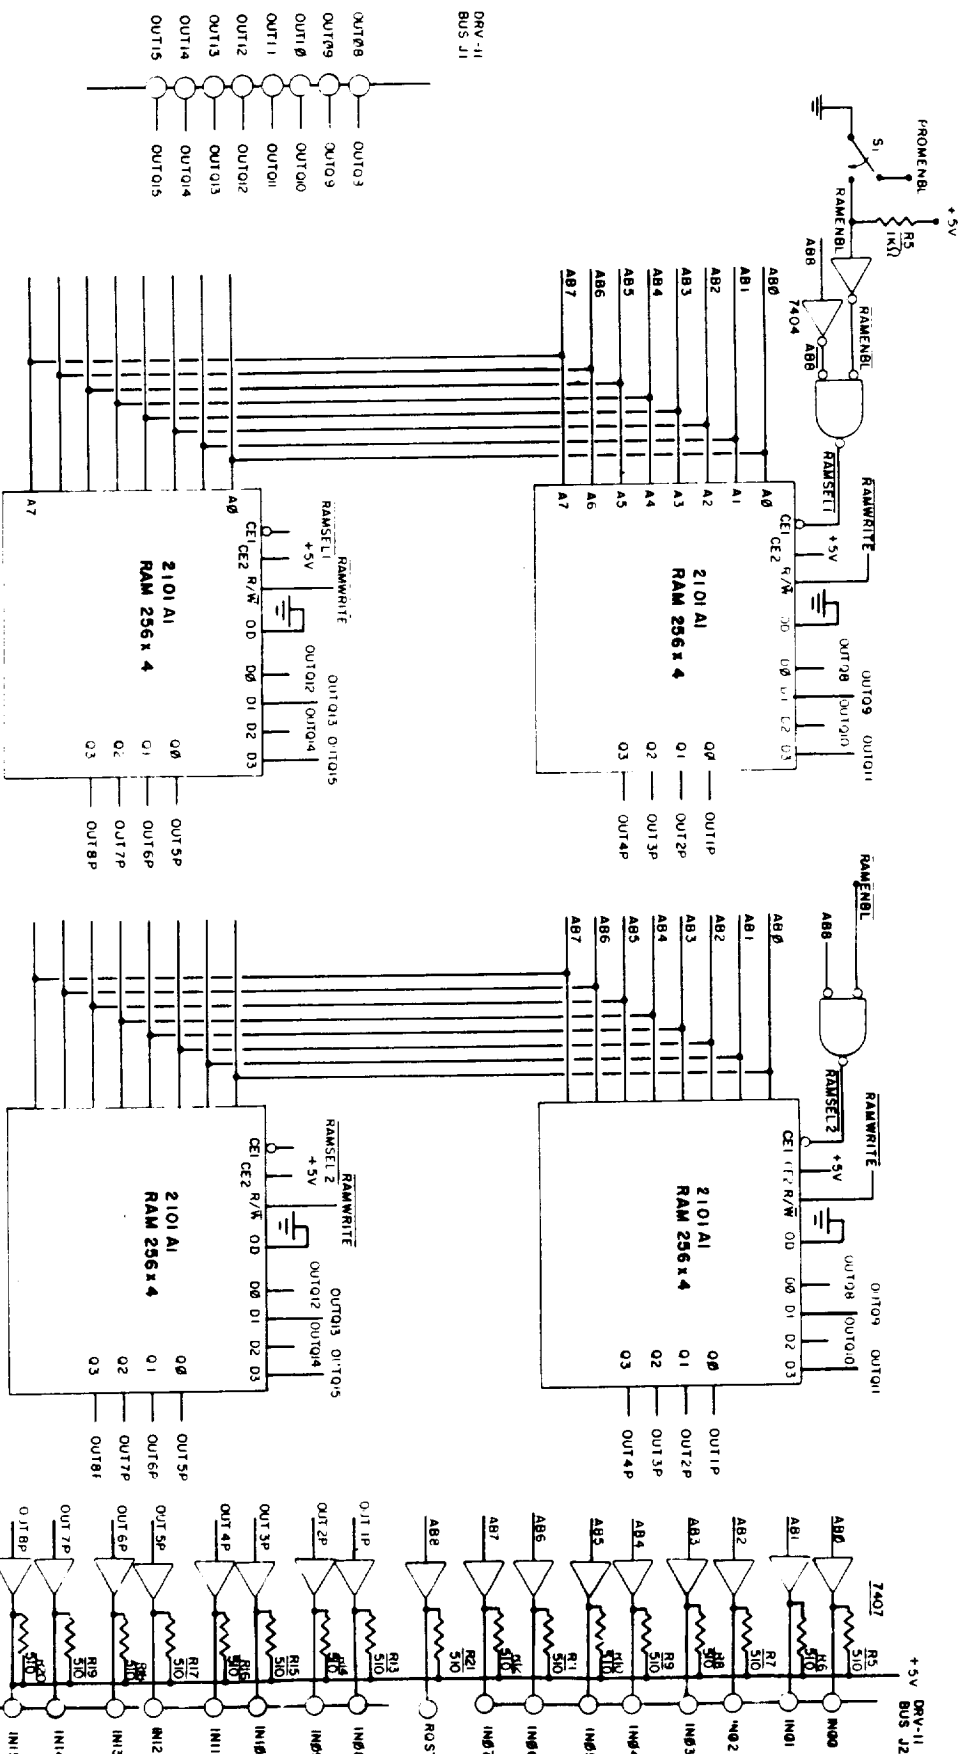

ENGINEER: W. PINNUS / E. RAAM	DRAFTSMAN: IS. 4-11-79
SPACE PHYSICS RESEARCH LABORATORY	PROM SIMULATOR (2 of 3)
COLLEGE OF ENGINEERING	MASS CALCULATOR
UNIVERSITY OF MICHIGAN	GALILEO - NMS - GSE
ANN ARBOR MICHIGAN	B-E 5212
	DATE


OCT 22 1982 19.19

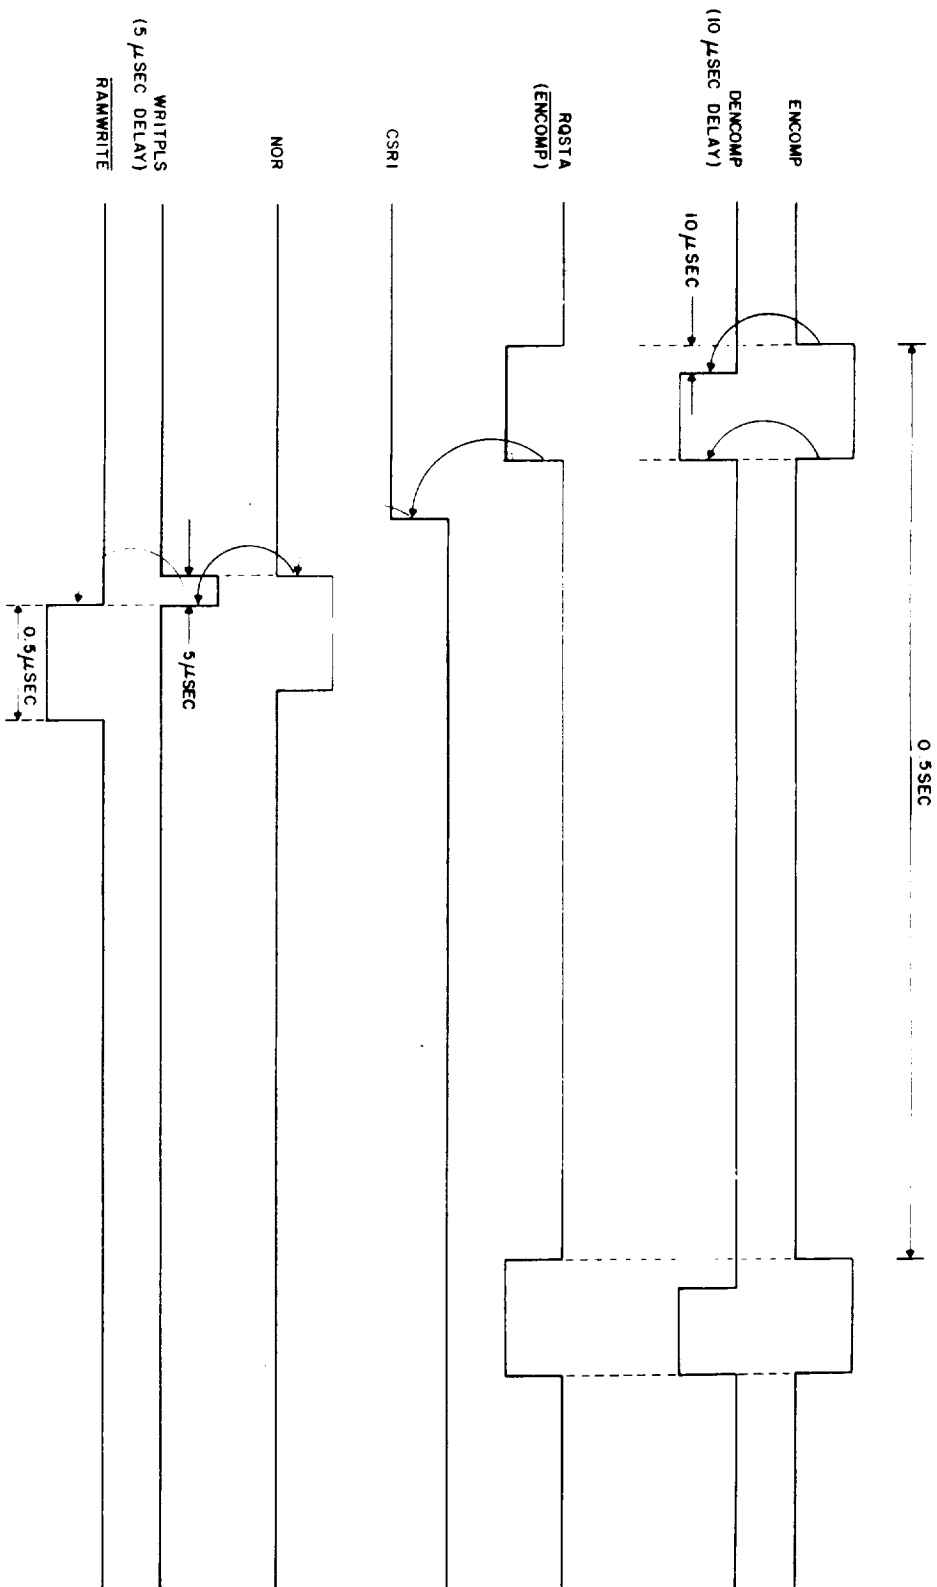

ENGINEER	F. RAAM	DRAFTSMAN	TS	10-15-79
SPACE PHYSICS RESEARCH LABORATORY				
COLLEGE OF ENGINEERING				
UNIVERSITY OF MICHIGAN				
ANN ARBOR, MICHIGAN				
H II PROM SIMULATOR		TIMING DIAGRAM		
GALILEO-NMS		B. E. 5682		
DATE		11/5/79		

LAST USED R C D L

OCT 22 1982 19.20

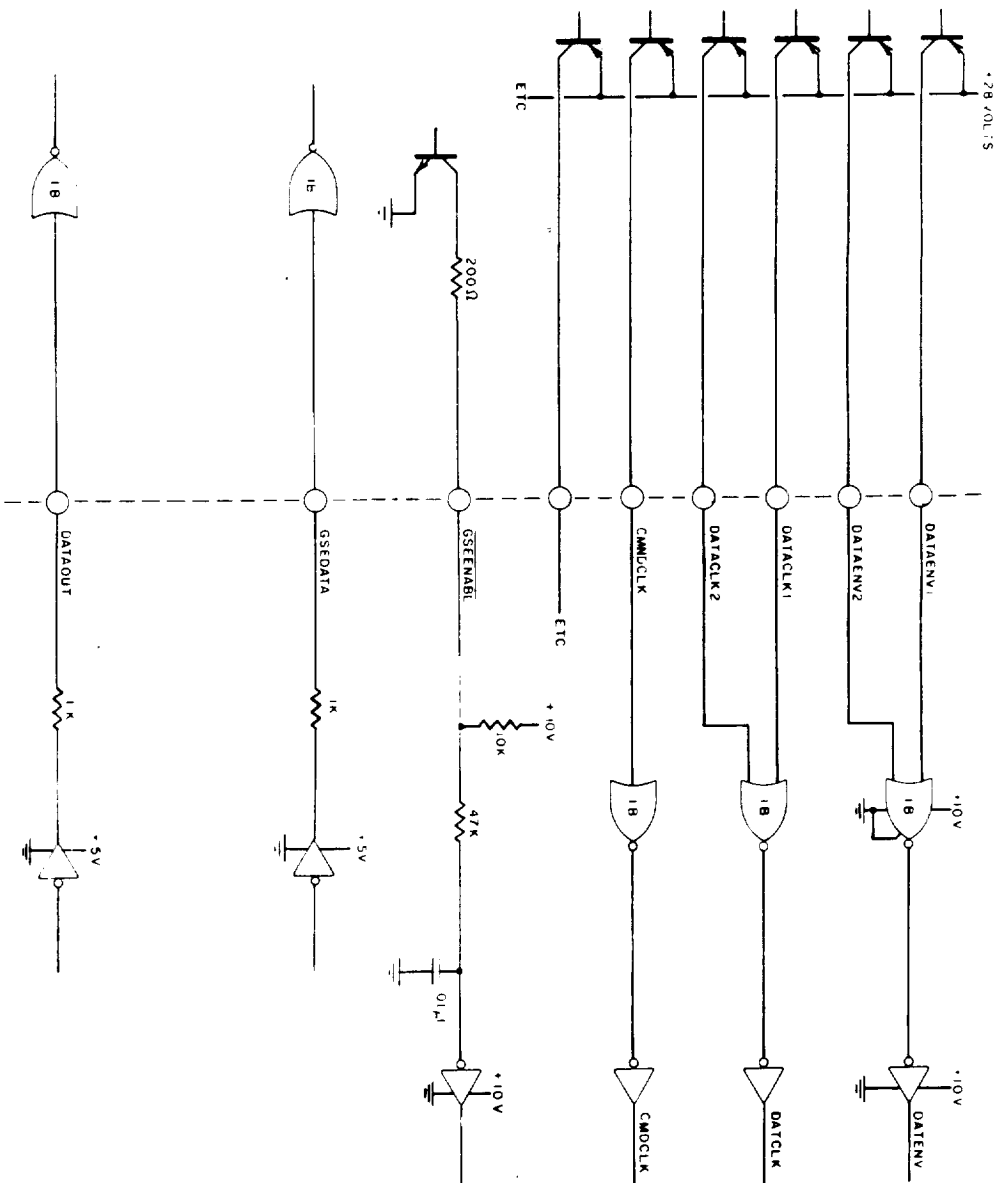


ENGINEER	PINKUS	5/14/79	DRAFTSMAN	E.T.	5/15/79
SPACE PHYSICS RESEARCH LABORATORY					
COLLEGE OF ENGINEERING					
UNIVERSITY OF MICHIGAN					
ANN ARBOR, MICHIGAN					
GSE - INSTRUMENT			GSE - INSTRUMENT		
LOGIC INTERFACE			LOGIC INTERFACE		
GALILEO - NMS			GALILEO - NMS		
B-E5307			B-E5307		
DATE			DATE		

LAST USED R C D L

OCT 22 1982

19.21

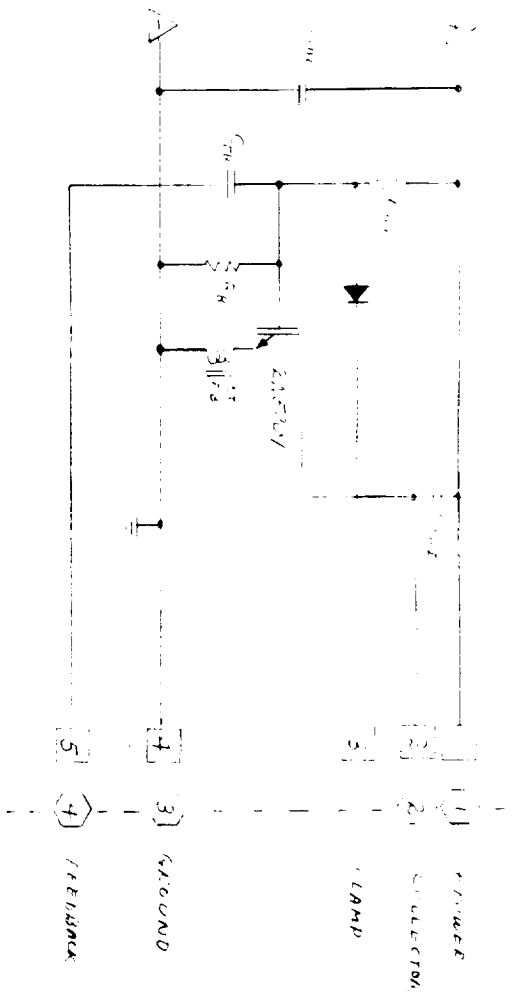




ENGINEER	J. S.	DRAFTSMAN	B.
SPACE PHYSICS RESEARCH LABORATORY		TRANSFORMER TEST CIRCUIT	
COLLEGE OF ENGINEERING		G.A.M.	
UNIVERSITY OF MICHIGAN		B-E 6756	
ANN ARBOR, MICHIGAN		DATE	

LAST USED R C D L
OCT 22 1982 19.22

ENGINEER	DRAFTSMAN	
SPACE PHYSICS RESEARCH LABORATORY	<i>Bias Supply</i>	
COLLEGE OF ENGINEERING	<i>GENERAL TEST SETUP</i>	
UNIVERSITY OF MICHIGAN	<i>GNMS</i>	
ANN ARBOR, MICHIGAN	B- E 6757	
		<i>1-27-81</i>
		DATE

OCT 22 1982


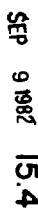


CMX 563 C

POTTING: E & C 2650 FT. BLACK WITH CAT II



ION PUMP HV SUPPLY

1. INPUT POWER
 - UNREGULATED ($\pm 5\%$)
2. TYPE
 - PARALLEL
3. STAGES
 - 5
4. INPUT
 - TBD (SQUARE)
 - 30KHZ
 - 1000V P-P NORMAL
 - 2000V P-P TEST
5. OUTPUT
 - POSITIVE
 - 5KV AT .5MA NOMINAL
 - 1KV AT 5MA CONTINUOUS POSSIBLE
 - 10KV AT NO LOAD TEST
 - LESS THAN 50V P-P RIPPLE AT 5MA
6. SIZE
 - SEE DRAWING AT RIGHT
7. ENVIRONMENTAL
 - 30 TO +50°C OPERATING
 - 40 TO +60°C NON-OPERATING
 - 30PSIA TO VACUUM
 - LAUNCH VIBRATION SPECIFICATIONS (18G @ 100HZ SINE, 400 G ACCELERATION)
8. MISC.
 - 10K R-C FILTER
 - 4.7K OUTPUT CURRENT LIMIT
 - $\pm 20\%$ TEMPERATURE CO-EFFICIENT
 - REQD REQUIREMENT SPECIFICATION 79/113
 - HIGH VOLTAGE DEVICES #CMX563C

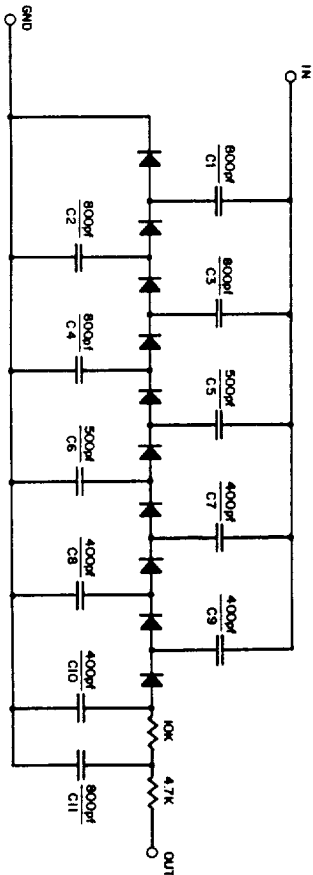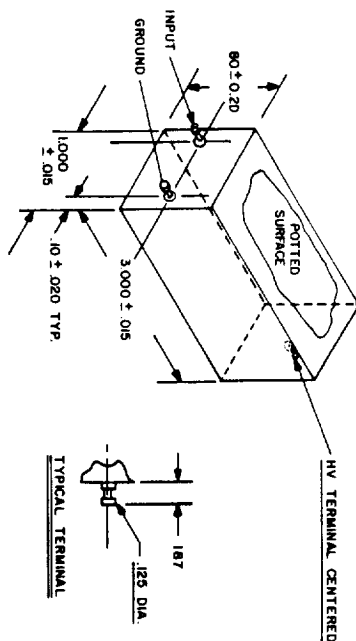

ENGINEER J STEVENS	DRAFTSMAN EL	6/16/83
SPACE PHYSICS RESEARCH LABORATORY	VOLTAGE MULTIPLIER	
COLLEGE OF ENGINEERING	ION PUMP SUPPLY	
UNIVERSITY OF MICHIGAN	GNMS	6/6/83
ANN ARBOR, MICHIGAN	B-E 5343 CONTROLLED	7/5/81
		DATE

LAST USED R C D L

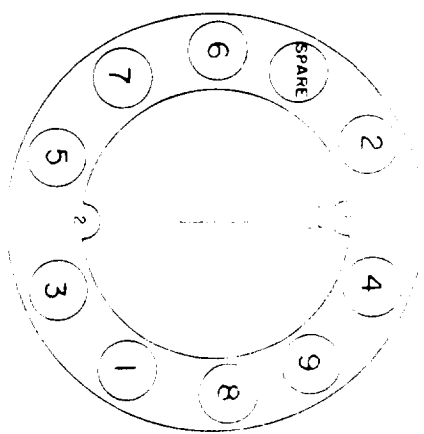 

TOP DOWN VIEW


NOTES:

1. CORE SQUARE WITH WIRES EXIT TRANSFORMER
2. HAT BRIM IS 1/2 IN. DIA.
5. DRILL SIZES A) # 36 IN HAT BRIM FOR SWAGING
B) # 63 IN BIAS FOR MOUNTING SCREW
C) # 33 IN HAT FOR MOUNTING SCREW
6. MOUNTING SCREW IS # 4 40 NYLON
7. MAGNETICS INC FA1408-LG POWER FREQUENCY CORE
B1408-01 DELRIN BOBBIN



DESIGNED BY: MAHER / FRIEDMAN	DESIGNED BY: MAHER / FRIEDMAN
SPACE PHYSICS RESEARCH LABORATORY	TRANSFORMER T1
ANN ARBOR MICHIGAN	GAULED NMS
	S/N 2
	B-E 57988 CONTROLLED
	DATE

CONTROLLED
APR 5 1965
PRINT

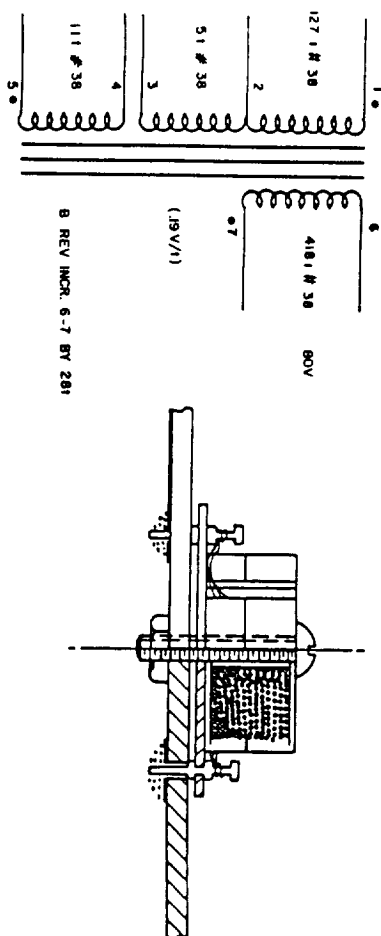

1. WIND FB 5-4.
2. WRAP SINGLE LAYER KAPTON OVER 5-4.
3. WIND SEC 7-6. DRESS ALL WIRES TO SAME SIDE OF BOBBIN. USE SLOT AS REQUIRED T2 ON T3.
4. WRAP SINGLE LAYER OF KAPTON TAPE OVER 7-6.
5. WIND 1-2-3.
6. "DIP COAT" WOUND BOBBIN IN SOLITHANE 113 PER POTTING PROCEDURE.
7. ASSEMBLE BOBBIN IN CORE. MOUNT ON TERMINAL BOARD, AND CONNECT WIRES TO TERMINAL. DRESS WIRES AS REQUIRED.
8. OPERATE TRANSFORMER IN TEST CIRCUIT.
9. SHIM CORE AS REQUIRED TO OBTAIN 35KHZ.

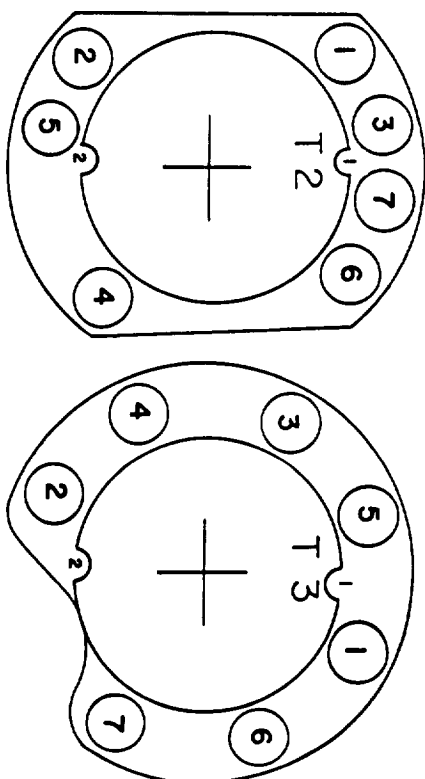


BOTTOM VIEW

- NOTES :
1. U = CORE SLOTS WHERE WIRES EXIT TRANSFORMER
 2. HAT BRIM IS 1/32 P.C. BOARD
 3. SWAGE PINS - CAMBION # 120-1032-01-01-00
 4. SWAGE TOOLS - CAMBION # 435-6462-01-00-00
AND # 435-6619-01-00-00
 5. DRILL SIZES A) # 52 IN HAT BRIM FOR SWAGING
B) # 65 IN BIAS P.C. BOARD TO ACCEPT PINS
C) # 35 IN BOTH FOR MOUNTING SCREW
 6. MOUNTING SCREW IS # 4-40 NYLON
 7. ADD BAND OF COPPER FOIL TAPE FOR MAGNETIC SHUNT AROUND CORE

ENGINEER MAURER / FRIEDMAN	DRAFTSMAN TS 5/28/81	
SPACE PHYSICS RESEARCH LABORATORY	TRANSFORMERS T2, T3	
COLLEGE OF ENGINEERING	BIAS SUPPLY	S/N 2
UNIVERSITY OF MICHIGAN	GAULIED - NMS	11/9/83
ANN ARBOR, MICHIGAN	B-E 5799B CONTROLLED	DATE



LAST USED R C D L

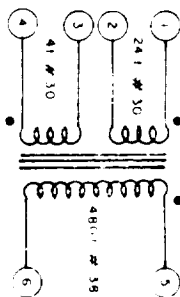


CORE
BOBBIN
MAGNETICS INC.

WINDING PROCEDURE

1. WIND SEC 5 6. START 5) AT LEFT EDGE DRESS 5) OUTSIDE OF BOBBIN FINISH 6) ON SAME SIDE SLOT. NEAR, BUT NOT AT, LEFT SIDE
2. PLACE ONE LAYER KAPTON TAPE OVER 5-6 WINDING
3. WIND 1-2 NEXT START AND FINISH ON RIGHT SIDE IN OPPOSITE SLOT FROM 5) BANK WIND ON THE RIGHT HALF OF BOBBIN WRAP ONE LAYER KAPTON TAPE OVER PRIMARY TO HOLD BANK WINDING IN PLACE
4. WIND 3-4 NEXT START AND FINISH ON LEFT SIDE LEAVING APPROXIMATELY 0.075 GAP BETWEEN THIS WINDING AND 1 2 DRESS 3 & 4 OUT SAME SLOT AS 1 & 2 MAKE SURE WINDING DIRECTION AS WELL AS ENDS, ARE PHASED CORRECTLY WRAP 3 & 4 WITH KAPTON TAPE TO HOLD IN PLACE
5. PLACE KAPTON TAPE OVER SLOT DRESS 5) OVER SLOT COVER WITH KAPTON TAPE CHECK CLEARANCE TO OTHER WIRES AND CORE
6. 6) ALSO GOES TO TOP BOARD DRESS WELL CLEAR OF 5)
7. TOP COAT BOBBIN ONLY IN SOLVANE 1/3 PER POTTING PROCEDURE
8. ASSEMBLE BOBBIN IN CORE
9. OPERATE TRANSFORMER IN TEST CIRCUIT
10. SHIM CORE HALVES AS NECESSARY TO GET APPROXIMATELY 40 KHZ (FREQUENCY WILL DECREASE WITH MULTIPLEX (MAG))
11. EPOXY HAT BRIM TO BOTTOM CORE HALF WITH EPON 828 AND TOP HAT TO TOP CORE HALF WITH SAME
12. SECURE BOBBIN TO BOTTOM CORE HALF WITH SOLVANE THICKENED WITH CARBOSIL

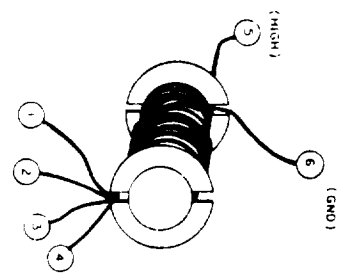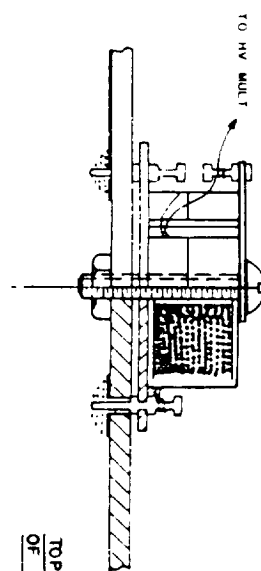

TOP VIEW OF ASSEMBLY

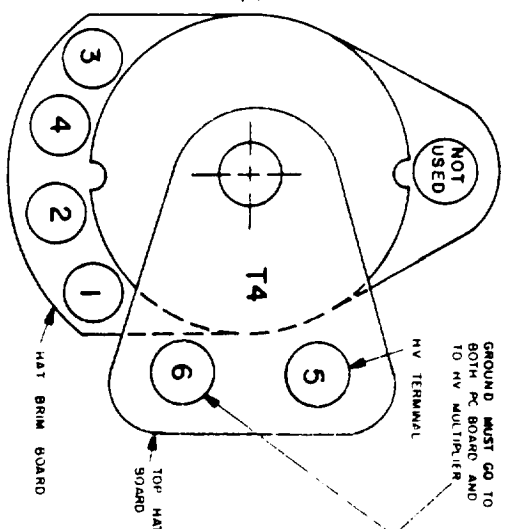



NOTES:

1. BOTH BOARDS 1/32 PC MATERIAL.
2. BOTTOM BOARD:
SWAGE PINS - CAMBION #120-01-01-01
HOLE SIZE - DRILL SIZE #52
TOOL - #435-C462-01-00-00 AND #435-B619-01-00-00
3. TOP BOARD:
SWAGE PINS - USECO #2520A
HOLE SIZE - DRILL SIZE #49
TOOL - #2520
4. DRILL #65 HOLE IN BIAS P.C. BOARD FOR PINS
5. DRILL #33 HOLE FOR MOUNTING SCREW
6. USE #4-40 -- NYLON MOUNTING SCREW

CONTROLLED

APR 22 1985
PRINT


ENGINEER	J MAURER	DRAFTSMAN	TS 2/6/81
SPACE PHYSICS RESEARCH LABORATORY		HV TRANSFORMER (T4)	
COLLEGE OF ENGINEERING		BIAS SUPPLY	
UNIVERSITY OF MICHIGAN		GMS	
ANN ARBOR, MICHIGAN		B-E 6422A CONTROLLED	
			4/16/85
			3/16/82
			5/27/81
			4/2/81
			DATE

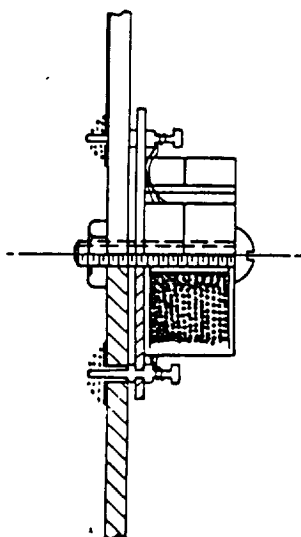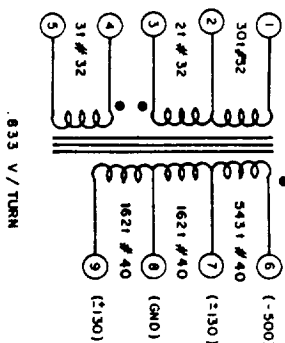

BOBBIN: MAGNETICS B-1811-01
CORE: MAGNETICS F41811-UG

WINDING PROCEDURE

1. WIND 4-5, FIRST. END 4 THRU SLOT 1. AND 5 THRU SLOT 2.
2. WRAP SINGLE LAYER OF KAPTON TAPE.
3. WIND 6-7-8-9. DRESS 6 AND 7 THRU SLOT 1. WITH 8 AND 9 THRU SLOT 2.
4. WRAP SINGLE LAYER OF KAPTON TAPE.
5. WIND 3-2-1. END 1 AND 3 THRU SLOT 2. END 2 THRU SLOT 1.
6. PLACE KAPTON TAPE OVER SLOT. DRESS 5 AND 6 OVER SLOT. COVER WITH KAPTON TAPE. 8 IS AT 500 VOLTS. IT MUST BE SEPARATED FROM OTHER LEADS. ALSO, INSURE THAT 7 AND 9 ARE SEPARATED FROM OTHER LEADS.
7. "DIP COAT" (BOBBIN ONLY) IN SOLITHANE 113 PER POTTING PROCEDURE.
8. ASSEMBLE BOBBIN IN CORE. CONNECT LEADS TO PINS PER LAYOUT.
9. OPERATE TRANSFORMER WITHOUT LOAD IN TEST CIRCUIT.
10. SHIM CORE HALVES AS NECESSARY TO GET APPROXIMATELY 35 KHZ.

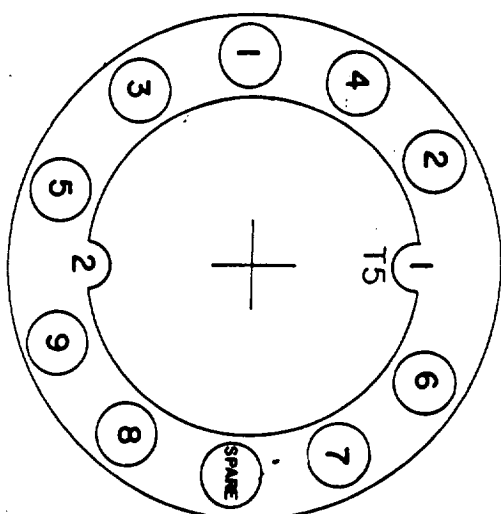


BOTTOM VIEW

NOTES:

1. SWAGE PINS - CAMBION #120-1032-01-00
2. DRILL - #52
3. SWAGE TOOL - CAMBION #435-6452-01-00-00
CAMBION #435-6619-01-00-00
4. DRILL DIAS P.C. BOARD #65 FOR PINS
5. DRILL #33 HOLE FOR #4-40 NYLON MOUNTING SCREW
6. THIS TRANSFORMER SIMILAR TO WATS TI PG 11-6
7. ADD BAND OF COPPER FOIL TAPE FOR MAGNETIC SHUNT AROUND CORE

ENGINEER J. WALKER	DRAFTSMAN TS 2/6/81
SPACE PHYSICS RESEARCH LABORATORY	TRANSFORMER TS
COLLEGE OF ENGINEERING	BIAS SUPPLY
UNIVERSITY OF MICHIGAN	GNMS
ANN ARBOR, MICHIGAN	B-E 642IC CONTROLLED
	DATE

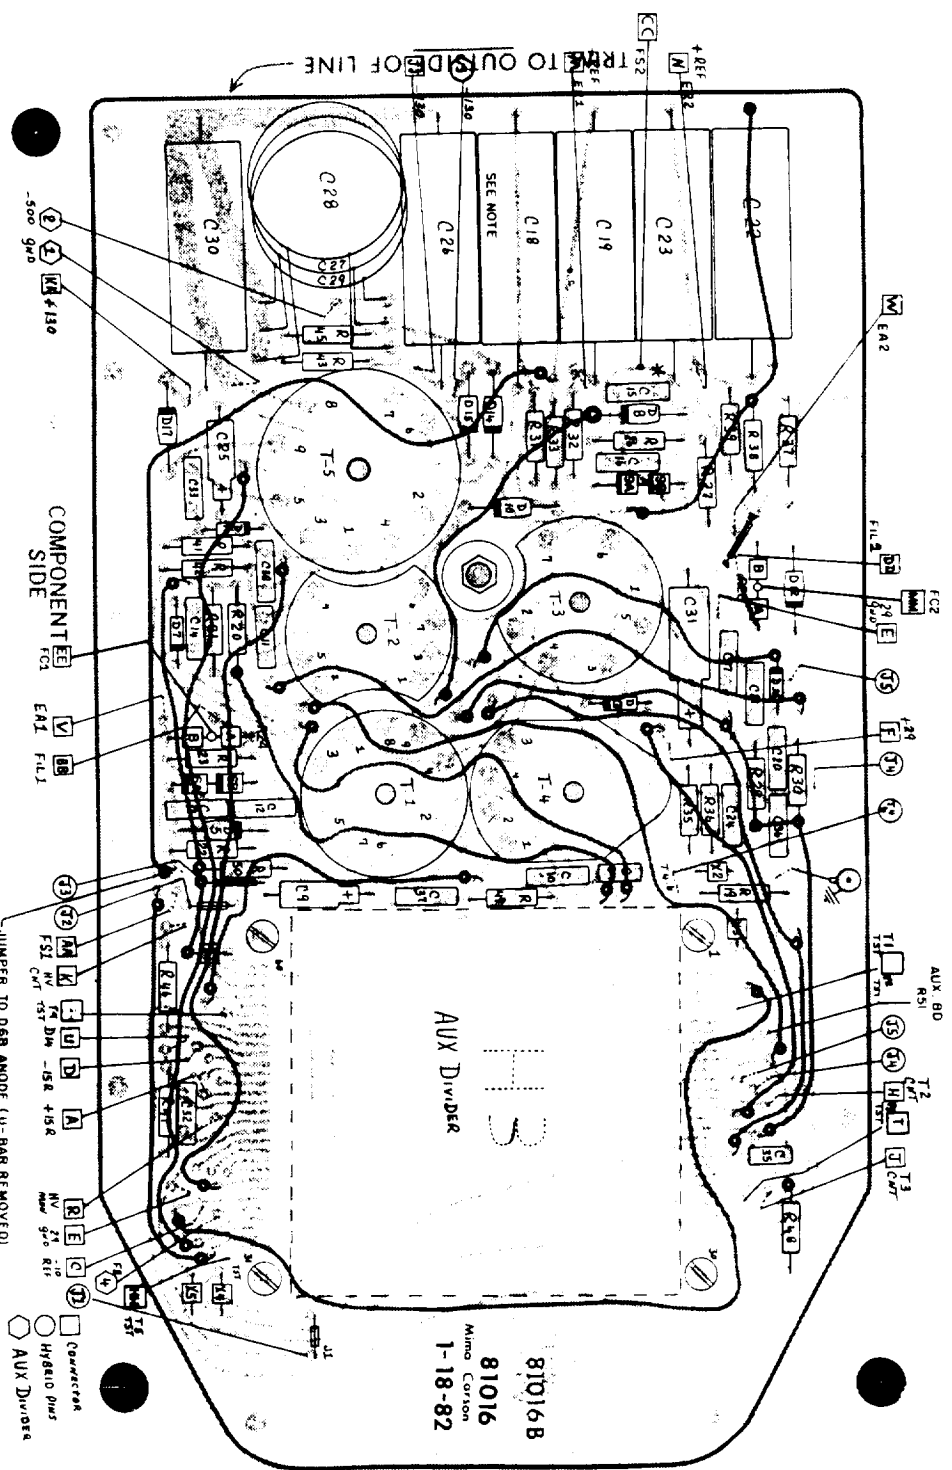

ENGINEER MAURER

SPACE PHYSICS RESEARCH LABORATORY

COLLEGE OF ENGINEERING

UNIVERSITY OF MICHIGAN

ANN ARBOR, MICHIGAN

DRAFTSMAN N.D.

COMPONENT LAYOUT

BIAS SUPPLY

GMS


B-E6777 CONTROLLED

DATE

APR 23 1985 138

CONTROLLED


PRINT

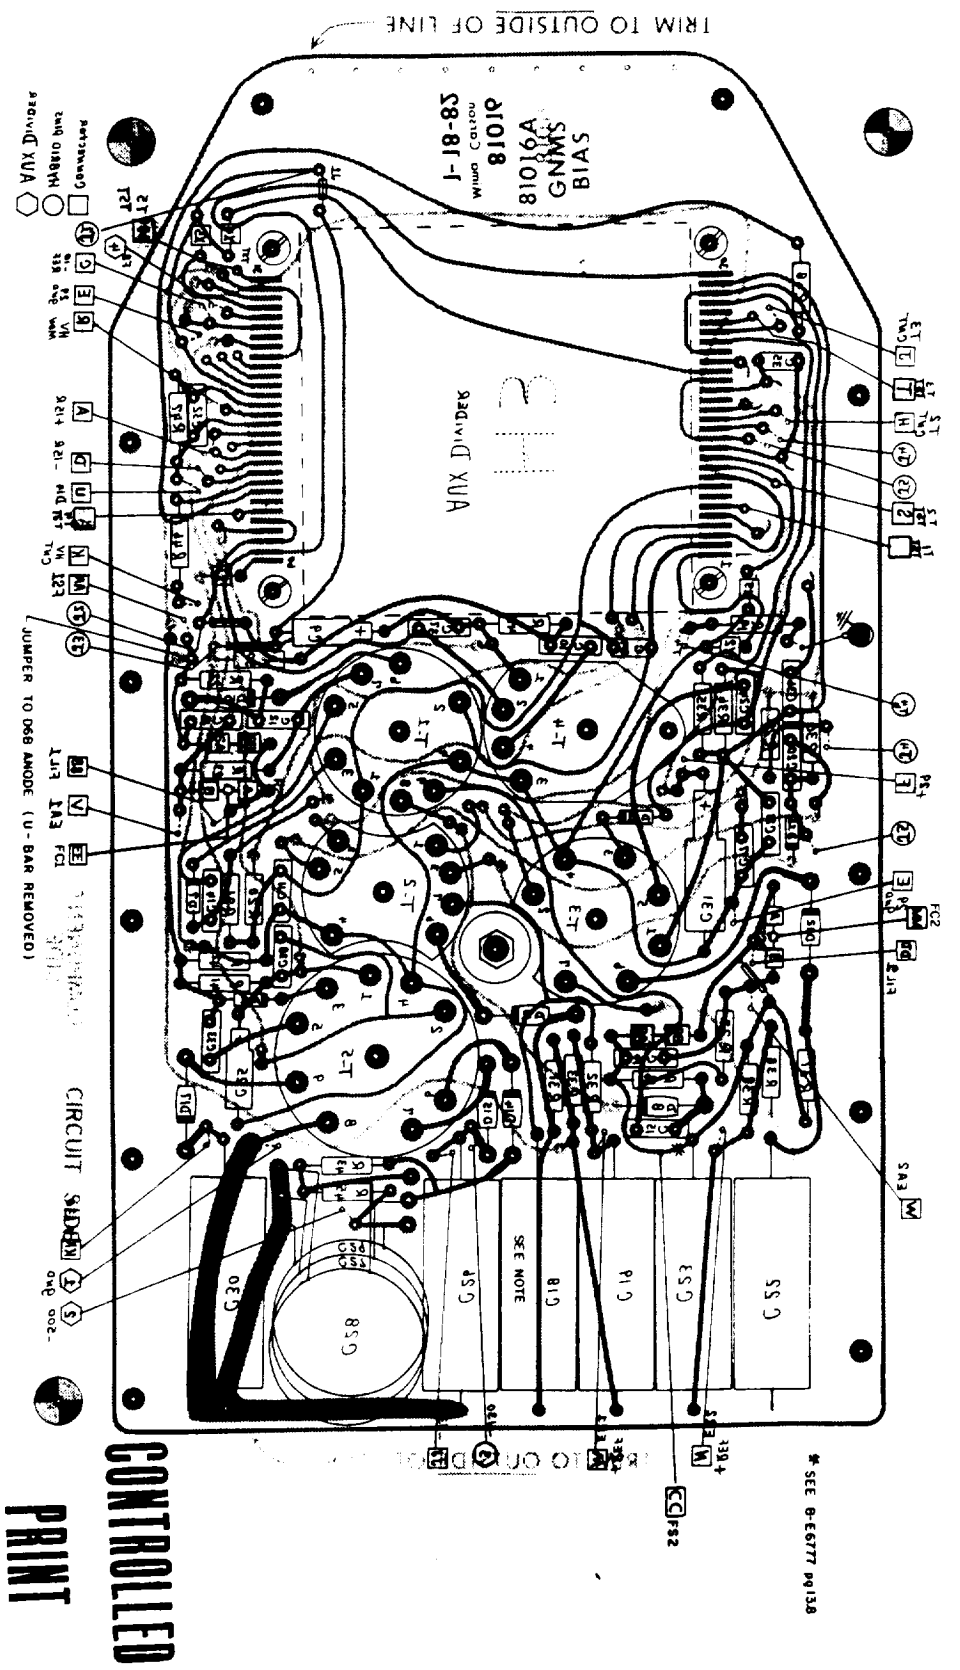

NOTE: NOT SHOWN ARE C7/R54 ON TERMINALS NEAR C18 CONNECTED PER PG.13.2,
 07X ON TERMINALS NEAR C18 CONNECTED PER PG.13.1

ENGINEER	MAURER	DRAFTSMAN	N.O.
SPACE PHYSICS RESEARCH LABORATORY	COMPONENT LAYOUT REVERSE		
COLLEGE OF ENGINEERING	BIAS SUPPLY		
UNIVERSITY OF MICHIGAN	S/N2		
ANN ARBOR, MICHIGAN	B-E6778 CONTROLLED		
	DATE		
	APR 23 1985		13.9

COMPONENT SIDE

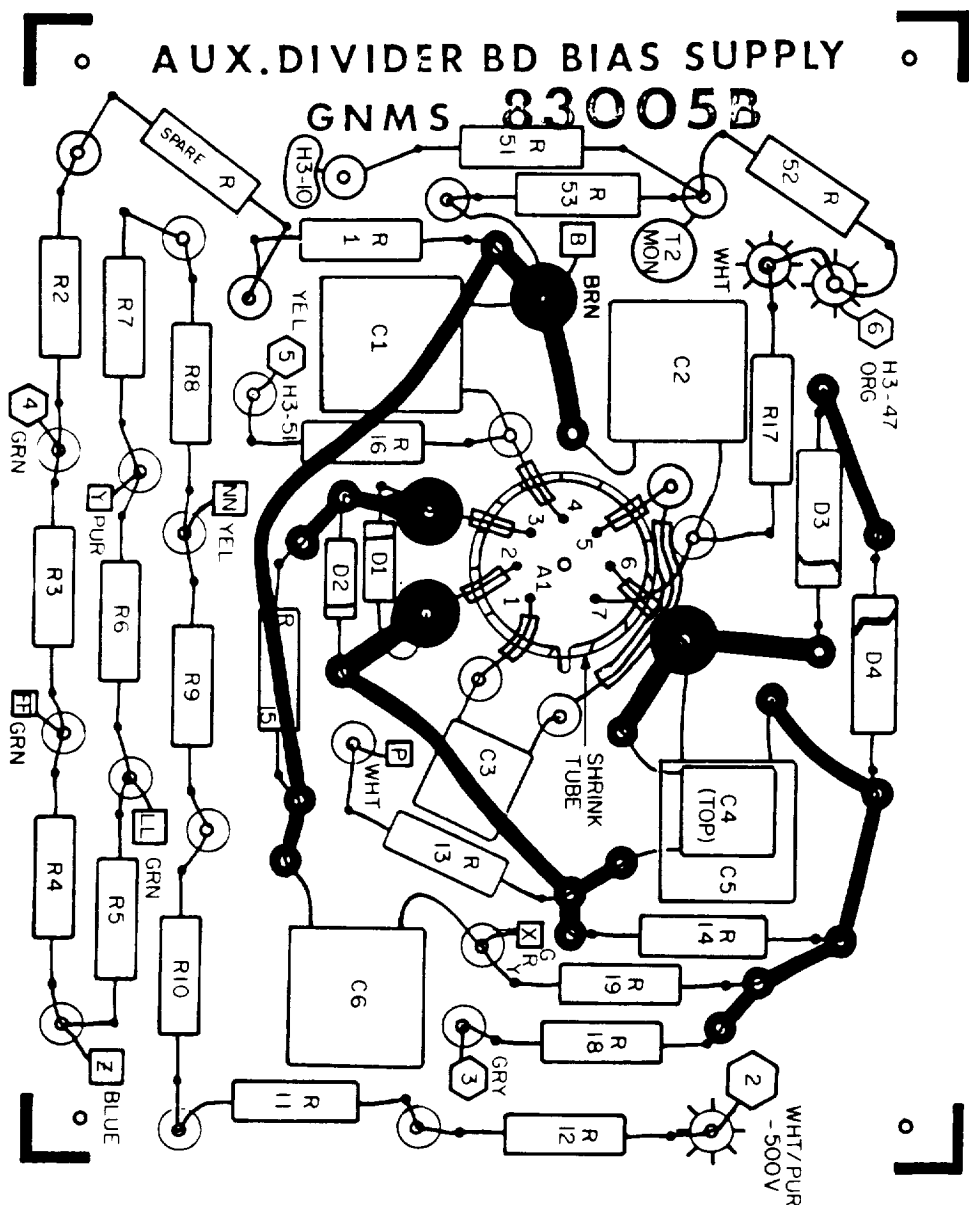

- NOTES
- 1 PC BOARD 1/32 THICK
 - 2 #2 MOUNTING SCREWS ATTACH TO MAIN BOARD. EPOXY DOWN AT LAST OPPORTUNITY.
 - 3 (O) 2520A-4 TERMINALS. DRILL #49 SWAGES TO BE ON A SIDE OF BOARD. CUT TOP TURNET OFF, 3 PLS.
 - 4 CONNECTION TO MAIN BOARD.
 - 5 WIRE TO CONNECTOR.
 - 6 A1 MOUNTS UPSIDE DOWN WITH SHRINK TUBE INSULATION ON TOP CASE. SOLDER ALL LEADS ON TOP TURNET OF SWAGE TERMINALS.
 - 7 SEE LOGBOOK FOR OTHER ASSEMBLY NOTES.
 - 8 CHECK FOR FIT AGAINST HARNESS EARLY AND OFTEN!


CONTROLLED
AUG 16 1983
PRINT

ENGINEER B. BLUCK/MAH	
SPACE PHYSICS RESEARCH LABORATORY	
COLLEGE OF ENGINEERING	
UNIVERSITY OF MICHIGAN	
ANN ARBOR MICHIGAN	
DATESMAN J.E.M.	
COMPONENT LAYOUT	
AUXILIARY DIVIDER BOARD	
GNMS	
B-E7116 CONTROLLED	
S/N2	
DATE	

TOP VIEW OF CORE ASSEMBLY


* SHIM MATERIAL AND
SHIM THICKNESS AS SPECIFIED
BY TEST ENGINEER

NOTE: THIS DESIGN INITIALLY USED
7/81 IN GNM'S BIAS SUPPLY T# 1 -
I#5 TO ADJUST FREQUENCY.

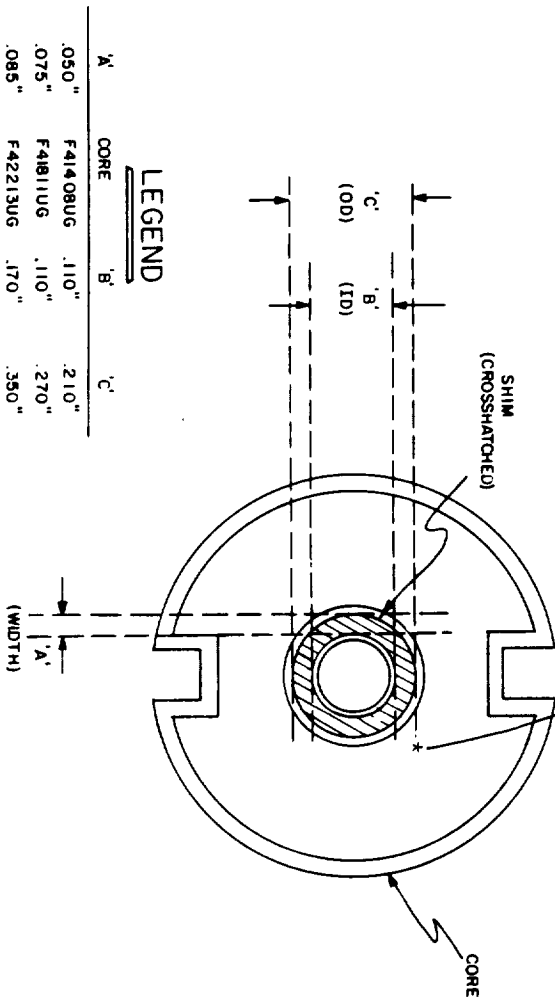

DESIGNATION T #	CORE USED	SHIM THICKNESS
1	1408	.004
2	1408	.004
3	1408	.004
4	1811	.004
5	1811	.003

ENGINEER J BROOKS	DRAFTSMAN MN	8/83/81
SPACE PHYSICS RESEARCH LABORATORY	TRANSFORMER, BIAS	
COLLEGE OF ENGINEERING	SHIM DESIGN	
UNIVERSITY OF MICHIGAN	GNMS	
ANN ARBOR, MICHIGAN	B-E6665	
		DATE

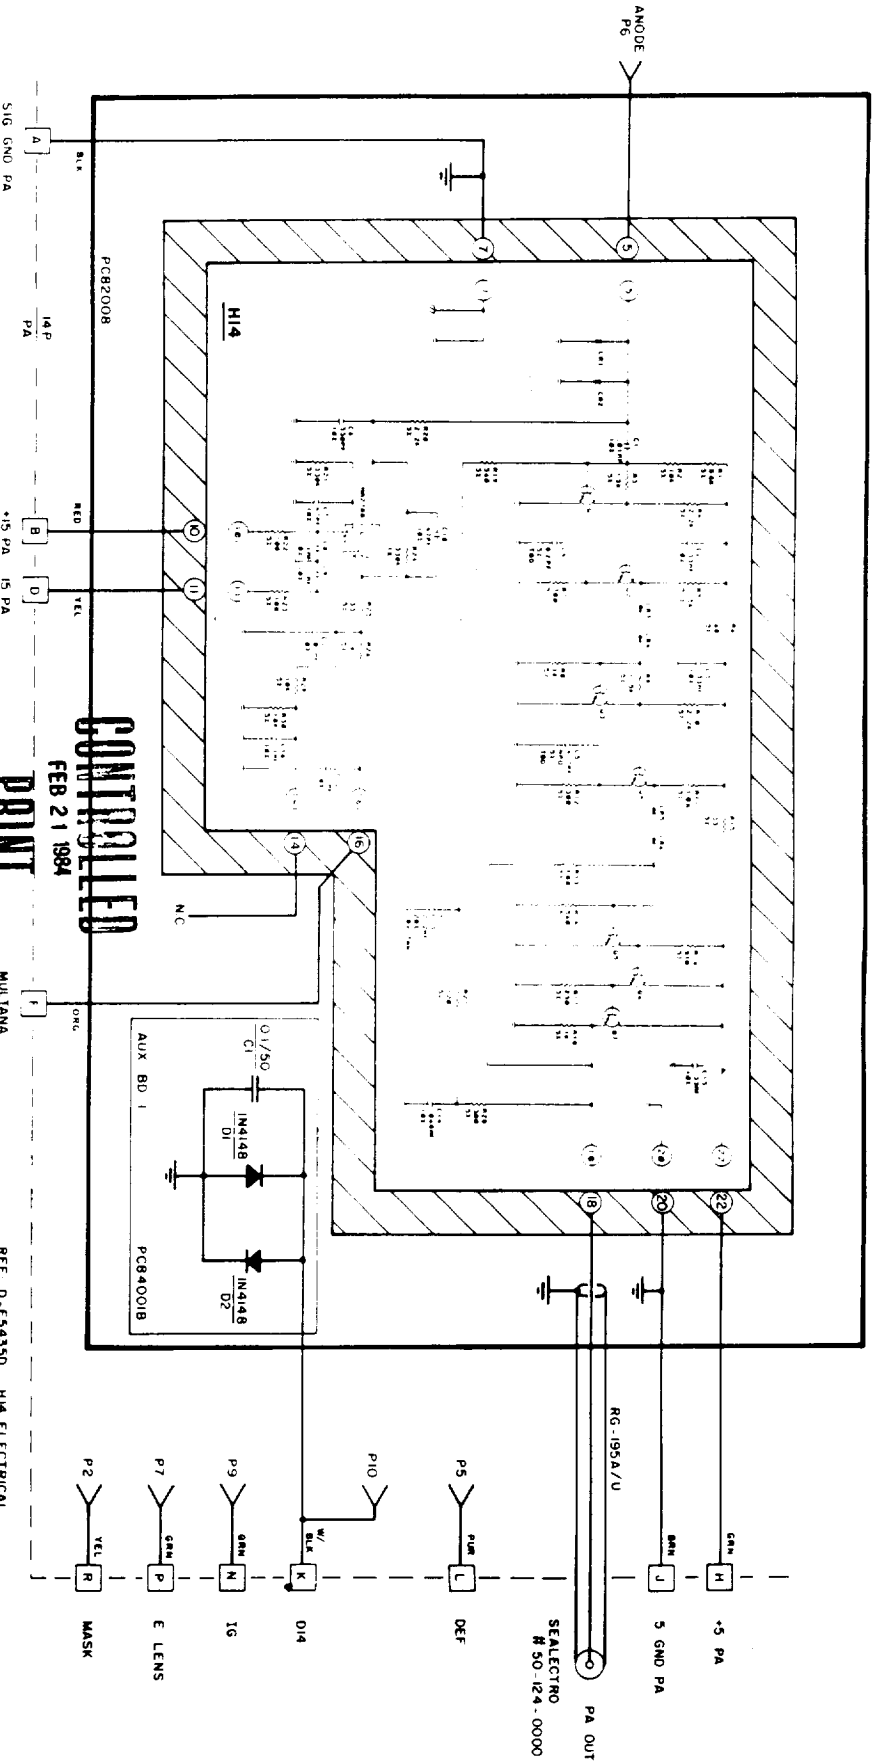


NOTES
1. DENOTES MULTI HEADER CONNECTION.
2. C1, D1, D2 BONDED TO UNDERSIDE OF PC BOARD.

CONTROLLED
FEB 21 1984
PRINT

ENGINEER: B. BLOCK	DRAFTSMAN: EL
SPACE PHYSICS RESEARCH LABORATORY	ELECTRICAL DWG.
COLLEGE OF ENGINEERING	PULSE AMPLIFIER
UNIVERSITY OF MICHIGAN	GNMS
ANN ARBOR, MICHIGAN	B-E7235CONTROLLED
	S/N 3
	DATE

LAST USED R C1 D2 L

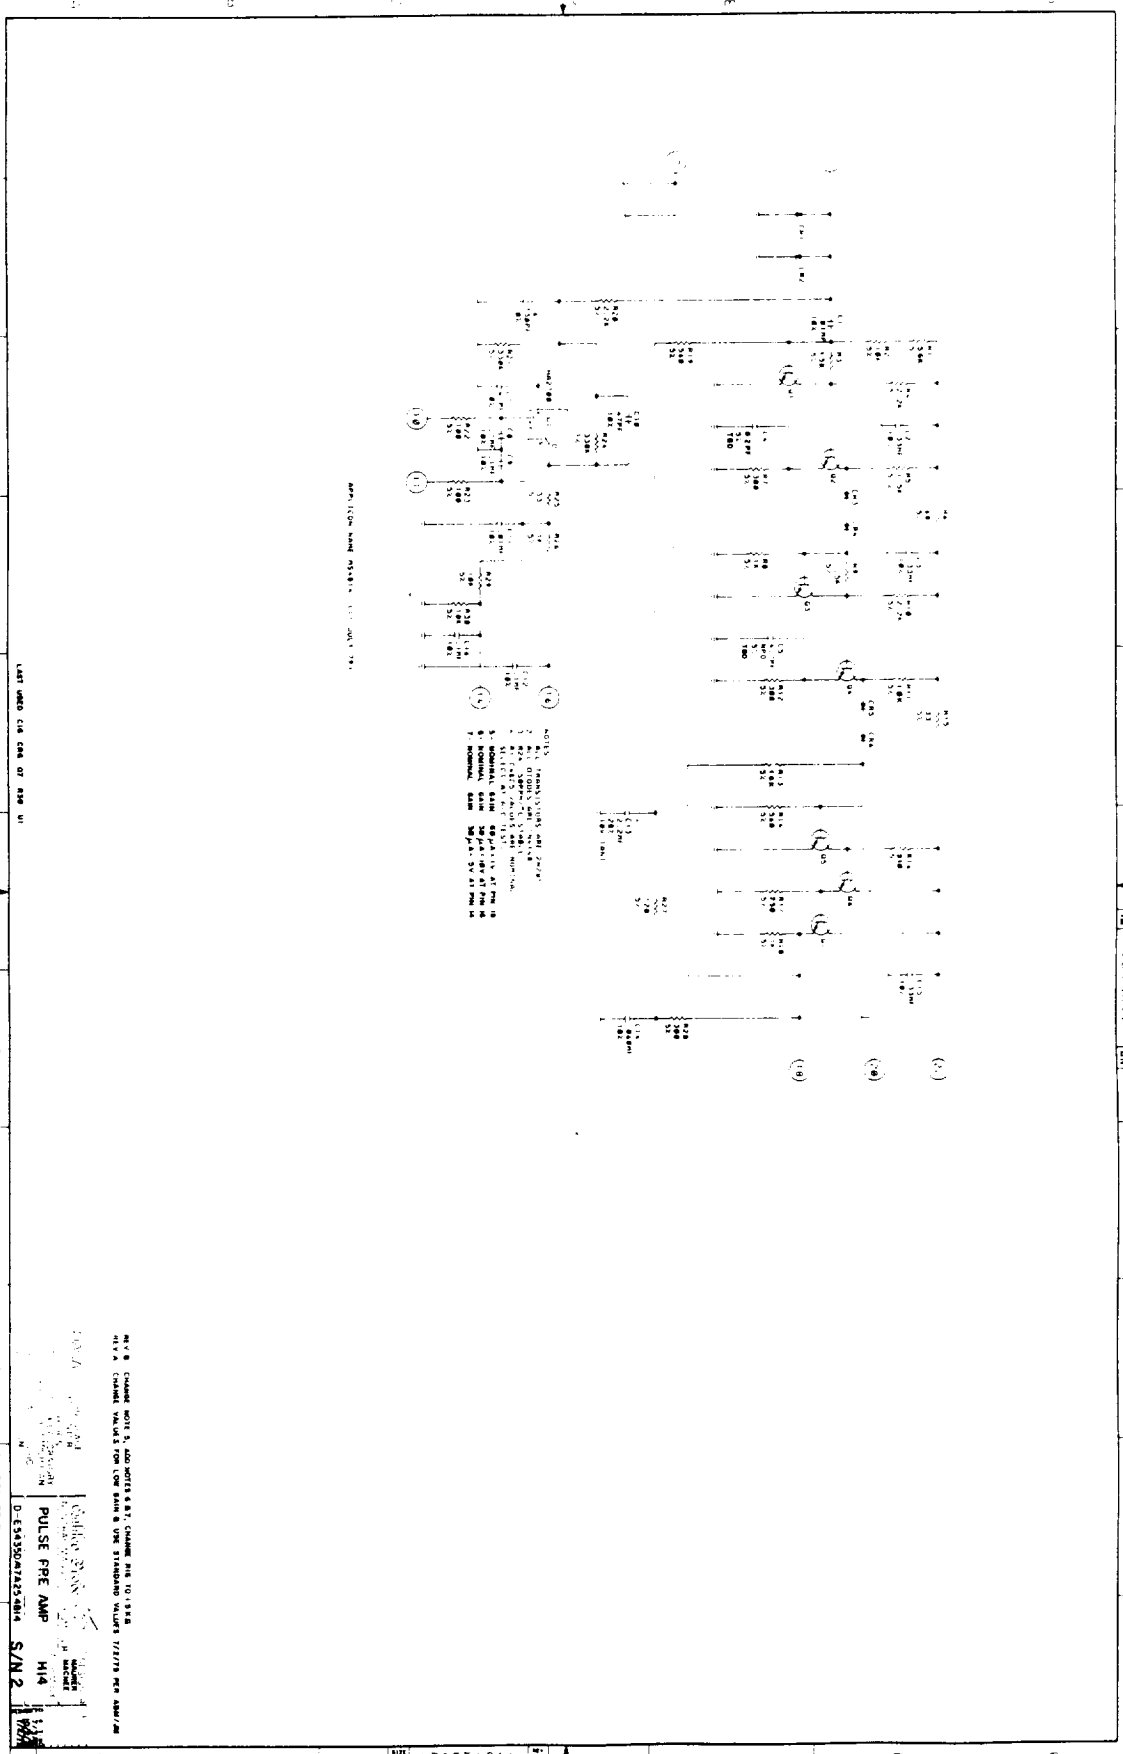




CONTROLLED

PULSE PRE AMP

M14

S/N 2


1000

SEP 9 1982 15.18

47A254814

COMPONENT SIDE

- NOTES: 1. H14 - CUT OFF PINS 4,6,15,23.
2. INSTALL U-BARS ON A-SIDE.
3. GROUNDS OPTIONAL.

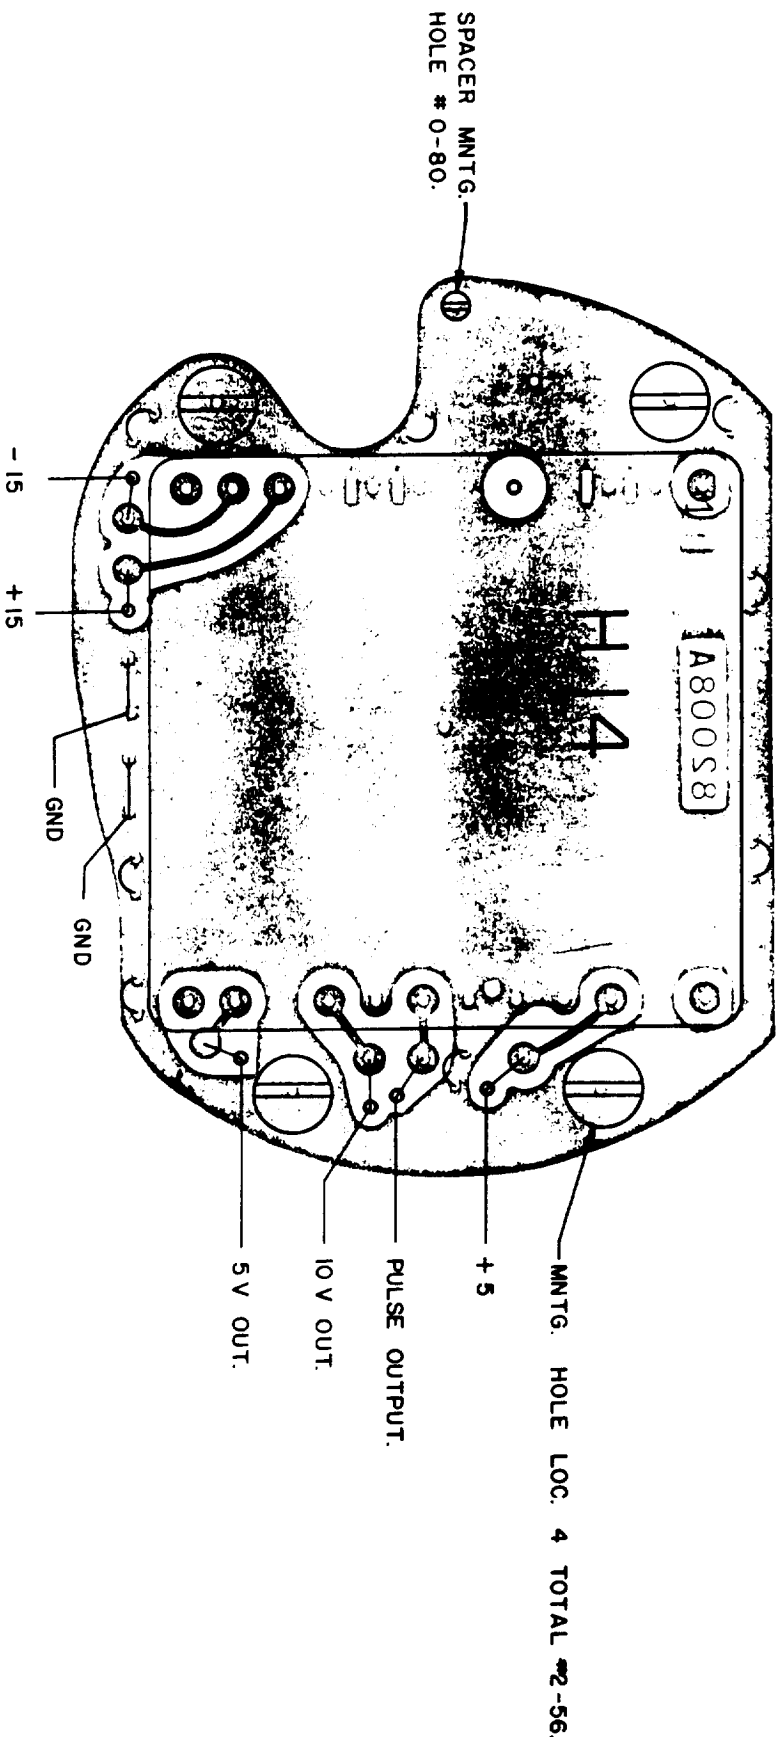

ENGINEER B. BLOCK - M.A.H.	DRAFTSMAN G. WIGGINS - M.A.H.	
SPACE PHYSICS RESEARCH LABORATORY	COMPONENT LAYOUT	
COLLEGE OF ENGINEERING	PULSE AMPLIFIER 80 # 82008A	
UNIVERSITY OF MICHIGAN	GNMS	
ANN ARBOR, MICHIGAN	B-E 6921	DATE

LAST USED R C D L

GPMS FLIGHT HYBRID REVISION STATUS

TITLE	DMC #	CURRENT REV. LETTER	REV. DATE
H1 - Main Power Hybrid -	D-E5441	I	8/2/82
H2 - Fil Supply -	D-E5433	D	5/15/82
H3 - Bias Supplies -	D-E5437	C	9/25/79
H4 - (A/B) - Pyro Drive -	D-E5440	F	11/6/80
H17 - Valve Drive A -	D-E5431	F	3/10/83
H5 - Valve Drive B - (single ended)	D-E6504	A	3/10/83
H6 - Heater Drive -	D-E5436	H	7/14/82
H7 - Timer -	D-E5349	N	12/16/81
H8 - Anamux -	D-E5438	F	10/19/82
H9 - Command Hybrid -	D-E5442	K	6/11/82
H10 - (A/B) - Program Memory -	D-E5444	F	10/31/80
H11 - Calculator -	D-E5443,5445	F	5/14/81
H12 - Rod Control -	D-E5432,5434	E	1/20/82
H13 - Format Data Buffer -	D-E6125, 6155	J	11/22/83
H14 - Pulse Pre Amp -	D-E5435	D	8/1/80
H15 - Core Memory -	D-E6124	H	9/12/84
H16 - PROM -	D-E6126	A	1/23/81


DATE	HYBRID	LETTER	CHANGE DESCRIPTION	FILE: (44) (44) 1.51
07-02-79	H14	A	CHANGE VALUES FOR LOG GAIN (NO ECU)	DISK: DMS-2
07-18-79	H12	A	DRAWING ERRORS (NO ECU)	BY: J. MAUSER/B. P. ELLER, JR.
07-23-79	H5	A	CHANGE R58, R63, R101, R111	REV: 10/17/80 SCG
07-31-79	H6	A	DELETE THE BETWEEN PIN 56 AND 57	
08-06-79	H7	A	ADD PINS 30 & 31, CHANGE CONNECTIONS ON V22 & V23	
08-20-79	H4	A	CHANGED ALL INTERNAL VALUES (NO ECU)	
08-27-79	H1	A	ADD C41, R681 CHANGE R45 CHANGE Q19 AND	
08-30-79	H8	A	ADD CHIP, CHANGE PIN NO'S	
09-04-79	H5	B	CHANGE PIN NO'S PER DE SPEC.	
09-07-79	H3	A	ADD R44, R55, R66, R71, R86	
09-14-79	H3	A	CHANGE PIN NO'S PER DE SPEC. RED LINE POWER WIRING	
09-18-79	H9	A	MODIFY TURN ON RESET	
09-18-79	H11	A	ADD LOGIC TO GENERATE "FRESH"	
09-25-79	H2	A	CHANGE POWER WIRING TO U3	
09-25-79	H3	C	CHANGE U37, U38 INTERMEDIATE ACCORDING TO MOTOROLA SPEC	
10-02-79	H7	B	CHANGE VALUE OF R16, ADD NOTES	
10-15-79	H4	B	ADD R2, R4, R6, R81 CHANGE PINS ON U2	
11-05-79	H7	C	ADD 6, 44 NOTATION	
11-06-79	H6	C	CHANGE PIN NO'S AND IC NUMBERING PER DE SPEC	
11-06-79	H6	C	CHANGE PIN NO'S, IC NUMBERING AND "P" DESIGNATION PER DE SPEC	
11-08-79	H12	B	REVISE VALUES FOR C3, C5, C17, AND PIN 35	
11-15-79	H7	D	ADD INVERTER, CHANGE INTERNAL WIRING FOR A/B SPLIT	
11-19-79	H10	A	CHANGE "P" DESIGNATIONS FOR R2, R7, R9, R10	
12-02-79	H6	C	CHANGE ANALOG COMPARTMENT CIRCUIT - NEW DESIGN	
01-02-80	H10	B	MOVE PORTION OF H10 TO H13	
02-04-80	H10	B	ADD R49 (TBD), REMOVE WIRE ON BRIDGE	
02-13-80	H1	D	CHANGE PIN NO'S ON V11, V12, V20	
02-25-80	H6	B	MOVE PORTION OF H9 TO H13	
02-28-80	H9	C	MOVE CORE RESISTOR TO H15	
03-14-80	H7	E	ADD RESISTORS & CHANGE SIGNAL NAMES	
04-04-80	H7	D	CHANGE SIGNAL NAMES	
04-15-80	H4	E	CHANGE SIGNAL NAMES	
04-15-80	H6	E	CHANGE SIGNAL NAMES	
04-16-80	H1	F	CHANGE R49 FROM TBD TO 10K	
04-18-80	H7	F	DRAWING ERROR (LIMITED "H18")	
04-18-80	H15	A	DRAWING ERROR (LIMITED COMP. ID NO'S)	
04-21-80	H9	D	CHANGE INVERTS TO 4011, CHANGE P/S INVERTS	
04-28-80	H8	C	ADD BUFFERING, CORRECT ANALOG GAINS	
04-28-80	H10	C	CHANGE SELECTION OF A/B TO EXTERNAL	
04-29-80	H7	G	USE 4001 AS INVERTER	
05-05-80	H11	B	MOVE PORTION TO H13 & H14; REMOVE	
05-09-80	H7	H	USE SPARE INVERTER	
06-02-80	H1	D	CHANGE PIN NO'S PER DE LAYOUT	
06-02-80	H10	D	CHANGE PIN NO'S PER DE LAYOUT	
06-10-80	H13	A	ADD FILTER CAPS, CLEAN UP DRAWING	
07-01-80	H15	B	ADD C900, C911, R28, R29	
07-03-80	H14	C	CHANGE R1, R3, R11, R13, R16, R17, C4	
07-08-80	H11	C	DRAWING ERROR CLEAN UP	
07-29-80	H4	E	CORRECTION OF U7 AND U13	
08-01-80	H14	D	CHANGE R1 FROM 8.2K TO 5.1K	
08-04-80	H7	I	CHANGE U42 TO 4029 FROM 4024	
08-06-80	H7	J	CHANGE D11, D2, D3, D4 CONNECTIONS OF U42 FROM 110 TO GND	
08-12-80	H1	J	CHANGE B18C, TO C023; CHANGE C022 & C024 TO IN753A	
08-12-80	H2	B	CHANGE C024 FROM IN611B TO IN753A	

09-04-80	H13	B	CHANGE PIN 8'S, ADD OUTPUT
09-08-80	H10	E	CHANGE POWER SUPPLY PIN 8'S
09-08-80	H11	D	CHANGE WIRE PIN 110 OF U24;
09-08-80	H15	C	CHG R24 TO OPEN; CORRECT DRAWING ERROR 2-4279'S
09-24-80	H1	F	CHG C12 FROM .047/50 TO .1/50; REPLACE C11 WITH R70
10-17-80	H13	C	DELETE C15, C6, C7; CHANGE C3, C4, C10, C11, C12, C13, C14, C15
10-23-80	H15	D	ADD R30, R31, R32, R33; DELETE C023, C028, R24; HYBRID DESIGN CHG
11-06-80	H4	F	CHANGE PRIORITY OF C1 DUE TO DRAWING ERROR
11-06-80	H6	F	LABELS CHANGED ON U16, U17; PIN 31, 32, 33
11-30-80	H10	F	ADD POWER BUS, ELIMINATE JUMPS
11-30-80	H9	D	CHANGE LOCATION OF R38; CHANGE R47 TO 120K
11-30-80	H9	F	CHANGE LABELS AND REWORK CIRCUITRY
11-30-80	H13	D	INTERCHANGE LABELS PINS 63, 64, 65, 66
11-10-80	H7	K	MAJOR REWORK, SEE D04
11-14-80	H11	E	ADD INFORMATION TO DRAWING
11-13-80	H2	C	CHANGE BONDING TO PINS ON U20, U23, U24, U25, U27
01-16-81	H6	G	REVERSE PIN 8'S
01-23-81	H16	A	ADD INVERTER, C16; CORRECT LABELLING; CHANGE I/O PIN 3'S
05-14-81	H13	E	ADD P2502 OUTPUT, CHANGE I/O PIN 8'S
05-14-81	H11	F	CHANGE PIN 57, 32, 8 INPUT U24; CHANGE I/O PIN 8'S
05-14-81	H9	G	DELETE C15, C16; CORRECT LABELLING; CHANGE I/O PIN 8'S
05-14-81	H8	E	DELETE C15, C16; CORRECT LABELLING; CHANGE I/O PIN 8'S
04-01-81	H7	L	CHANGE I/O PIN 8'S AND LOGIC ELEMENT PIN 8'S
05-14-81	H12	C	REVERSE SENSE AND OUTPUT, C1-C120 "OPEN" CHANGE I/O PIN 8'S
04-28-81	H15	E	CHANGE C7, R18
06-11-81	H12	B	DELETE SEVERAL PARTS FOR HSB ONLY, SEE D04 NOTE 2
06-11-81	H12	B	DELETE SEVERAL PARTS FOR HSB ONLY, SEE D04 NOTE 2
08-24-81	H5	C	CONNECT RESET OF U23 TO TRONKE UNTESTED OF LOG GND
09-08-81	H9	H	MODIFY SPARE DRIVER SIMILAR TO REV C
09-08-81	H5	D	CHANGE OUTPUT PIN 8'S OF 4013'S (U3, U40, U48)
11-06-81	H7	H	CONNECT U2-2 TO PIN 171 AND R71, DELETE R271 CHANGE C6, R22, 46, 49, 50, 62-65
12-11-81	H1	G	CONNECT "P" INPUT OF U27 TO S90, NOT S87
12-16-81	H7	N	CHANGE R32, R34; GATE THROU INTO SE078; REMOVE U23-1-21 CONNECT U24-5 TO U20-12
12-16-81	H9	F	CHANGE LABELS ON U23 & U23, R10, R42-46, R52, R53, R1, R21 CONNECT PINS 40 & 48
12-16-81	H13	F	MOVE PIN 60 TO U-22 PIN 15-4
01-20-82	H12	E	CHANGE R 23 TO 22K, C1-C20 TO 470PF
03-23-82	H15	F	CHANGE U40-1, U42-13 CONNECTION FROM GROUND TO +1003 NODE
04-07-82	H13	G	FILED NAME CHANGE ONLY
05-15-82	H2	B	CORRECT WIRING: U1-11 TO U2-13 AND U1-14 TO U2-12
06-02-82	H9	J	CHANGE U42-11 TO CHECK, USE SPARE U23 GATE FOR OTHERS AND
06-11-82	H9	K	VALUE CONNECTIONS TO LAST D04 12-11-81 REV G (C4, R43, 47, 62-65)
07-08-82	H1	H	REPLY ALL DRIVERS REMOVE TWO DIODES & RESISTORS AND REWIRE
07-14-82	H5A	E	REWIRE ALL DRIVERS REMOVE TWO DIODES & RESISTORS AND REWIRE
07-14-82	H5B	-	MODIFY BOTH DRIVERS (SAME AS H5A)
07-14-82	H6	H	CHANGE R70 TO OPEN, R25 TO SHORT, AND C11 (C027) ADDRESS R70
08-02-82	H1	I	ADD R100 & R101 IN SERIES WITH U22-12,13 & U22-1,2
10-19-82	H8	F	CHANGE ALL INTERMEDIATE FROM H5A TO H17
03-10-83	H5A(H17)	F	UPDATE NOTES
03-10-83	H5B	A	CHANGE R69,70,71,77,81,83
03-25-83	H13	H	CHANGE CONNECTIONS ON U40 AND U42 TO CORRESPOND WITH E5'S
10-12-83	H13	I	ADD MISSING PIN 2 OF U44 CONNECTED TO LOGIC GND
11-23-83	H13	J	ADD C946 AND JUMPER J1
7-23-84	H15	G	CHANGE U1 TO HA2510
9-12-84	H15	H	

ENGINEER	J. MAUSER / B. ELLER, JR.	DRAFTSMAN	J. B.
SPACE PHYSICS RESEARCH LABORATORY		HYBRID DRAWING INDEX	
COLLEGE OF ENGINEERING		GMS	
UNIVERSITY OF MICHIGAN		B-E5552	
ANN ARBOR, MICHIGAN			
DATE			

LAST USED R C D L


11 10 9 8 7 6 5 4 3 2 1 15.3

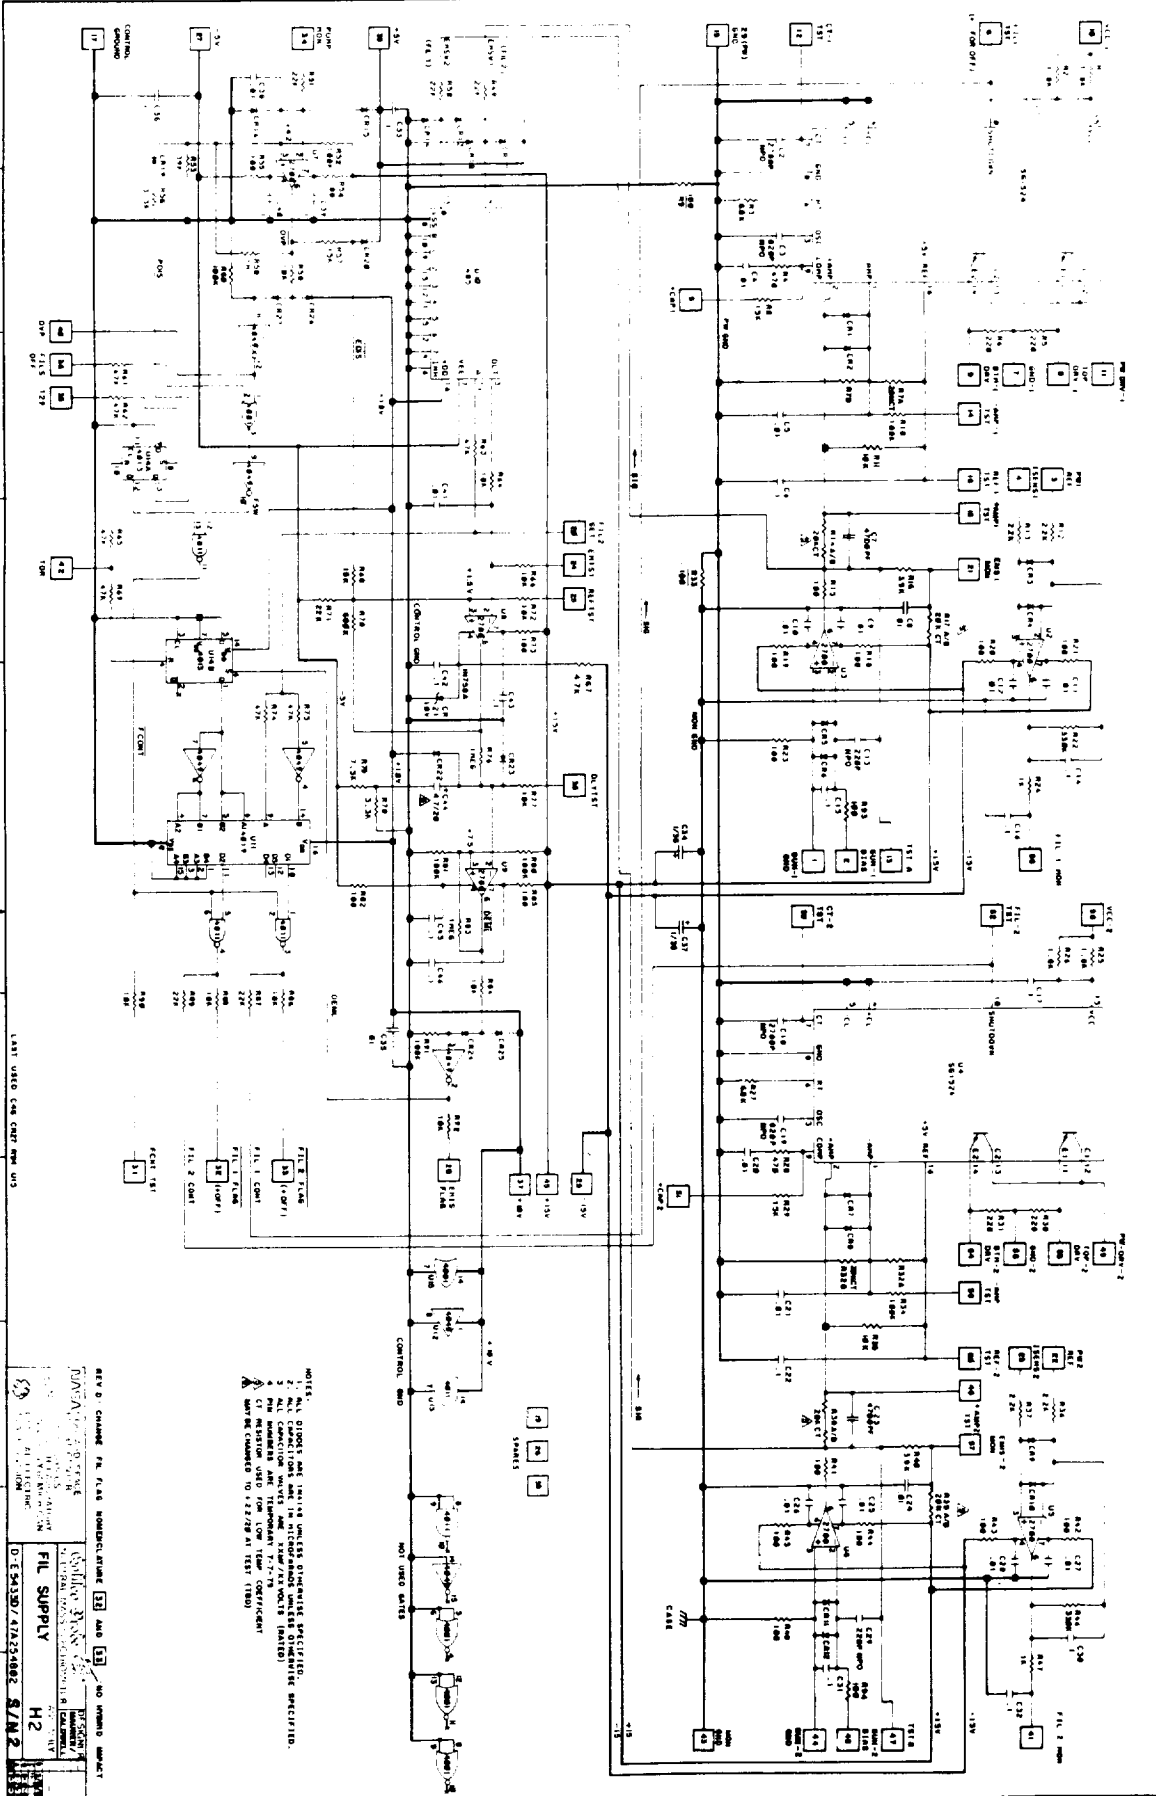


NOTES:

FIL SUPPLY H2
D-154320/47A254802 S/N 2
CONTROL 2

47A254802

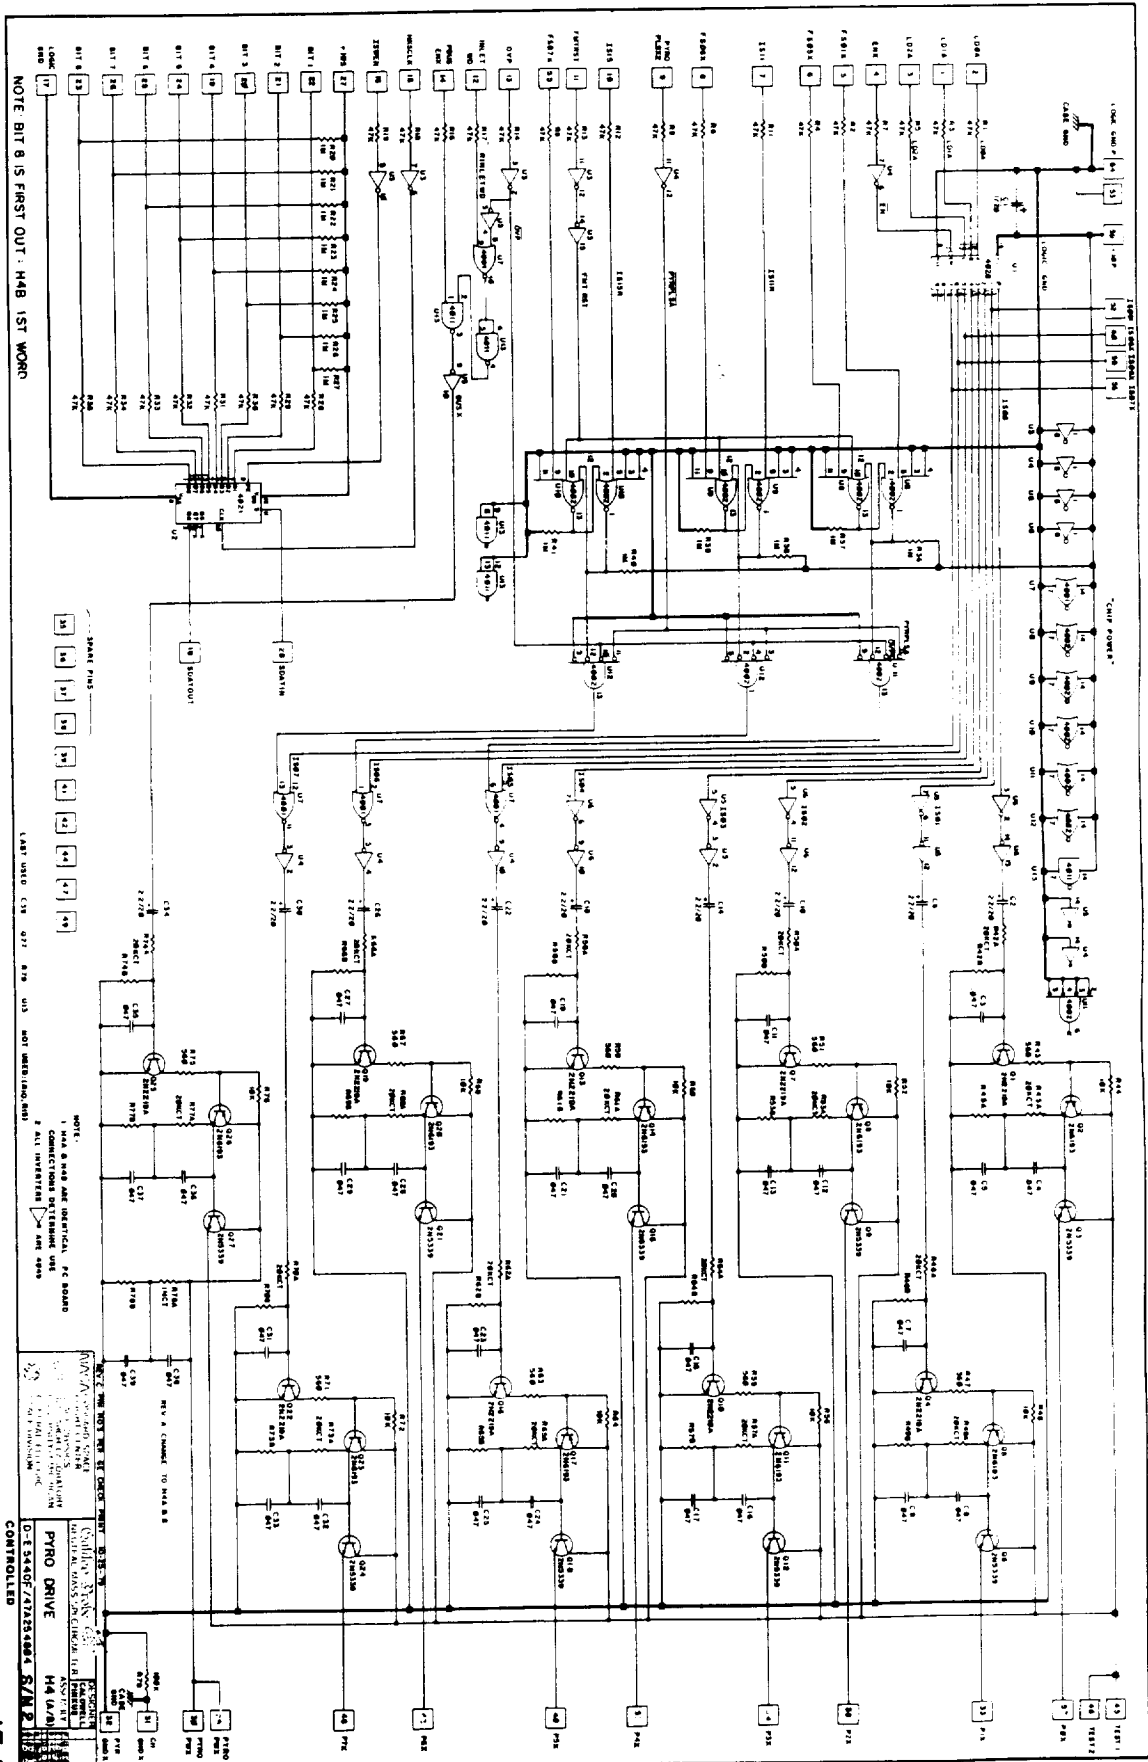


11 10 9 8 7 6 5 4 3 2 1

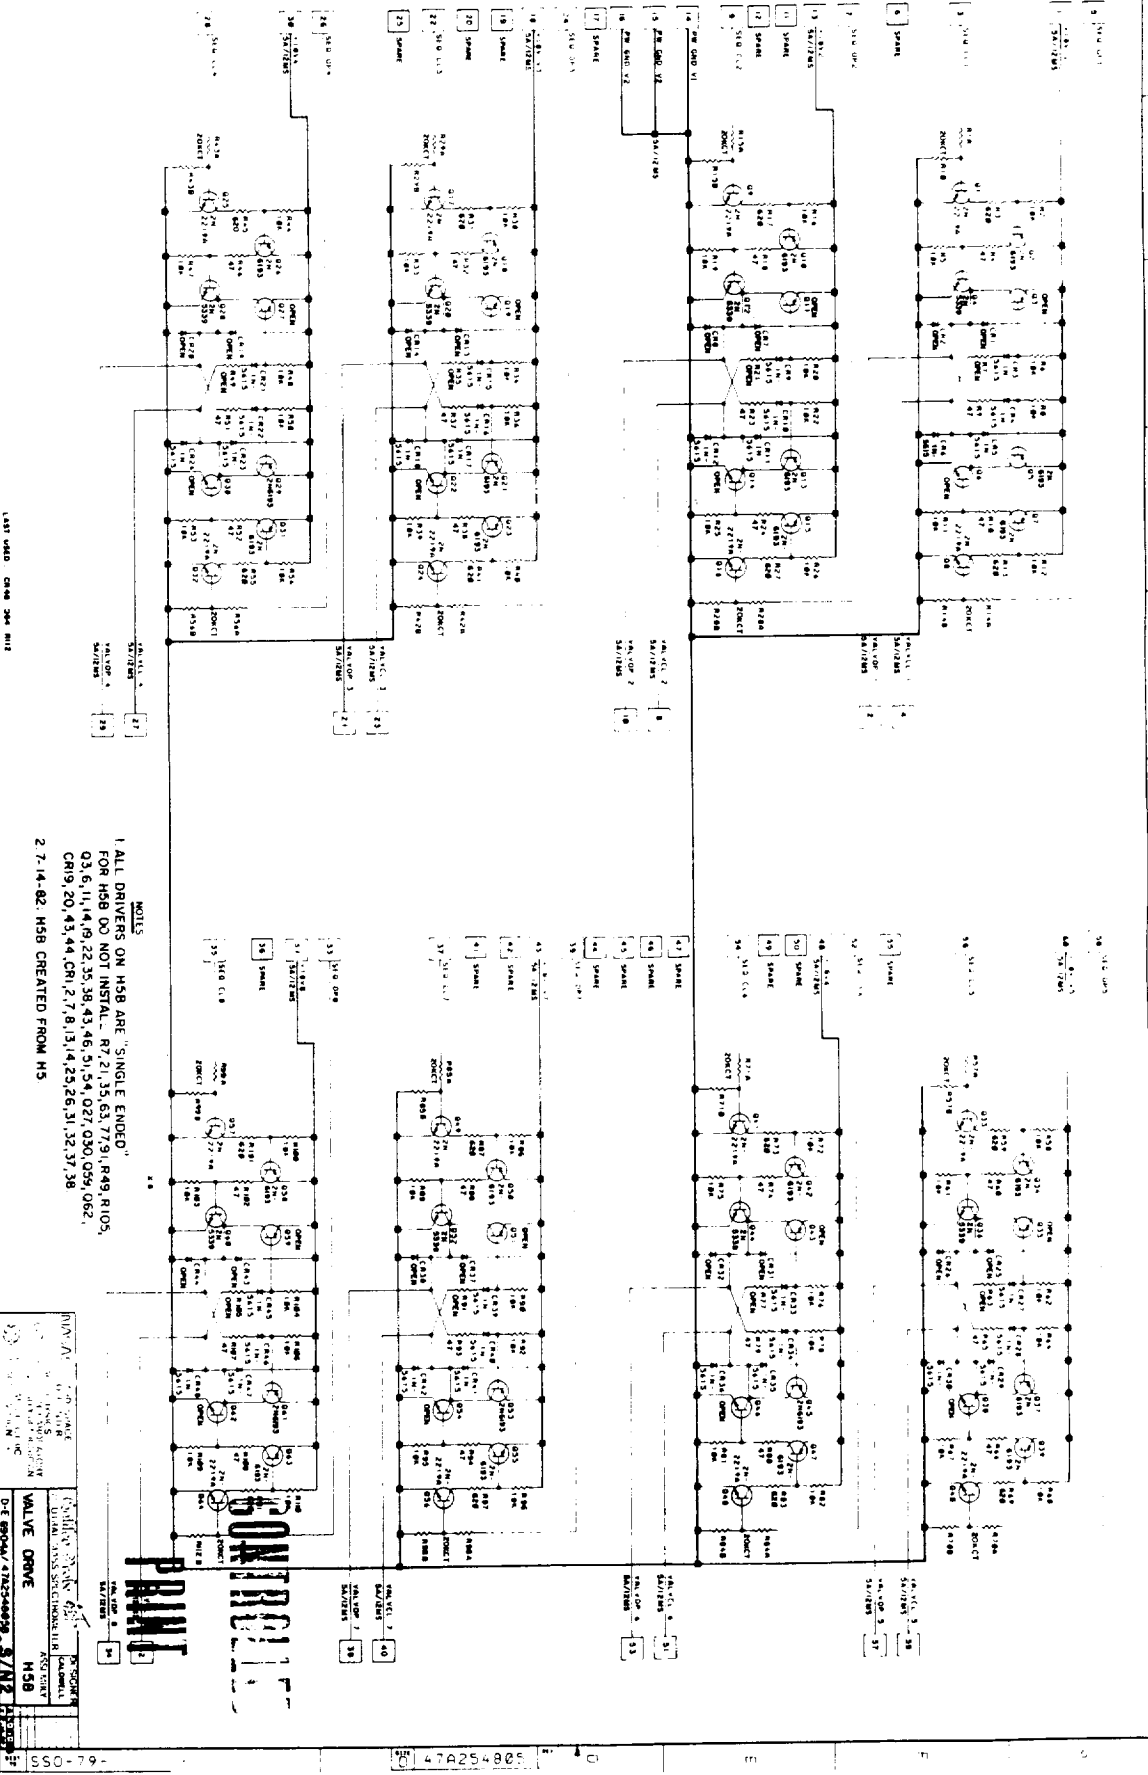

NOTES
1. ALL DRIVERS ON HSB ARE "SINGLE ENDED"
FOR HSB DO NOT INSTALL - R7, 21, 35, 63, 79, 91, 99, 105,
Q3, 6, 11, 14, 19, 22, 35, 38, 43, 46, 51, 54, 62, 7, 10, 105, 106,
C19, 20, 43, 44, C19, 27, 8, 13, 14, 25, 26, 31, 32, 37, 38
2. 7-14-82 HSB CREATED FROM H5

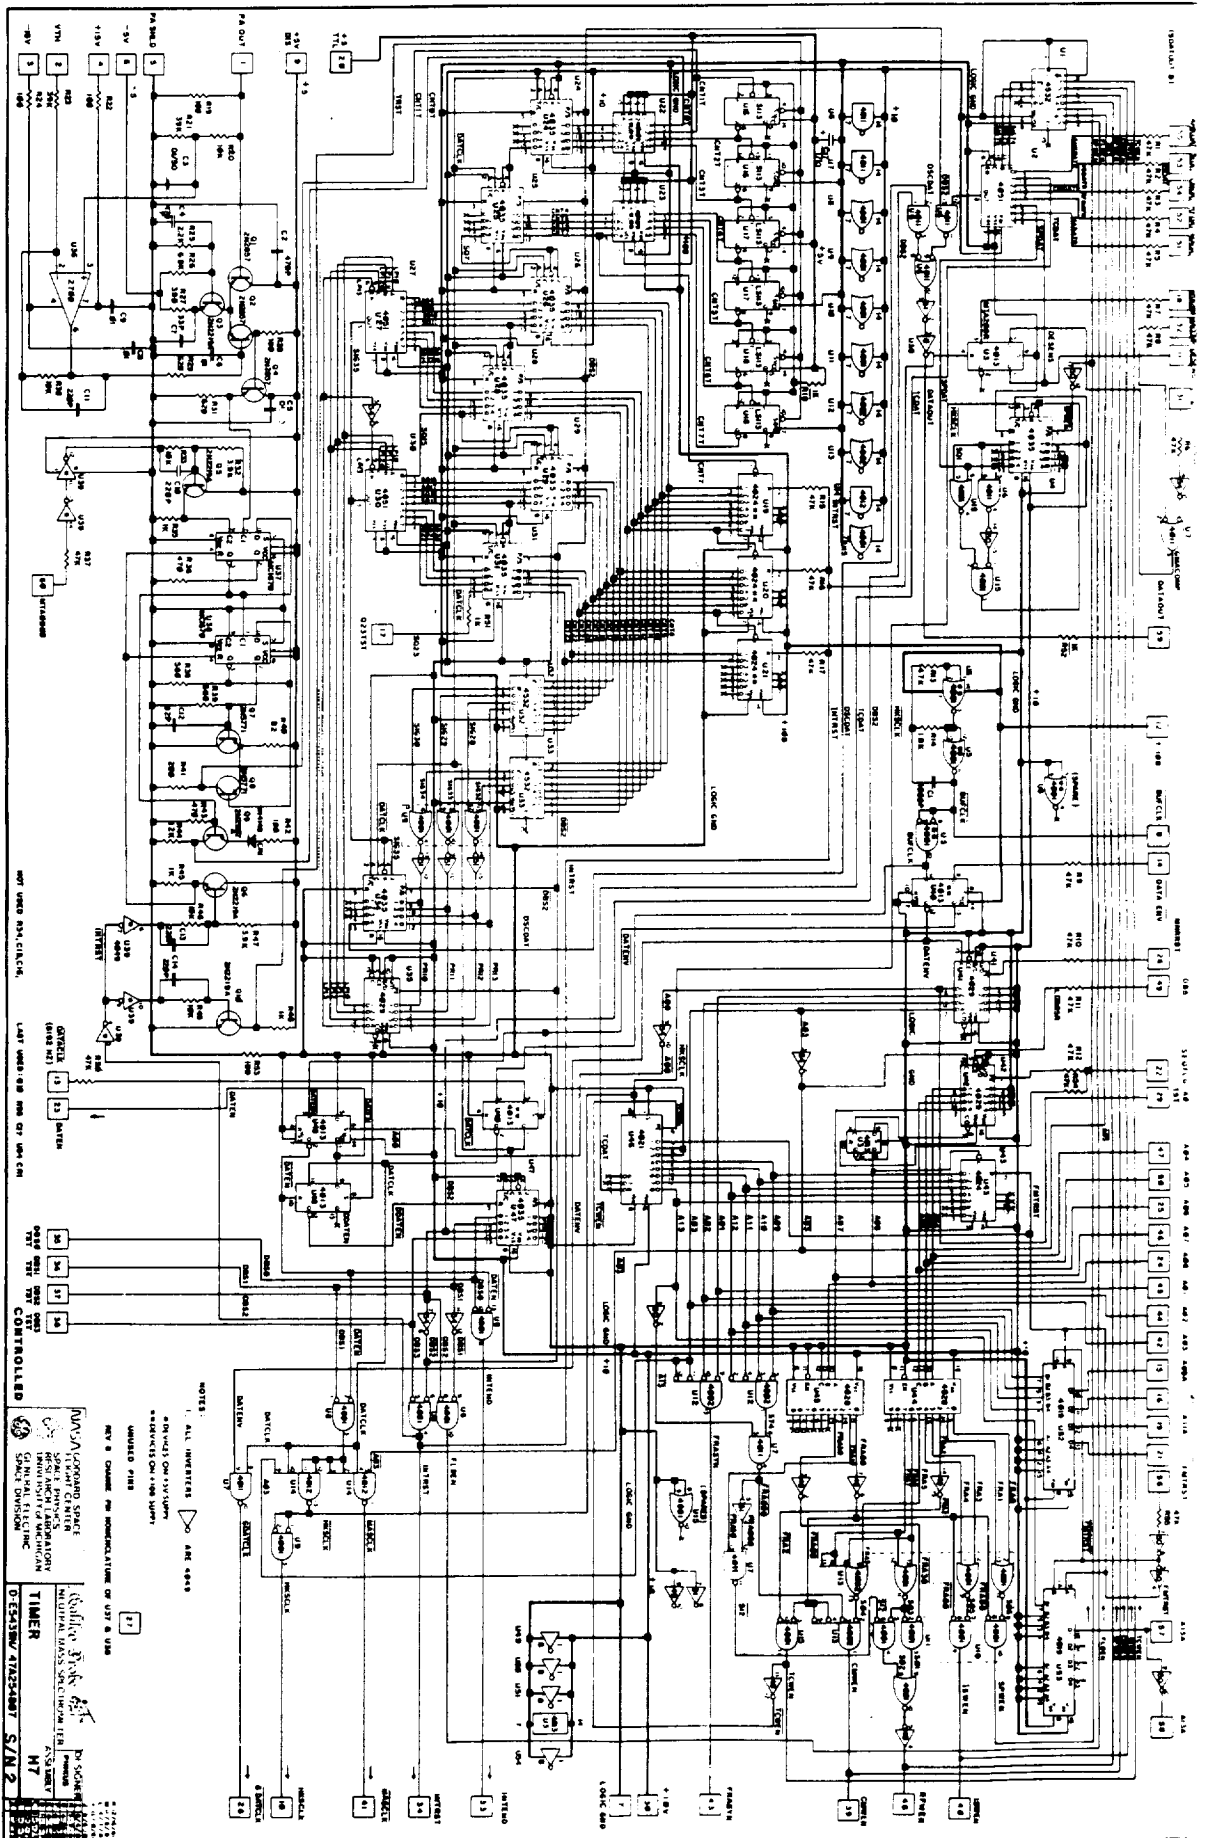



CONTROLLED

S/N 2

159

